


COCHRAN PATENT VERTICAL MULTITUBULAR BOILER.

HORIZONTAL FLUE TUBES.

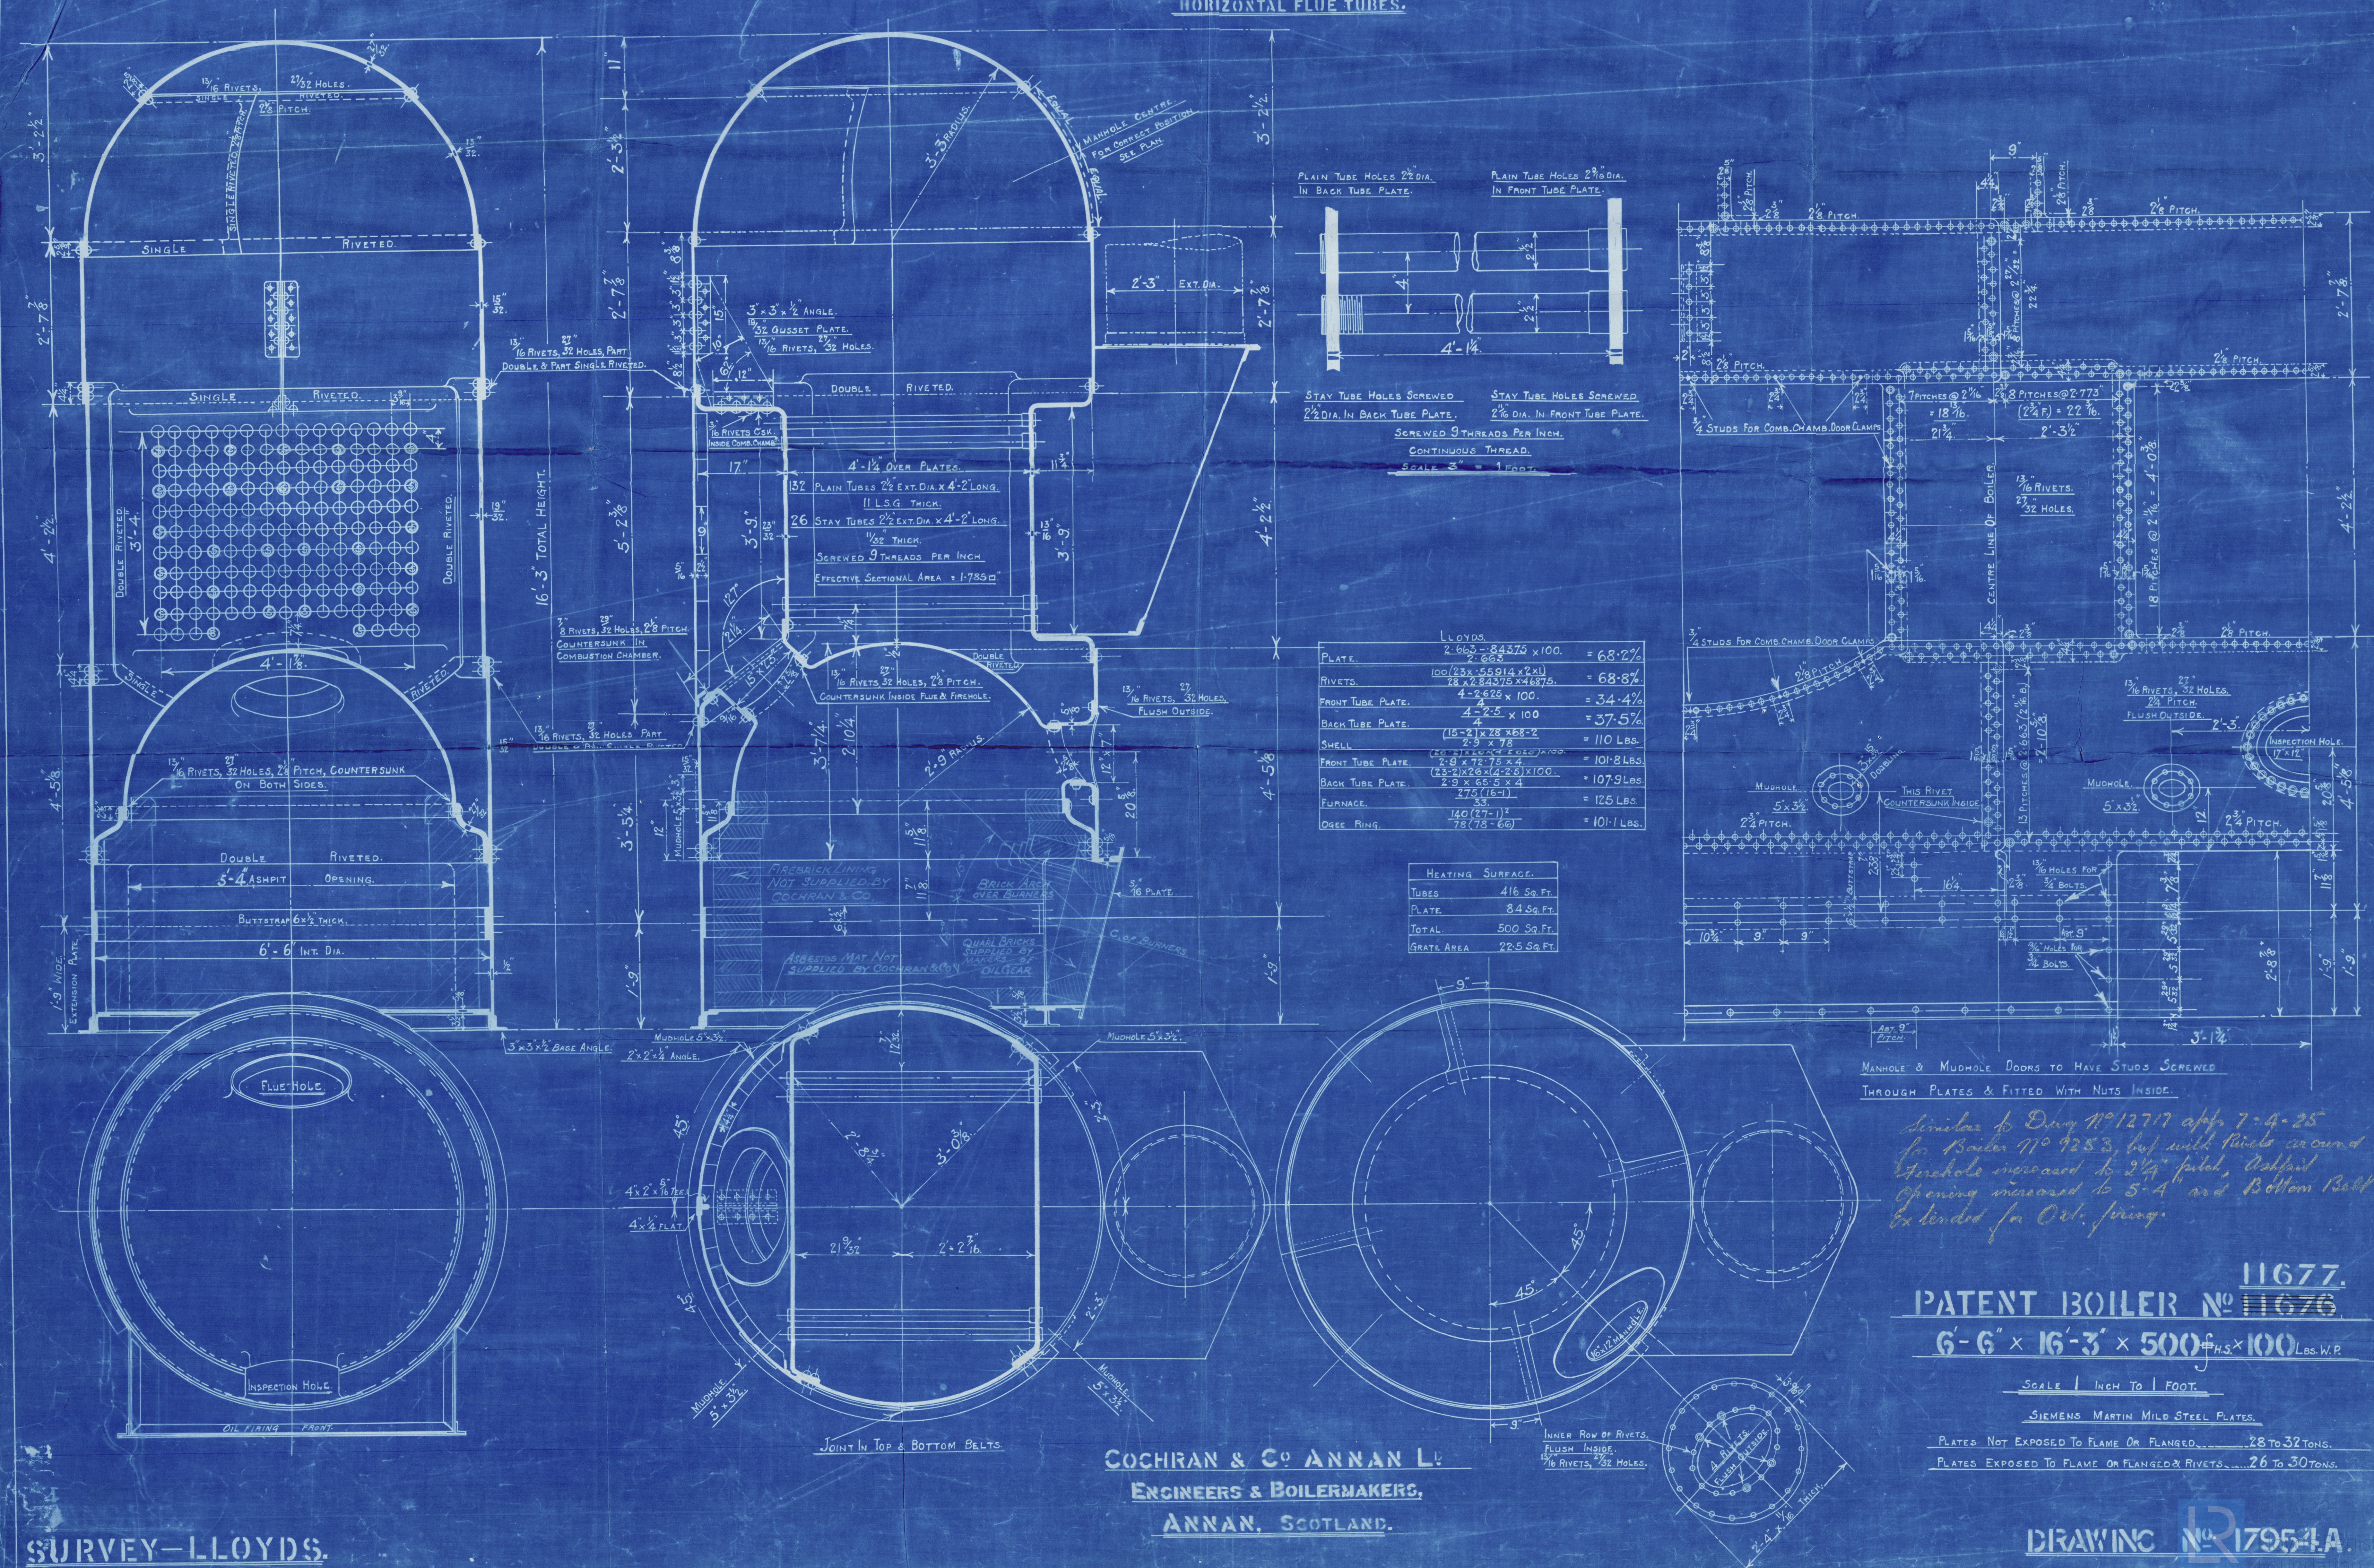

PATENT BOILER NO. 11677
11676
6'-6" x 16'-3" x 500# H.S. x 100 LBS. W.P.

SCALE 1 INCH TO 1 FOOT

SIEMENS MARTIN MILD STEEL PLATES

PLATES NOT EXPOSED TO FLAME OR FLANGED.....28 TO 32 TON
PLATES EXPOSED TO FLAME OR FLANGED & RIVETS.....26 TO 30 TON

DRAWING NO. 17954A

W1153-0220

RETAIN

COCHRAN & CO., ANNAN, LD.


Bailer No. 11677

Drawing No. 17954 A.

W. P. 100 lbs

W1153-0220

GLASGOW REPORT No. 50671

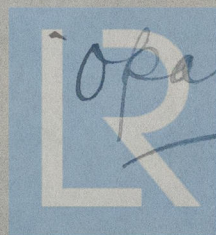

Opawa

© 2020

GL 51471

Lloyd's Register
Foundation