




36446

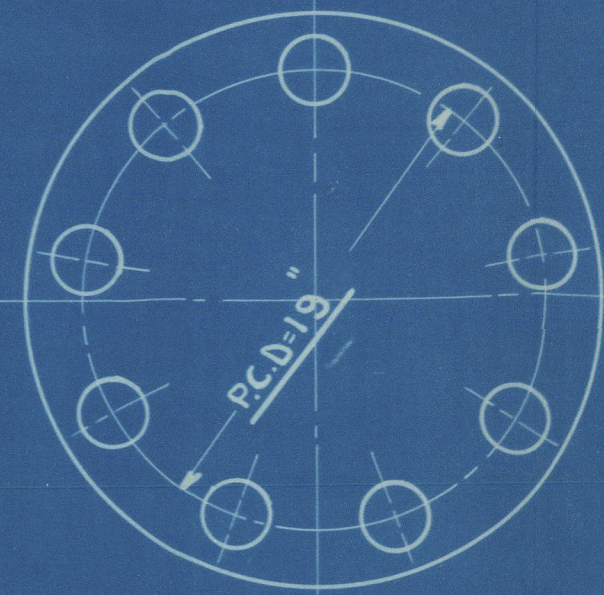


9 OFF 72¹³ BOLTS.

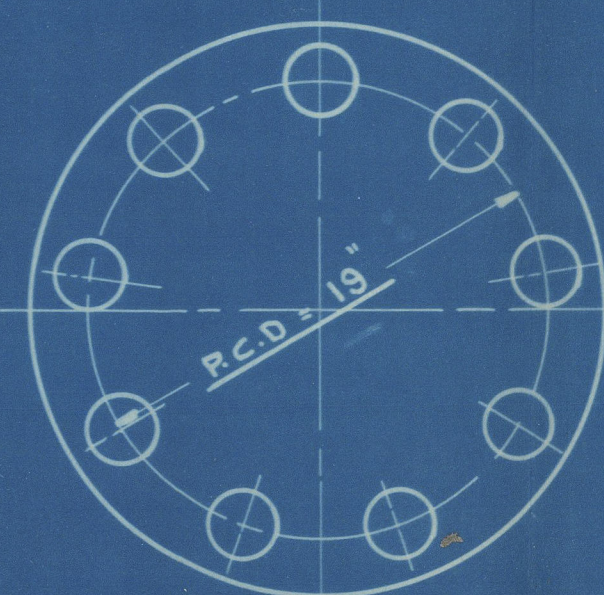


9 OFF 72¹³ BOLTS.

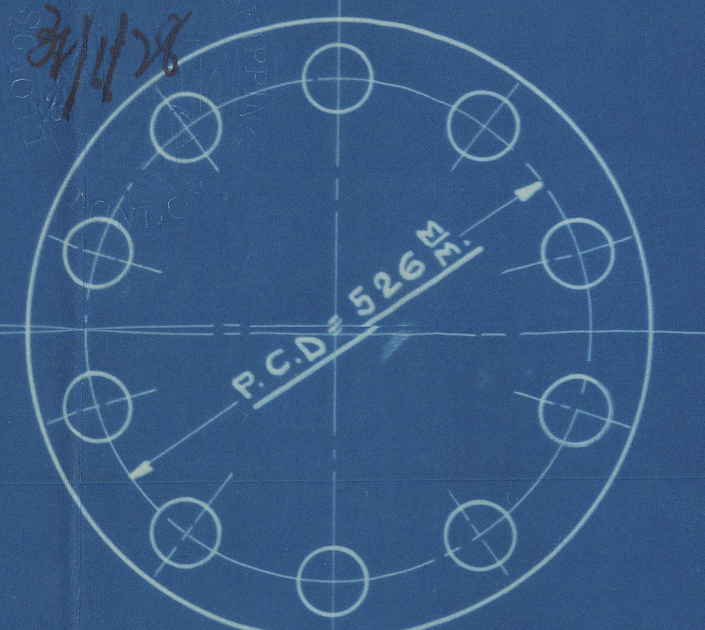


10 OFF 72¹³ BOLTS.

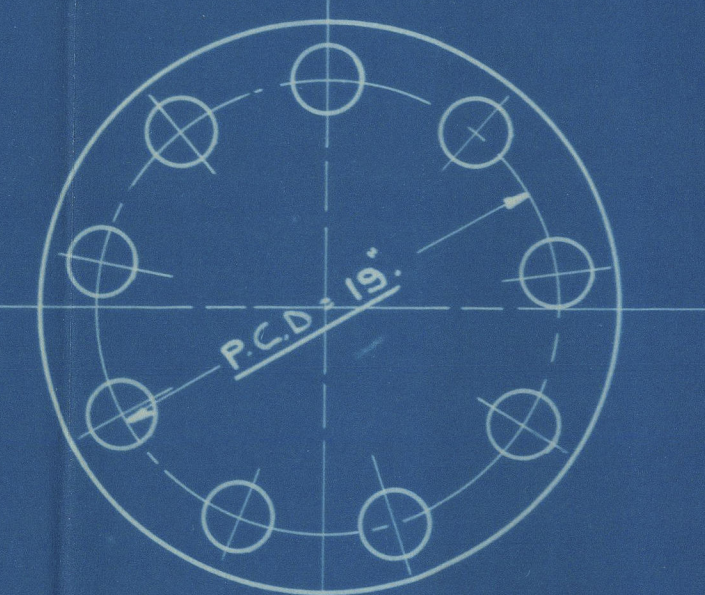

9 OFF 72¹³ BOLTS.

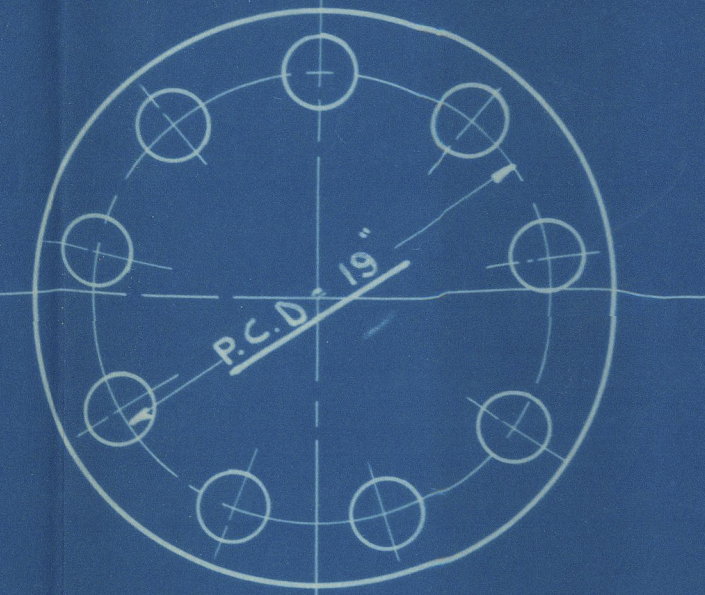

9 OFF 72¹³ BOLTS.

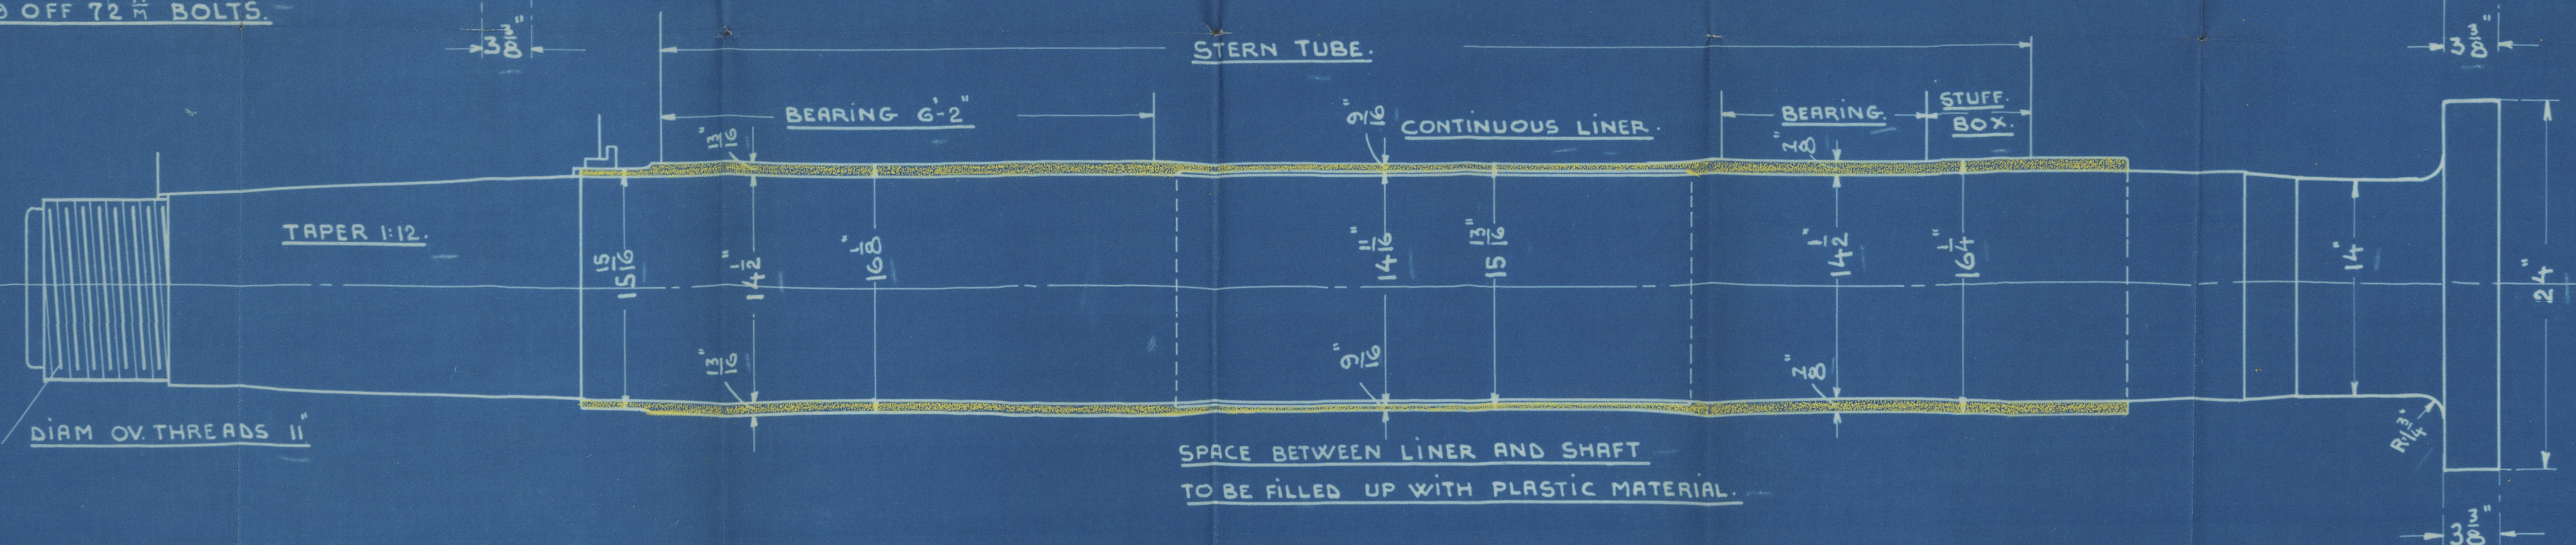

SHAFTS FOR YARD N° 549.

6 CYLINDER FOUR STROKE DIESELENGINE.

CYLINDER DIAM 590^M = 23¹/₄"

DIAM. OF PROPELLER = 12'-6"

STROKE 1100^M = 43⁵/₁₆"


ROTATING BALANCE WEIGHT AT CRANK SHAFT = 18400 KG.M².

REVS. PR. MIN = 145.

" " " TURNING WHEEL = 1700 " "

G = ROTATING WEIGHTS. D = GYRATIONS. DIAM.

TOTAL G.D² = 20100 " "

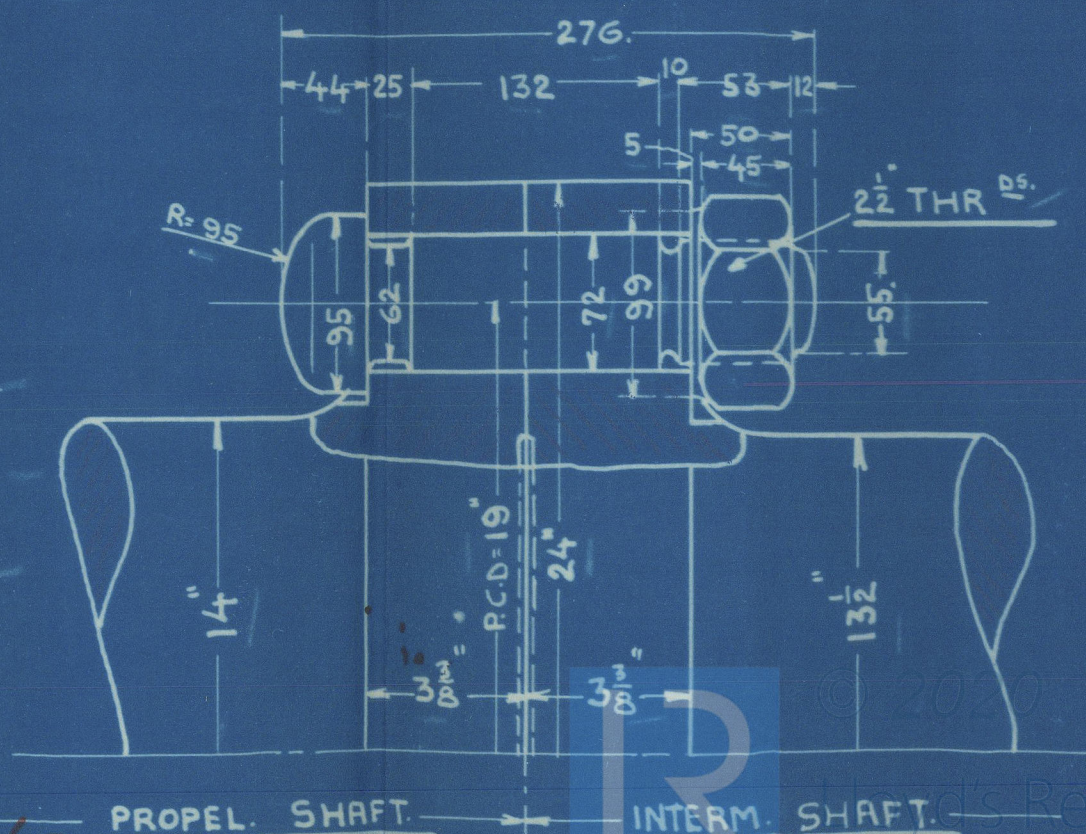

AKTIESELSKABET
BURMEISTER & WAIN MASKIN- OG SKIBSBYGGERI
19-1-1928

AKTIESELSKABET
BURMEISTER & WAIN
MASKIN & SKIBSBYGGERI

11-1 1928 N° 36446.

30/1/28


W155-0014

Amended plan of
THRUST, INTERMEDIATE
AND SCREW SHAFTS

for the Twin Screw Motor Tank Vessel

Hord N^o 549

being built by
Akt. Burmeister & Wain's
Maskin og Skibsbyggeri.
Copenhagen.

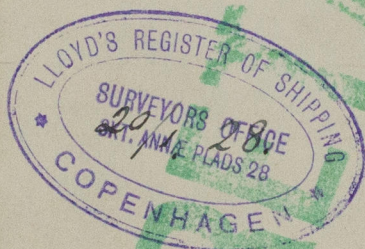

M/s "SANDAR" of Sandefjord

Copenhagen Report N^o 7854.



© 2020

Lloyd's Register
Foundation

W1155-0014