

CRANK SHAFT FOR YARD N° 549

6 CYLINDER FOUR CYCLE ENGINE

CYL. DIAM. 590 $\frac{M}{M}$ - STROKE 1100 $\frac{M}{M}$

THIS DRAWING AND THE DESIGN SHOWN THEREIN, IS THE PROPERTY OF BURMEISTER & WAIN LIMITED, AND IS ONLY ALLOWED TO BE USED BY EXPRESS PERMISSION AND LICENSE FROM BURMEISTER & WAIN LIMITED COPENHAGEN

AKTIESELSKABET
BURMEISTER & WAIN MASKIN- OG SKIBSBYGGERI
d. 24-2-1928


S. Lohner



© 2020
Lloyd's Register
Foundation

Plan of
CRANK SHAFT of the
Main Diesel Oil Engines
for the Twin Screw Motor Tank Vessel
Yard N^o 549
being built by

AKTIESELSKABET
BURMEISTER & WAIN'S MASKIN- OG SÆBSEVOGERI
Copenhagen.

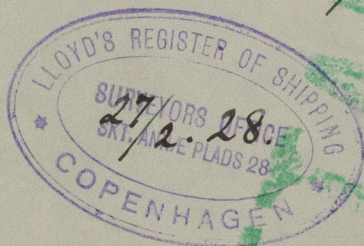

M/S "SANDAR" of Sandefjord
Copenhagen Report N^o 7854.



© 2020

Lloyd's Register
Foundation

W1155-0015