

DIMENSIONER		
LÆNGDE	EFTER REGLERNE	450' - 0" -
BREDDER	" " " "	59' - 0" -
DYBDE	" " " "	34' - 0" -

AKTIESELSKABET
BURMEISTER & WAIN'S
MASKIN- & SÆBBERYGBERI.

BYGNING NR. 549
TEGNING NR. K. 3357.
TEGNET AF *M*
KALKULES AF *L*
EJEREN NR.
DATO 18-7-23
SÅLA $\frac{1}{2}$ = 140
M. Burmeister


Motor Launch "SANDAR"

- Midship Section.

- as Built -

Messrs Burmeister & Wain.

No 549

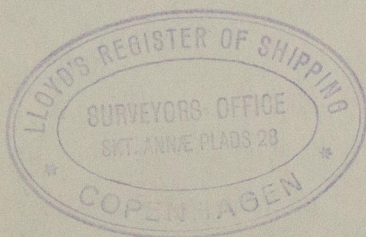

Cypr. Rpt. No. 7857.



© 2020

Lloyd's Register
Foundation

W1155-0017