


# T.S.M.S. „SANDAR.“ PROFILE.

SKALA :  $\frac{1}{8}'' = 1'-0''$

## DIMENSIONS:

LENGTH BETW. PP.	450'-0"
BREADTH MOULD.	59'-0"
DEPTH MOULD.	34'-0"

 

THIS DRAWING IS STRICTLY CONFIDENTIAL  
AND MUST ON NO ACCOUNT BE COPIED OR  
DISCLOSED FOR ANY THIRD PERSON.  
COPENHAGEN, DENMARK.

AKTIESELSKABET  
BURMEISTER & WAINES MASKIN- OG SKIBBYGGERI  
COPENHAGEN, DENMARK.  
BUILT FOR THE T.S.M.S. „SANDAR.“  
TOWING NO. 147  
DESIGNED BY  
DRAWN BY  
DATE 30-11-28  
SCALE 1/8" = 1'-0"  
PROFILE



Motor Tanker. "SANDAR"


---

Profile & Decks -  
as built -

Messrs Burmeister & Wain.

No 549.

---

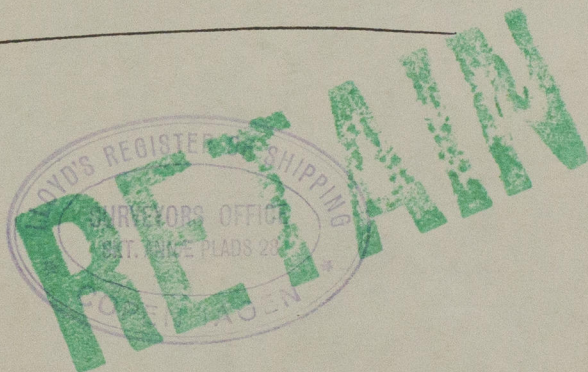

Gen. Rpt. No. 2854.

RETAIN



© 2020

Lloyd's Register  
Foundation