


ISHERWOOD SYSTEM PATENT








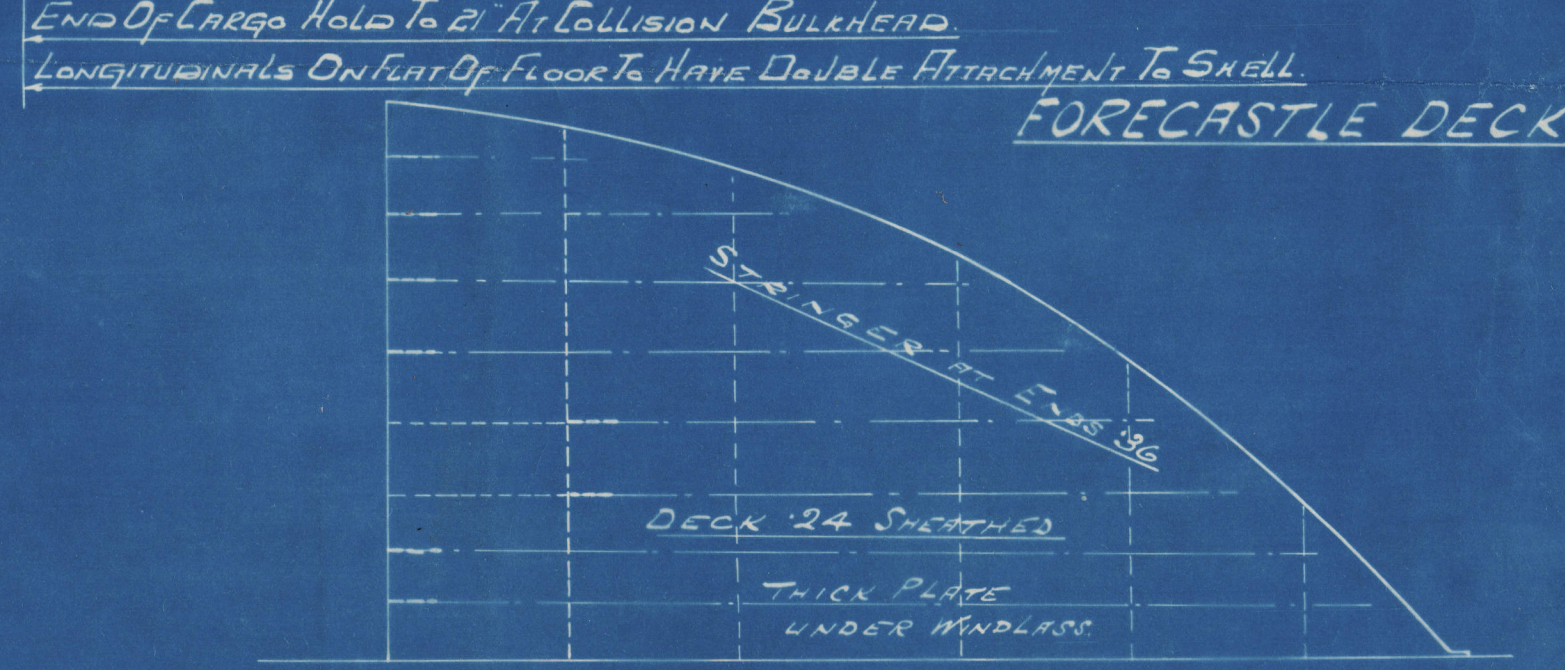


NOTE:- WHERE TRANSVERSES & BULKHEADS ARE INCREASED IN LENGTH DUE TO SHEER, THE PARALLEL LENGTH SHOWN ON MIDSHIP SECTION TO BE MAINTAINED OR ALTERNATELY THE TRANSVERSES & BULKHEADS TO BE INCREASED IN DEPTH OR OTHER MEANS TAKEN FOR PROVIDING EQUIVALENT STRENGTH


Calm Prof x

Palmer's S.B. Co.
S.S. Nos. 830 & 831

Profile & Deck plan.

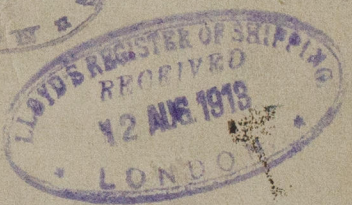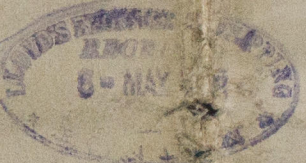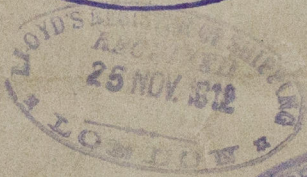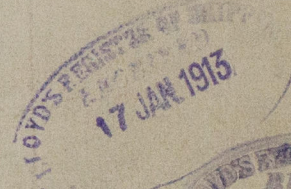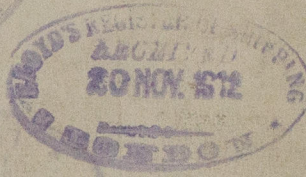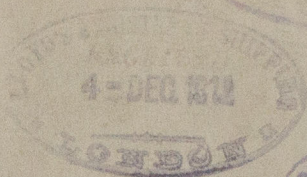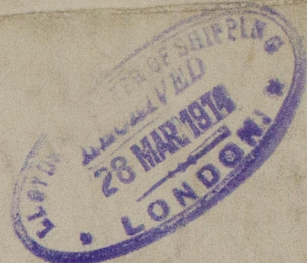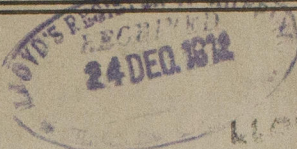

(2)

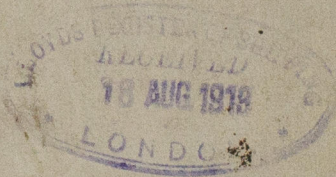


S.S. SAN VALERIO

9.4
4.5
13 9

NEWCASTLE-ON-TYNE.

Report no 65301

18.40
77
7.63

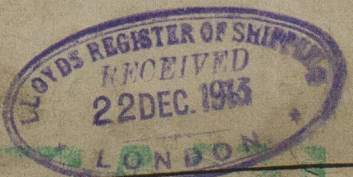

S.S. SAN ZEFERINO
NEWCASTLE-ON-TYNE.

Report no 65782

© 2020

Lloyd's Register
Foundation