


After Peak Framing  
Trainers 7" x 3/4" 40' long  
Kerens Bar 3" x 3/4" 40' long  
Transverse 40'

After Peak Bld Plating 40' x 30' (Plate at Sluffing Box 32')  
Vertical Stiffeners 10" x 3/4" 40' long  
Bulb Angle 30' apart  
Bulb Angle 30' apart  
Plan of Bulkhead to be submitted

Transverses and Intertransverses connected to shell to height of lower Deck with double 6" x 6" 44' angles

Fore Peak Bld Plating 40' x 30'  
Vertical Stiffeners lower 10" x 3/4" 40' long  
middle 7" x 3/4" 40' long  
upper 4" x 3/4" 40' long  
Bulb Angle 30' apart  
Plan of Bulkhead to be submitted

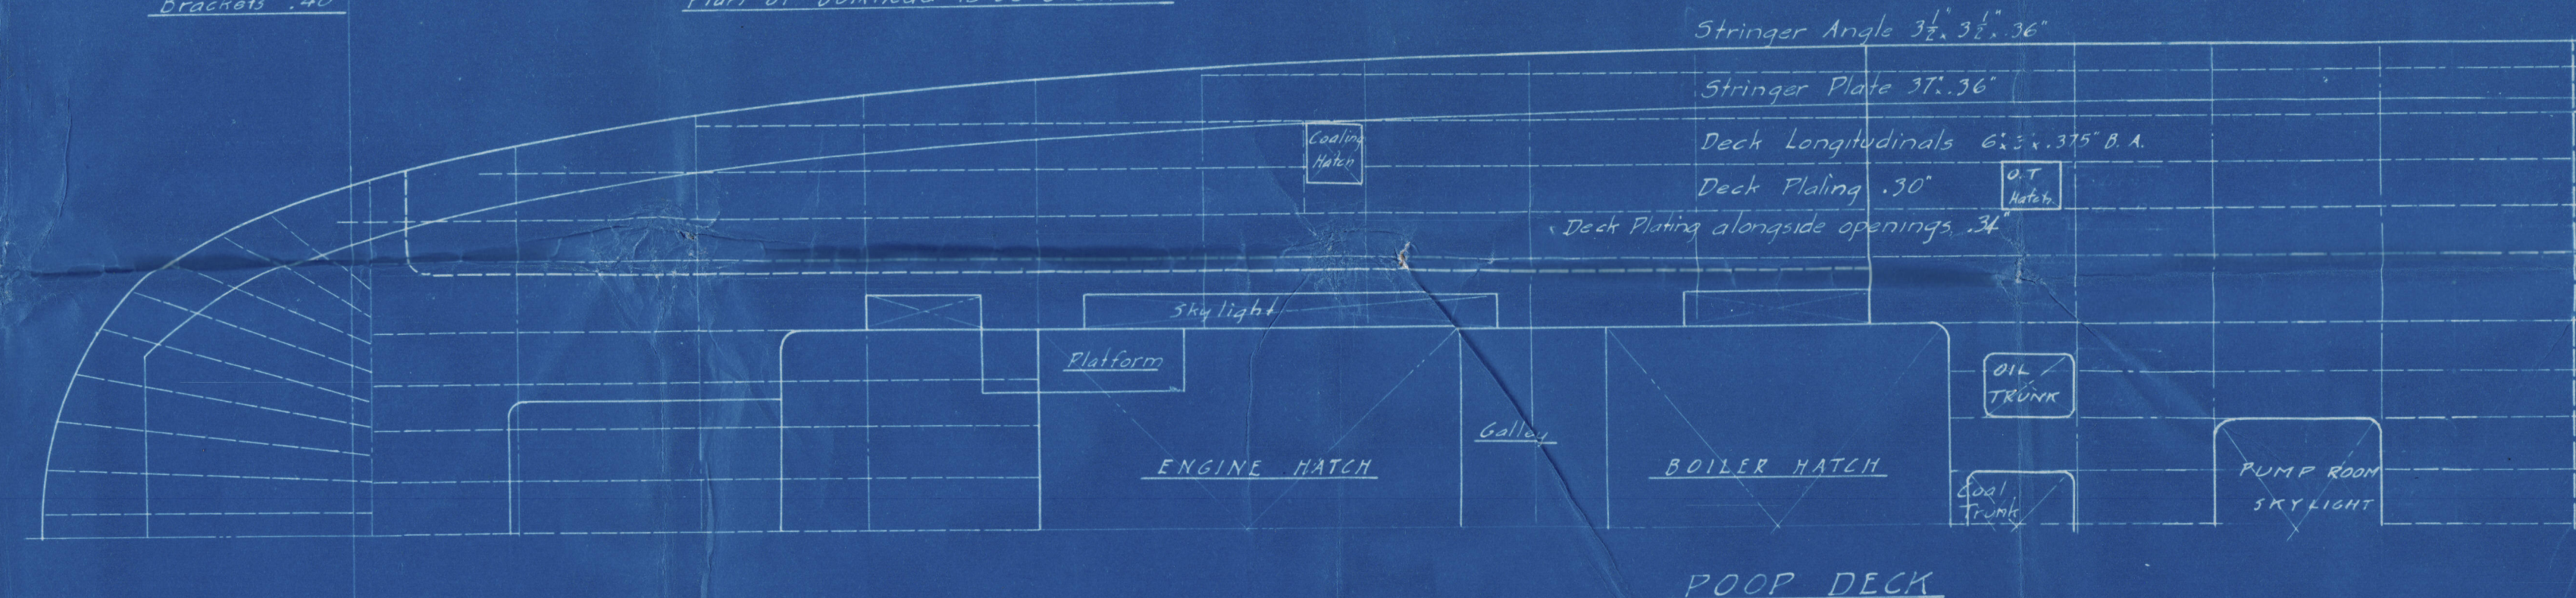













 


 




UNION IRON WORKS CO.  
SHIPBUILDERS AND ENGINEERS  
SAN FRANCISCO, CALIF.  
LULL DEPT.  
LLOYD'S PROFILE AND DECK PLANS  
SCALE: 1" = 10'  
DATE: Jan. 9, 1918  
SHEET No. 54010  
CHECKED BY: [Signature]  
1720



MR. H.P. Mc NAB.



© 2020

Lloyd's Register  
Foundation



Profile & deck plans.  
of ship as built

The "Bethlehem S. Co."  
"Ponta Verde"  
No 143. J. E. O'Neil.

S. To rpt. No. 2641



© 2020

Lloyd's Register  
Foundation

W1155-0158