

Copy. Approved.

J. Mitchell.

JAN 15 1916
NEW YORK

MARYLAND STEEL COMPANY.	
MARINE DEPARTMENT, SPARKS POINT, MD.	
SPANISH - AMERICAN ORE STRG. # 160-161	
— MIDSHIP SECTION. —	
SCALE $\frac{1}{8}$ " = 1 FT.	DATE. 12. 24. 15
DRAWN BY: <i>J.E.L.</i>	APPROVED.
TRACED BY: <i>J.E.L.</i>	CHIEF ENGINEER
CHECKED BY: <input checked="" type="checkbox"/>	NAVAL ARCHITECT.
APPROVED.	CHIEF ENGINEER.

Hulls N^o 160-1-165-6

Midship Section

Zethlehem Steel Coy

One Steamship Corp

S.S. Cubore

S.S. Feltore

S.S. Sautore


S.S. Firmore

Baltimore Report N^o 2176

0° 0° 2211

0° 0° 2318

0° 0° 2394

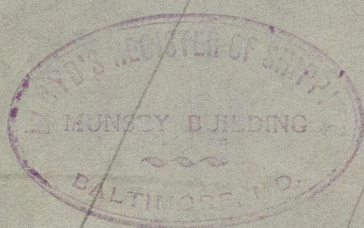

Wreck Section 113

RETAIN

© 2020

W1156 - 0022