

For the information of Surveyors and the Committee only.

Received at

Office

19

Lloyd's Register of Shipping.

(Report on Vessel No. 104340 Port Liverpool)

O.F. 5356

SHIP FORGINGS OR CASTINGS.

I have to report that the undermentioned Iron or Steel Forgings or Castings, manufactured by Sunderland Forge & Inyl. of Sunderland for the Vessel No. _____, being built by SS Southern Princess of _____ have been inspected by me as set forth below and found to be, so far as can be seen, Sound.


Forgings or Castings.

Lloyd's
No. 7305
D. 8.5.34

J Dale
Sunderland

| | STERN FRAME. | RUDDER FRAME. | STEM. |
|------------------------------------------------|-------------------------------------|---------------|-------|
| Material | <u>Scrap iron</u> | | |
| Grade | <u>Forged & Smithed.</u> | | |
| Dimensions | <u>10 1/2 x 11 - 11 1/2 x 9 1/2</u> | | |
| Inspection | <u>Forging & Smithing.</u> | | |
| When Inspected | <u>8.5.34</u> | | |
| CASTINGS. | | | |
| on Standard Test Pieces. | | | |
| Test— | | | |
| per square inch | | | |
| Extension per cent. | | | |
| ending Test— | | | |
| Time before fracture | | | |
| Test— | | | |
| Weight from ground | | | |
| Weighting Test— | | | |
| Made according to Rules and found satisfactory | | | |

SKETCHES OF FRAMES SHOWING POSITION AND DESCRIPTION OF WELDS OF FORGINGS.

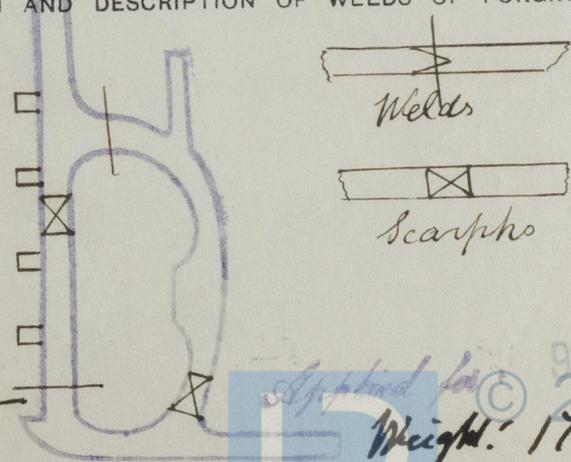


Fee (if any chargeable) £ 8 : 8 : -
To be paid at SUNDERLAND

Applied for 9 MAY 1934
Weight: 17 tons.

If of Iron, state whether scrap or puddled Iron. If of Steel, state whether made on the Open Hearth process.

S. T.

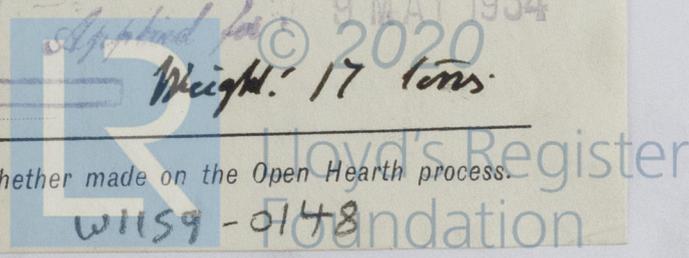

Lloyd's Register of Shipping.

SHIP FORGINGS OR CASTINGS.

"Southern Princess"
 LIVERPOOL.
 Report No. 104340

STEP FRAME.

RUDDER FRAME.

STEM.





SKETCHES OF FRAMES SHOWING POSITION AND DESCRIPTION OF WELDS OR FORGINGS.



For the information of Surveyors and the Committee only.

Registered at

Liverpool

To be made up

If of steel, state whether made on the Open Hearth process

