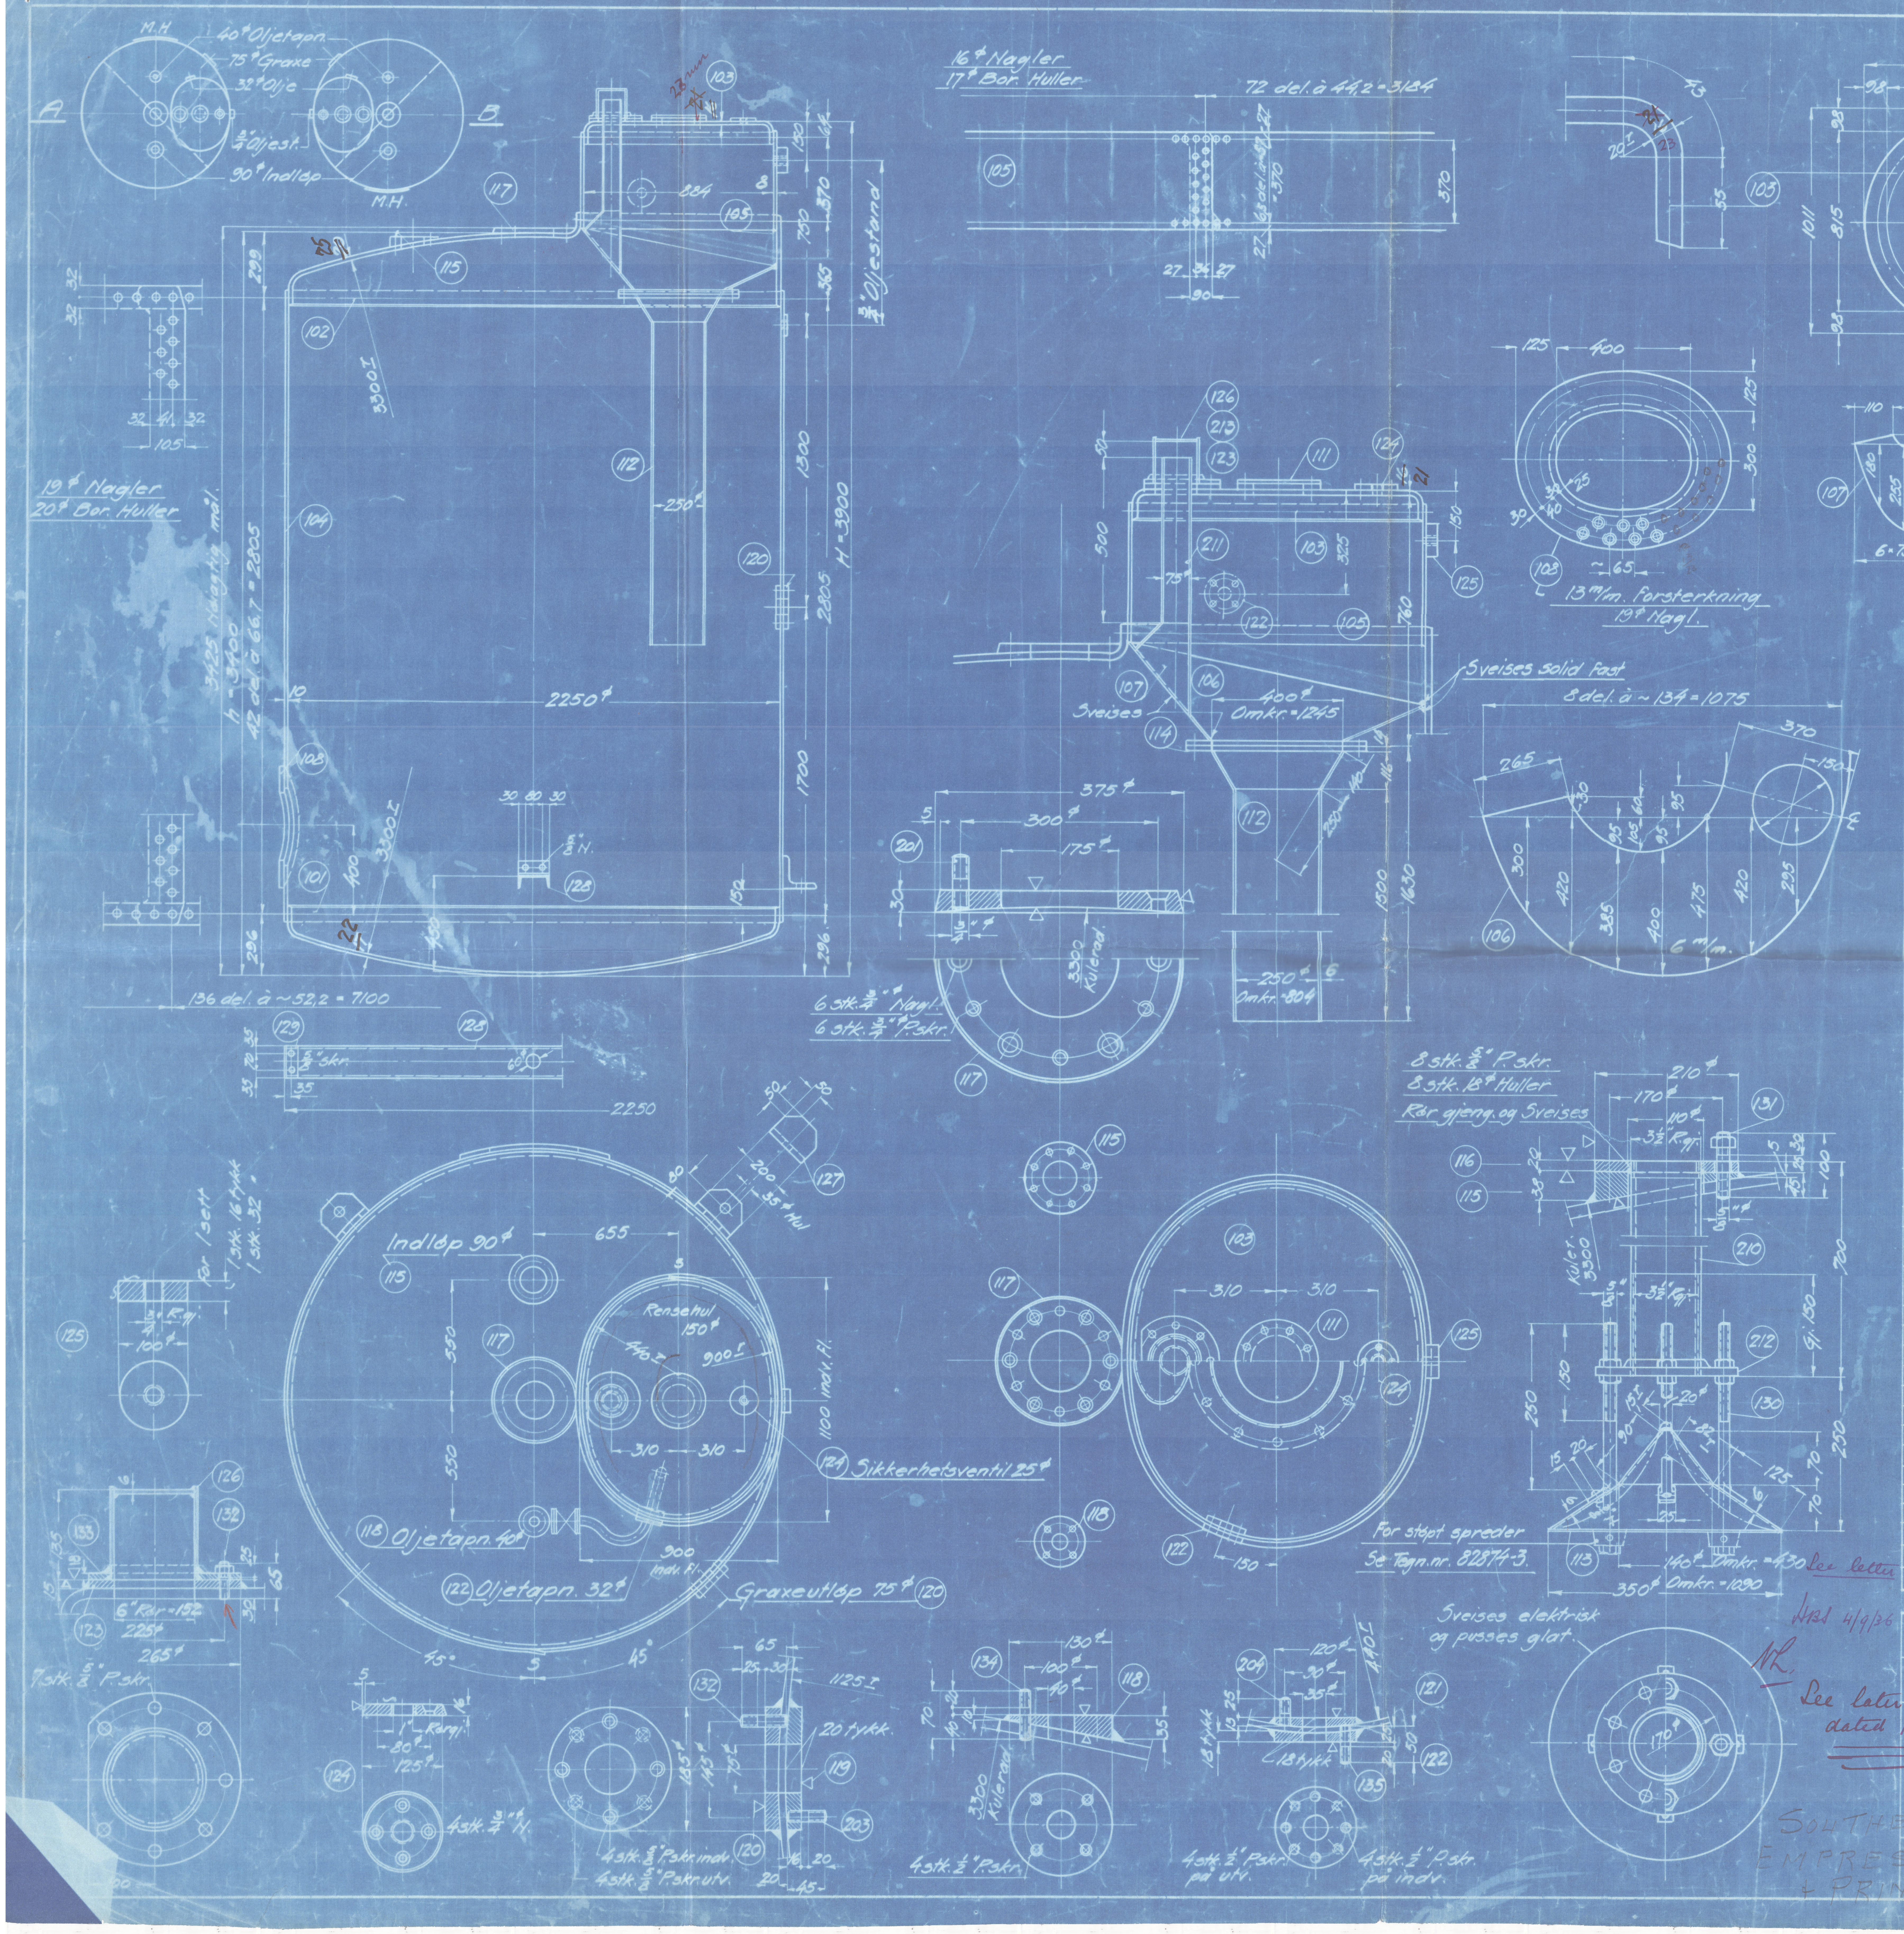

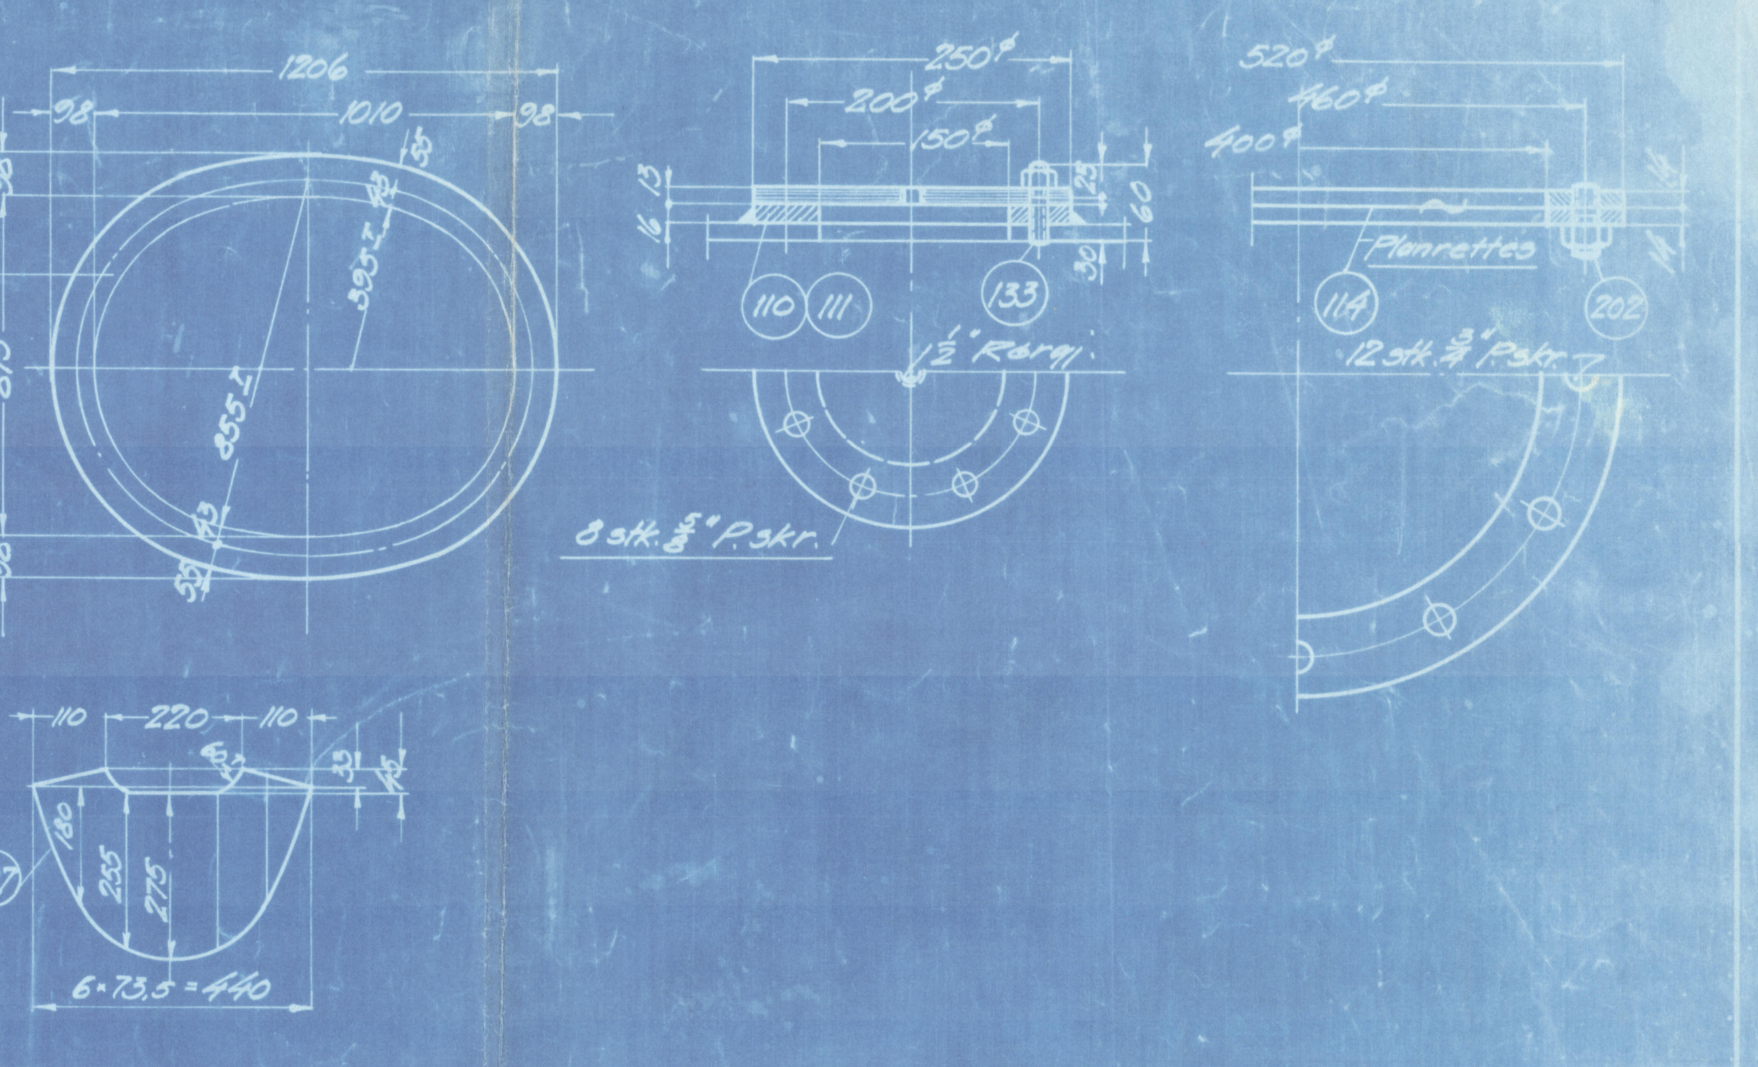

						Gjenstand	Nr.	Materiale	Anmerkning
15	10	25	5	4	1	Backnut 3½"	214		
		25	5	4	1	Flenser, røde 6"	213		ϕ avdreies
15	10	25	5	4	1	Flenser, røde 3½"	212		
15	10	25	5	4	1	Rør, røde 3" × 500	211		
15	10	25	5	4	1	Rør, røde 3½" × 700	210		
60	40	100	20	16	4	Halvbl. 6 k. mutter ⅝" N.S.26	209		
60	40	100	20	16	4	S. 6 k. skrue ⅝" × 30 N.S.34	208		For pos. 128
180	120	300	60	48	12	Halvbl. 6 k. mutter ½" N.S.26	207		
585	390	975	195	156	39	" " " ⅝" N.S.26	206		
270	180	450	90	72	18	Halvbl. 6 k. mutter ¾" N.S.26	205		
60	40	100	20	16	4	Pinneskruer ½" × 25 N.S.77	204		
60	40	100	20	16	4	" ⅝" × 30 N.S.77	203		
180	120	300	60	48	12	" ¾" × 35 N.S.77	202		
90	60	150	30	24	6	Pinneskruer ¾" × 50 N.S.77	201		
60	40	100	20	16	4	Pinneskruer ½" × 50	135		
60	40	100	20	16	4	Pinneskruer ½" × 70	134		
15	10	375	75	60	15	Flenser	133		
[illegible]	[illegible]	[illegible]	20	16	4	Pinneskruer ⅝" × 65	132		
120	80	200	40	32	8	Pinneskruer ⅝" × 100	131		
		20	20	16	4	Stabel ⅝"ϕ	130		
30	20	50	10	8	2	L jern 65 × 65 × 7 × 140	129		
15	10	25	5	4	1	L jern Nr. 14 × 2240	128		
60	40	100	20	16	4	Støttelabb 6" × 6" × 1" ∠	127		
15	10	25	5	4	1	Lufthatt 6"ϕ Røde rør	126		
15	10	25	5	4	1	Set Flenser 100-¾" R.gj.	125		: 1 stk. 16 - 1 stk. 32 m/m
15	10	25	5	4	1	" 125-1" r.gj. × 16	124		
15	10	25	5	4	1	" 265-152ϕ × 16	123		
15	10	25	5	4	1	" 120-35ϕ × 20	122		
15	10	25	5	4	1	" 120-35ϕ × 20	121		
15	10	25	5	4	1	" 185-75ϕ × 22	120		
15	10	25	5	4	1	" 185-75ϕ × 22	119		
15	10	25	5	4	1	" 130-40ϕ × 38	118		
15	10	25	5	4	1	" 375-175ϕ × 32	117		
15	10	25	5	4	1	" 210-3½" × 22	116		
15	10	25	5	4	1	Flenser 210-116ϕ × 38	115		
30	20	50	10	8	2	Flenser 520-400ϕ × 14	114		
		5	5	4	1	Kon. Skjermer -6-	113		
15	10	25	5	4	1	Rør med kon. 250ϕ × 6	112		
15	10	25	5	4	1	Håndlokk 250ϕ × 13	111		
15	10	25	5	4	1	Håndlokkring 250/150 × 16	110		
15	10	25	5	4	1	Mandlokk, komplet	109		Stand. tegn.
15	10	25	5	4	1	Mandlokkring -13-	108		
15	10	25	5	4	1	Platekonus -6-	107		
15	10	25	5	4	1	Platekonus -6-	106		
15	10	25	5	4	1	Skallplate -8-	105		
15	10	25	5	4	1	Skallplate 7205 × 2870 × 10	104		
15	10	25	5	4	1	Planbund, Ellipt. 23 ~~21~~	103		
15	10	25	5	4	1	Normalbund 2250ϕ × 25	102		
15	10	25	5	4	1	Normalbund 2250ϕ × 22	101	S.m.S.	

Stykktallial | Gjenstand | Nr. | Materiale | Tegn. nr. | Modell nr. | Vekt | Anmerkning

Ordre nr.	Bestiller	Lev. tid / Utsendt
9525	Kværner Brug	2.4.36
9500	Kværner Brug	16.3.36
[illegible]	Reserve	
9260	Kværner Brug	13.3.35
9195	Kværner Brug	27/12.34 · 1.3.35
9195	Melsom & Melsom	3.1.35 · 22.1.34

Forandringer: Datum 16/3-36 — Flens, pos. 213, forandres til pos. 133, som utføres av 20 m/m pl.

S.S. Southern Princess
Nwc. rept. No. 94322

See letter
HBS 4/9/36
NL
See later endorsement dated 18/9/36

SOUTHERN EMPRESS + PRINCESS

RETAIN

Roterende Hvalkokeapparat
Type 19 —— Type 29
2250ϕ-Oljeutskiller 80 t/d

Målestokk 1:15 1:10 1:5
Tegn. 8.11.34
Trac.
Ktr.
Erstatning for Gammel tegning
Erstattet av

A/S KVÆRNER BRUG OSLO

INDLÆG № 250

© 2020 Lloyd's Register Foundation

76038 I

W1159-0171