

NEWELL STANDARD LIMITS TO BE USED

NO OF PER ENGINE	DESCRIPTION	PATTERN NUMBER	MATERIAL	WT IN KGS	REMARKS	SHOP	SK NO OF JIG
1	LEFT-HAND CRANKSHAFT (FOR PART)	132200	SIEMENS-MARTIN STEEL	43071	MADE FROM PARTS AS ORDERED		
1	RIGHT HAND (FOR PART)	132201	SIEMENS-MARTIN STEEL	43071			
1	CRANKWEB	130472	SIEMENS-MARTIN STEEL	43543			
1	CRANK PIN	130462	SIEMENS-MARTIN STEEL	43071			
1	CRANK JOURNAL	130463	SIEMENS-MARTIN STEEL	43071			
1	COUPLING END (AFT)	130464	SIEMENS-MARTIN STEEL	43071			
1	CRANK JOURNAL (FOR)	130465	SIEMENS-MARTIN STEEL	43071			
1	CRANK JOURNAL (AFT)	130466	SIEMENS-MARTIN STEEL	43071			
1	CRANK JOURNAL (FOR)	130467	SIEMENS-MARTIN STEEL	43071			
1	CRANK JOURNAL (AFT)	130468	SIEMENS-MARTIN STEEL	43071			
NOTE: BEFORE SHRINKING SHAFT DIA = 510 MM, HOLES DIA = 509.15 MM. EACH WEB TO BE HEATED ONCE ONLY PIN AND JOURNAL TO BE ENTERED SIMULTANEOUSLY. THE HEATING FOR SHRINKING SHOULD BE CARRIED OUT IN AN OVEN AND NOT ON A GASHEATER IN THE SHOP.

CRANKSHAFT TO BE MACHINED ALLOWER MATERIAL:- SIEMENS-MARTIN STEEL 28-32 TONS TENSILE & WEBS - ELONGATION 24-25% TENSILE STRESS & ELONGATION = 57 MINIMUM. THE YIELD POINT OF THE MATERIAL TO BE NOT LESS THAN 14 TONS/IN². SHRINKAGE ALLOWANCE IS 1/100 OF THE DIAMETER. TO THE SURVEY AUTHORITIES' REQUIREMENTS, TESTS & INSPECTION.

CRANK NO 1 LEFT Hb CRANKSHAFT. CRANK NO 8 RIGHT Hb CRANKSHAFT.

SCALE: 1:20

CODE NO 0421

D.A. 8⁶²⁰ 1400 2C.

CRANKSHAFT ASSEMBLY.

6/1/38

SCALE: 1:20



CODE NO 0421

Harland & Wolff Ltd.

Sup 1012/13

u Crankshaft Assembly

Rowallan Castle u

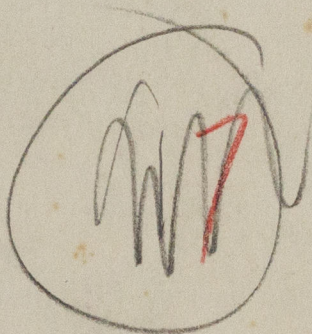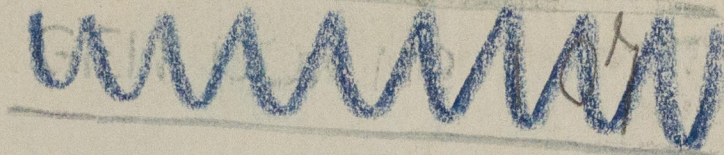

CRANKSHAFT ASSEMBLY

* ROWALLAN *

BEL. F. E. RPT. NC. 12335

ROWALLAN CASTLE

© 2019



Lloyd's Register
Foundation

W116-0099