





CARRIED OUT IN AN OVEN AND NOT ON
A GAS HEATER IN THE SHOP.

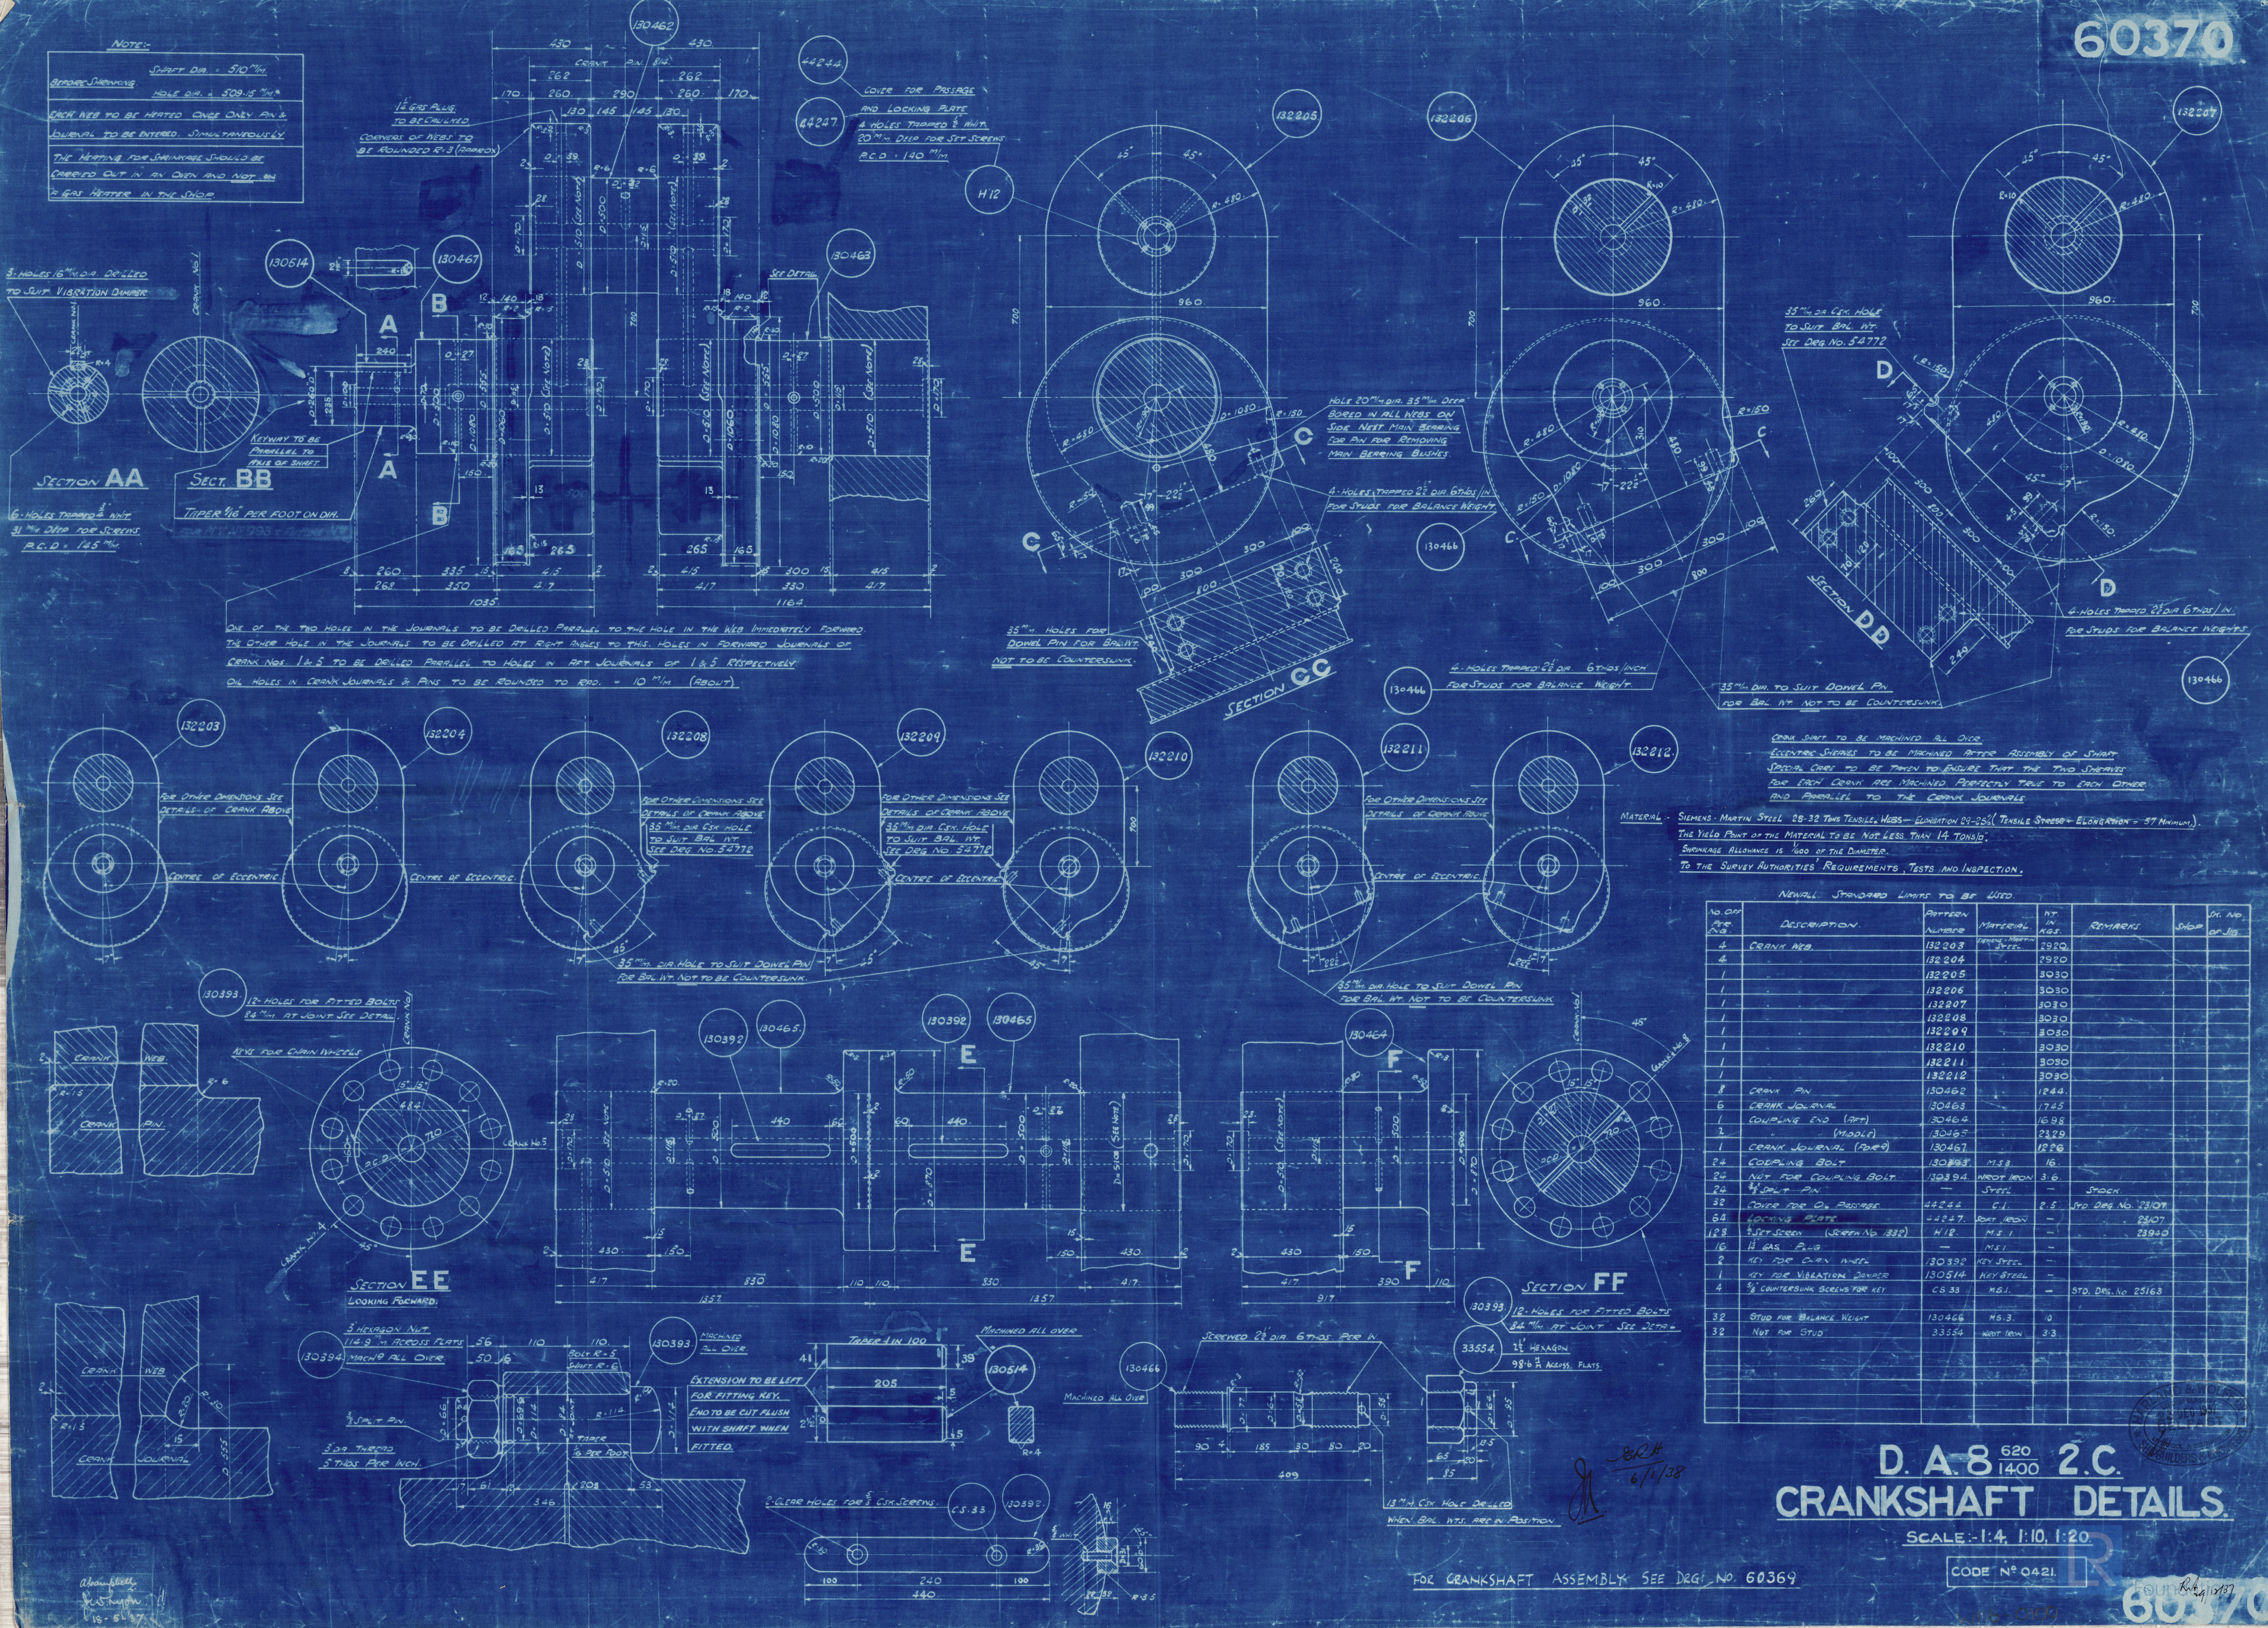

CODE N° 0421

D. A. 8 ⁶²⁰/₁₄₀₀ 2.C.
CRANKSHAFT DETAILS

SCALE:- 1:4, 1:10, 1:20

CODE N° 0421

Harland & Wolff Ltd.

Sup 1012/13

Crankshaft Details

CRANKSHAFT DETAILS

~~WOLFF LTD~~

2018

* ROWALLAN CASTLE
BEL. F. E. R. T. NC. 12335



© 2019

W116-0100 Regi