

SCALE $\frac{1}{8}" = 1 \text{ FOOT.}$

Supports under deckhouses to S.S.
Supports under deckhouses
to Surveyor's Satisfaction


INTE. PL.
1/2" OVERLAP
FRAME
SECTION

ALTERNATIVE METHOD OF WELDING STIFFENERS

INTE. PL.
1/2" OVERLAP
LIGHT CONTINUOUS WELD
STIFF. PL.

F'CLE DECK.

UPPER DECK.

MAIN DECK.

LOWER DECK.


ORLOP DECK.

LR.



 Lloyd's Register
Foundation

"Rowallan Castle."

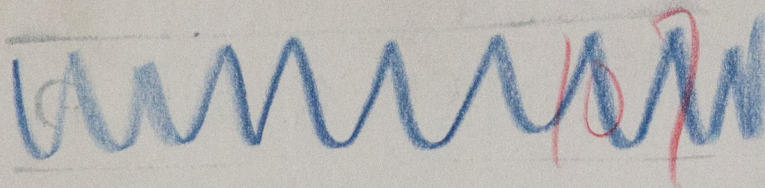

* ROWALLAN CASTLE
BEL. F. E. RPT. NO. 12335

Har

1012/13

PLAN OF DECKS

W116-0103



© 2019

Lloyd's Register
Foundation