



DECK PLANS N° 264.

SCALE $\frac{1}{8}$ " = ONE FOOT

SHELTER DECK.

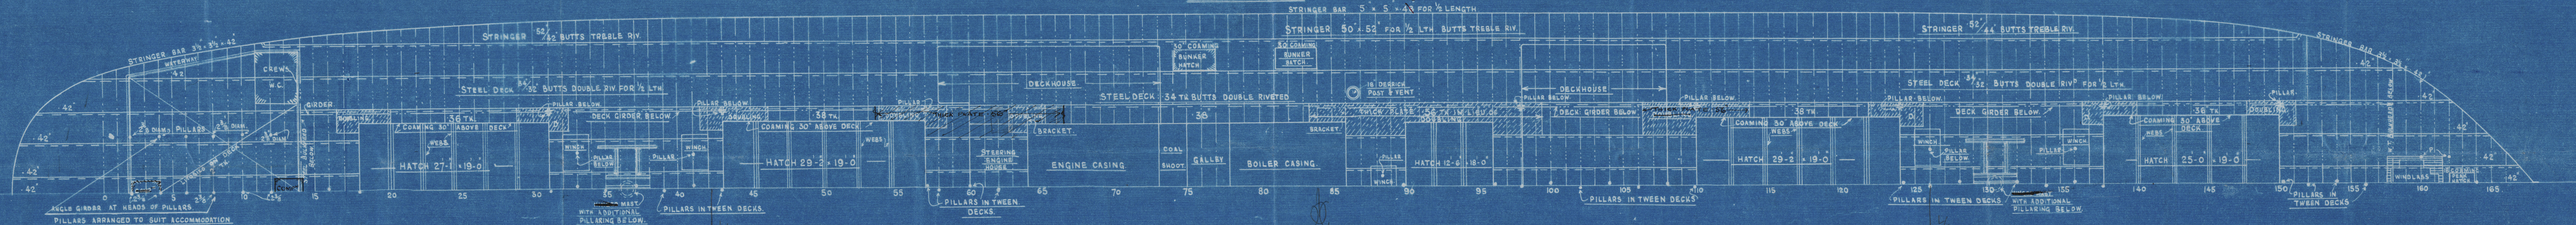

UPPER DECK.

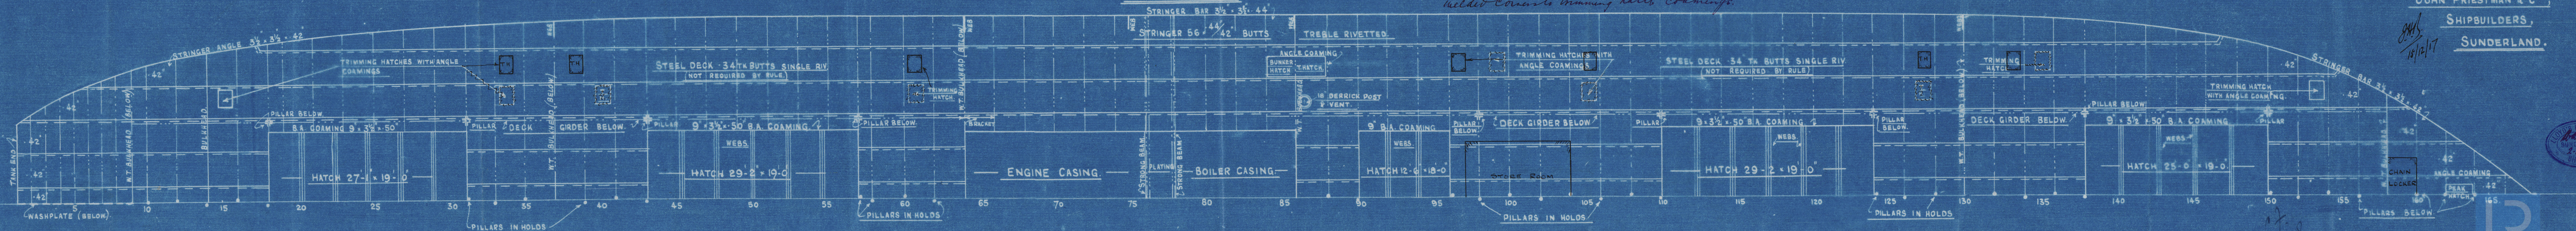

JOHN PRIESTMAN & COY.,
SHIPBUILDERS,
SUNDERLAND.



W116-0122

'Westcliff' now named "Rivers"
PRIESTMANS N^o 264

AMENDED DECK PLANS

SLD RPT N^o 27447

W112 - 0122



© 2019

Lloyd's Register
Foundation