


ALTERATIONS.
30 Oct. 11. DISTANCE OF STEP IN DOUBLE
BOTTOM, ABAFT B.R. BH? CHANGED.

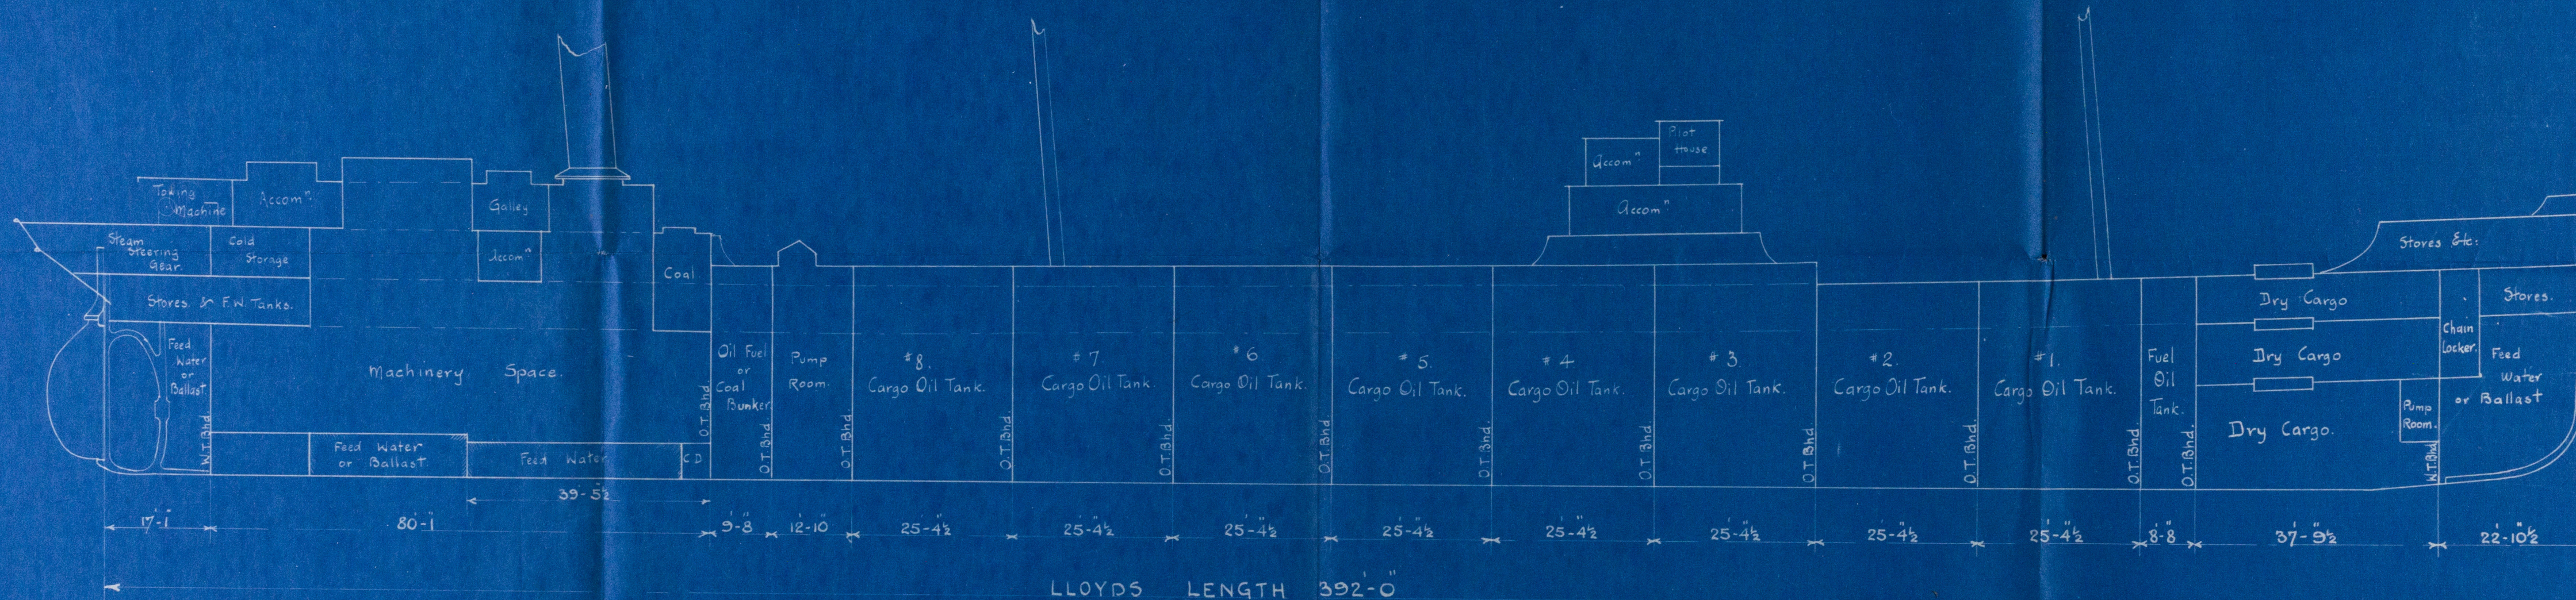

Note:- Bulkhead Locations to be taken from this Drawing.
Transverse frames to be taken from Dr 125-202-B
in relation to Bulkheads.

*Copy of plan
from plans*

SEP 24 1911
NEW YORK

PHILADELPHIA
FOR THE ENGINE

LLOYDS DIMENSIONS 392' x 51' x 30'-2"

INBOARD PROFILE.
REVISED SUBDIVISION.

SCALE 1/16" = 1 FOOT. MADE BY *LLP* DATE 25 O. 11
NEW YORK SHIPBUILDING COMPANY.
CAMDEN, NEW JERSEY, U.S.A.

Dr 125-202-C

E. J. Higgins NAVAL ARCHITECT.

- 1 L.I.B.
- 2 KISS
- 3 L.Y.H.I.L.
- 4 R.YOUNG
- 5 PIERCE
- 6 LOVERIN
- 7-8 J.YOUNG
- 9 H.O.G.
- 10 BLAKE
- 11 KENNEDY
- 12 PEG
- 13-14 9 2
- 15 17 LLOYDS
- 16 18 19 20 21 22 LLOYDS

W116-0157

NEW YORK SHIPPING CO.
GARDEN, J. U.S.A.
BLUE PRINT ROOM
Print No. 28
Made SEP 21 1914
For Dept. 470YDS

Inboard Profile


New York SSB nos 156/7

156 - ^{Refert} m. fullbright - ~~Mar 2160~~
157 - - fullstream - - - 216)

both approved Jan



W116-0157

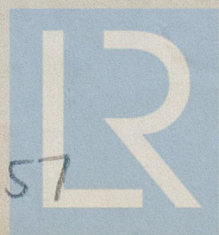

© 2019

Lloyd's Register
Foundation