LONDON COPY.

CASTINGS TO BE ROUGH MACHINED ON THESE (2) FACES BY MAKERS TO WITHIN 1/16" OF FINISHED SIZE
TO BE MACHINED TO FINISHED SIZE BY THE SUPERHEATER Co LTD

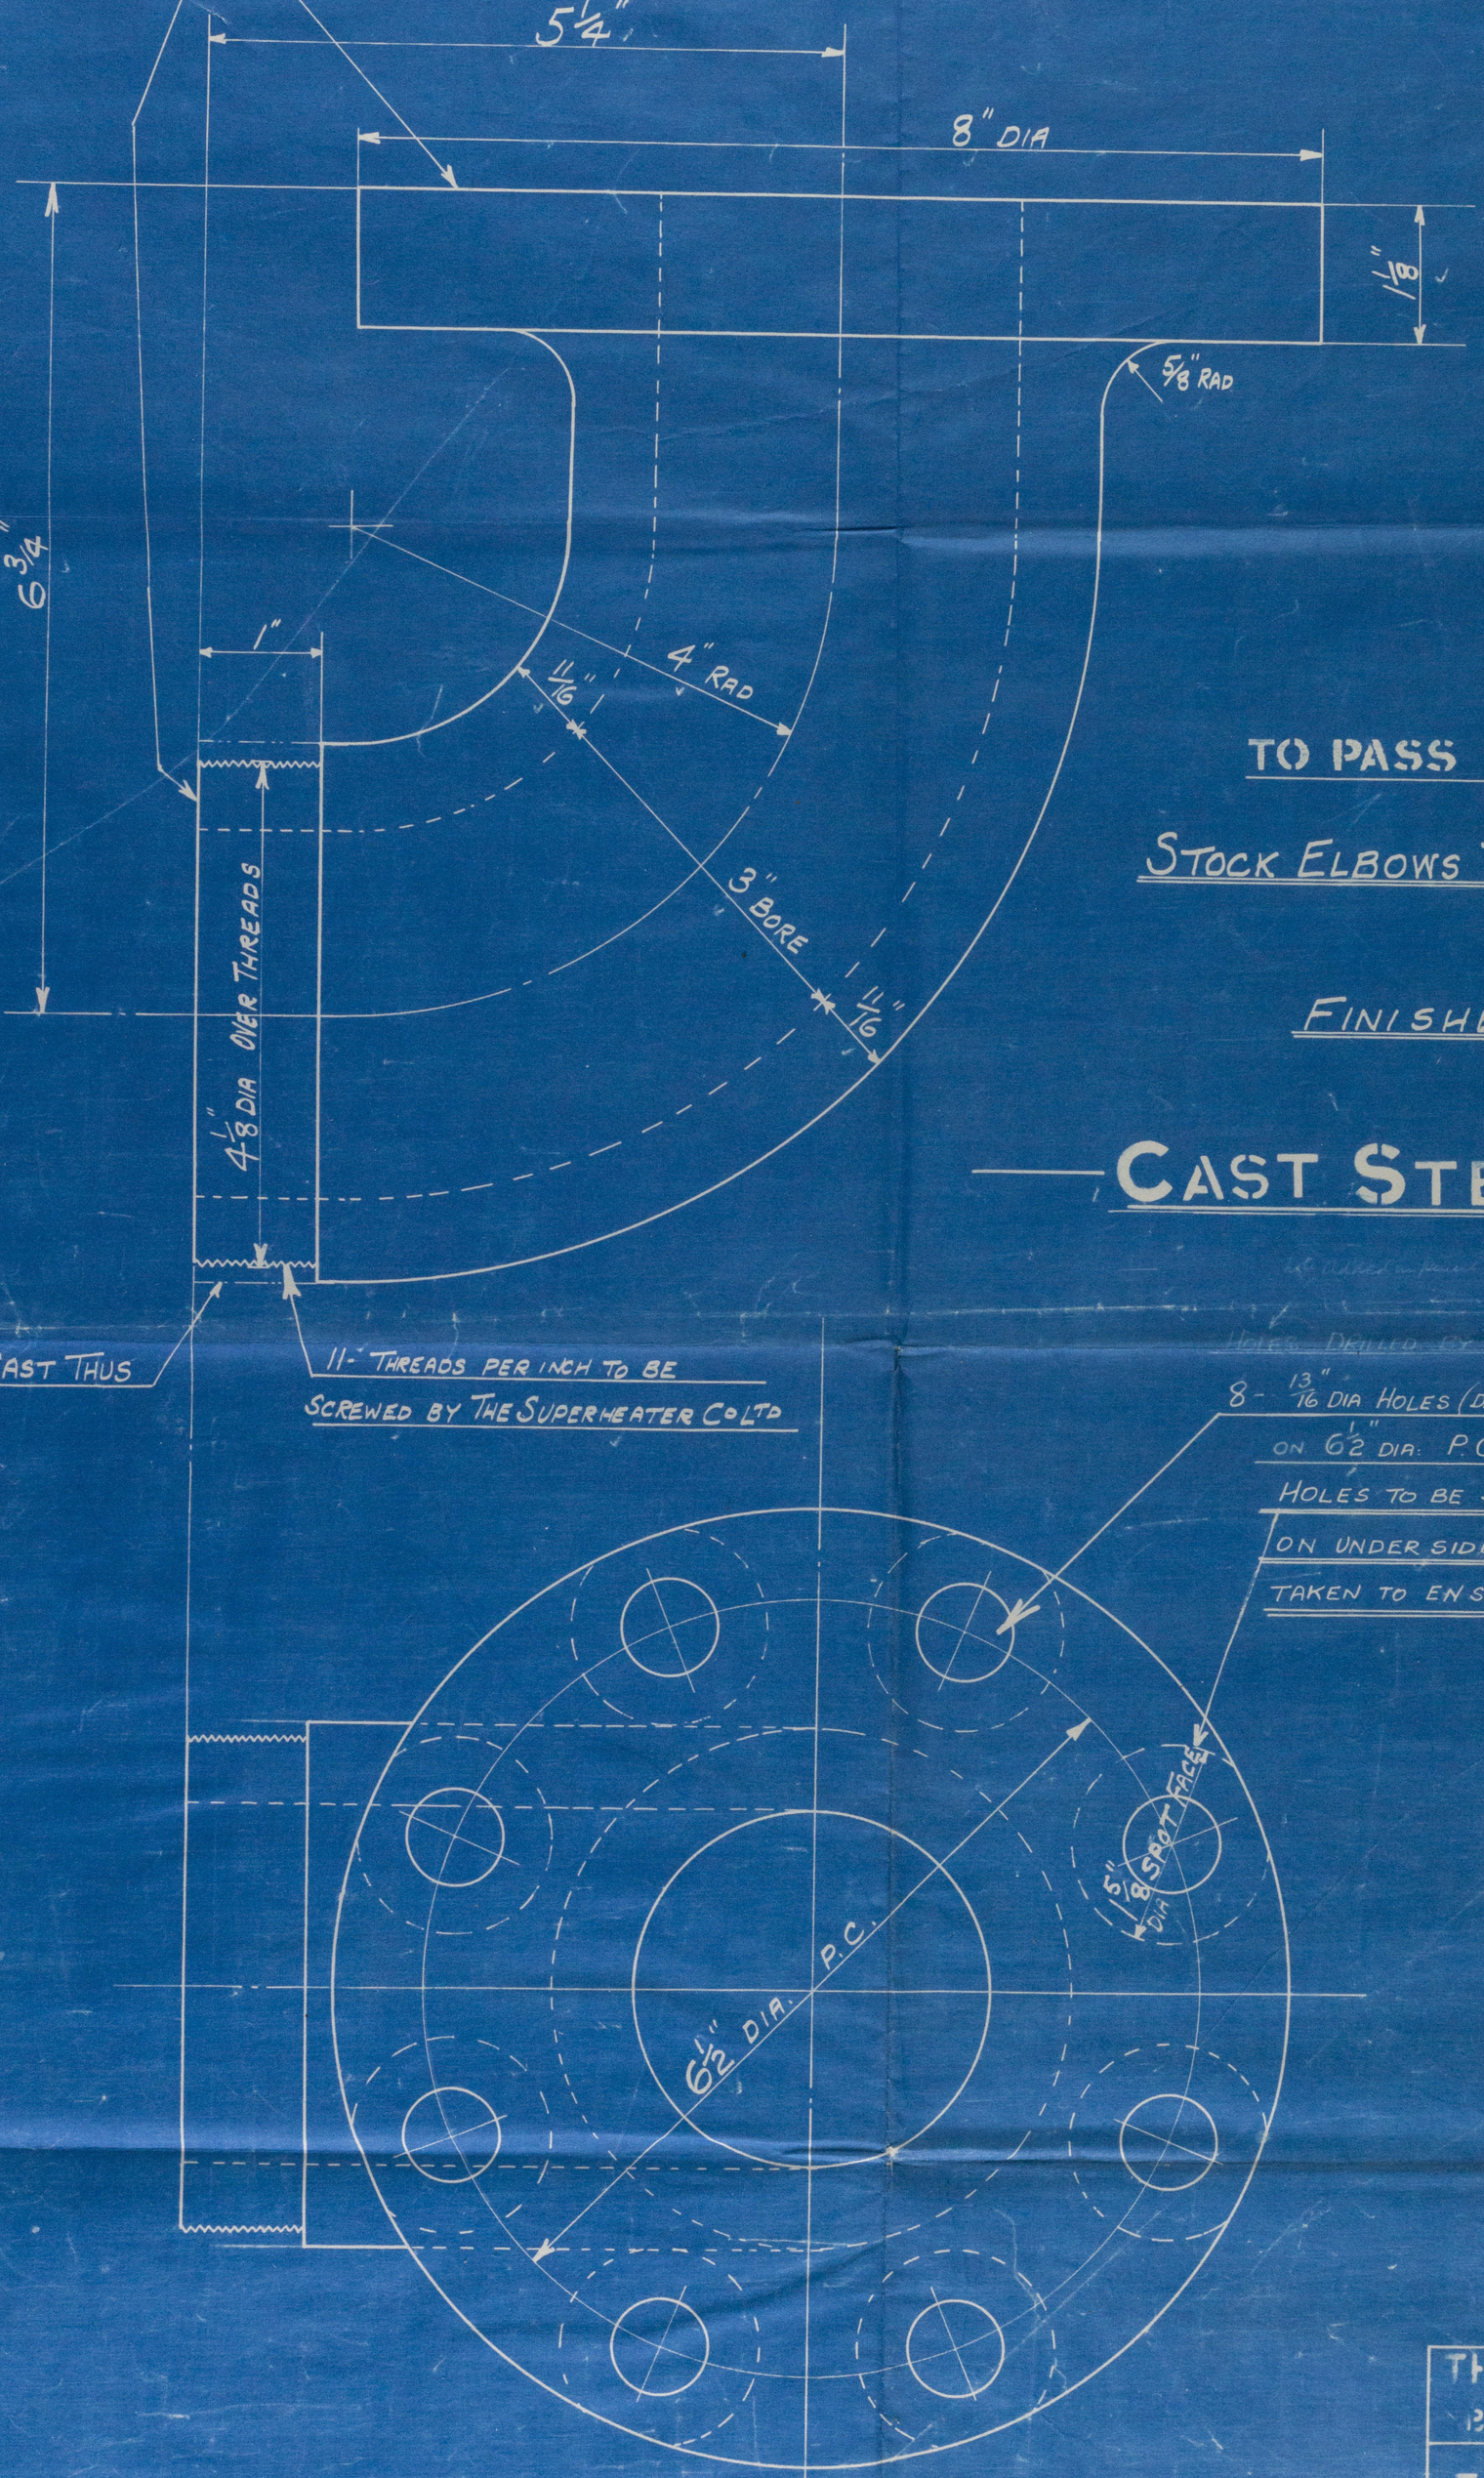

TO PASS LLOYDS SURVEY

STOCK ELBOWS TESTED TO 660 LBS PER SQINCH

FINISHED SIZES GIVEN

CAST STEEL

HOLES DRILLED BY THE SUPERHEATER Co LTD

PATTERN (DRAWING No M.L. 600) ALTERED

PATTERN No M.1430.

SCALE
FULL SIZE
DR'N [illegible] TC'D [illegible]
[illegible] 17/7/33

THE SUPERHEATER Co LTD
BUSH HOUSE LONDON W.C.2

TITLE ELBOW (3" BORE)

REF.	CK'D		DRAWING No'S
GEN'L USE	17/7/33		ML 630

S/S "St Margaret"
Bro[illegible] Rept No 15 [illegible]

THE SUPERHEATER CO. LTD. 8 JAN 1942 BOWDON, ALTRINCHAM, CHESHIRE

13-1-42.

LONDON COPY.
Lloyd's Register Foundation