

276.16

Nº624 MIDSHIP SECTION



DIMENSIONS 320'-0" x 41'-4" x 25'-6" MLD.

SCALE 1/2" = ONE FOOT.

*See plan for additional
details to the specification
General arrangement plan
has complete units*

RIVETING			
THROUGH FRAMES & SHELL	SPACED 6" APART	3/4" RIVETS	
BUTTS OF SHELL PLATING	DOUBLE RIVETED IN PEAKS & BOTTOM FOR 1/2" L. FORM	3/4" RIVETS	
SHEERSTRAKE	DOUBLE RIVETED IN DOUBLE AT ENDS	3/4" RIVETS	
UPPER DECK STRENGTH	DOUBLE RIVETED IN DOUBLE AT ENDS	3/4" RIVETS	
MAIN STRENGTH	DOUBLE RIVETED IN DOUBLE AT ENDS	3/4" RIVETS	
TANK MARGIN	DOUBLE RIVETED	3/4" RIVETS	
TANK TOP	DOUBLE RIVETED	3/4" RIVETS	
BRIDGE DECK	DOUBLE RIVETED	3/4" RIVETS	
POOP & HULL DECK	DOUBLE RIVETED	3/4" RIVETS	
SEAMS OF UPPER DECK PLATING	DOUBLE RIVETED	3/4" RIVETS	
MAIN	DOUBLE RIVETED	3/4" RIVETS	
TANK TOP	DOUBLE RIVETED	3/4" RIVETS	
SHELL	DOUBLE RIVETED	3/4" RIVETS	
P.S.F.	DOUBLE RIVETED	3/4" RIVETS	

*where it is not possible
to be quadruple riveted
for 1/2" L. form*

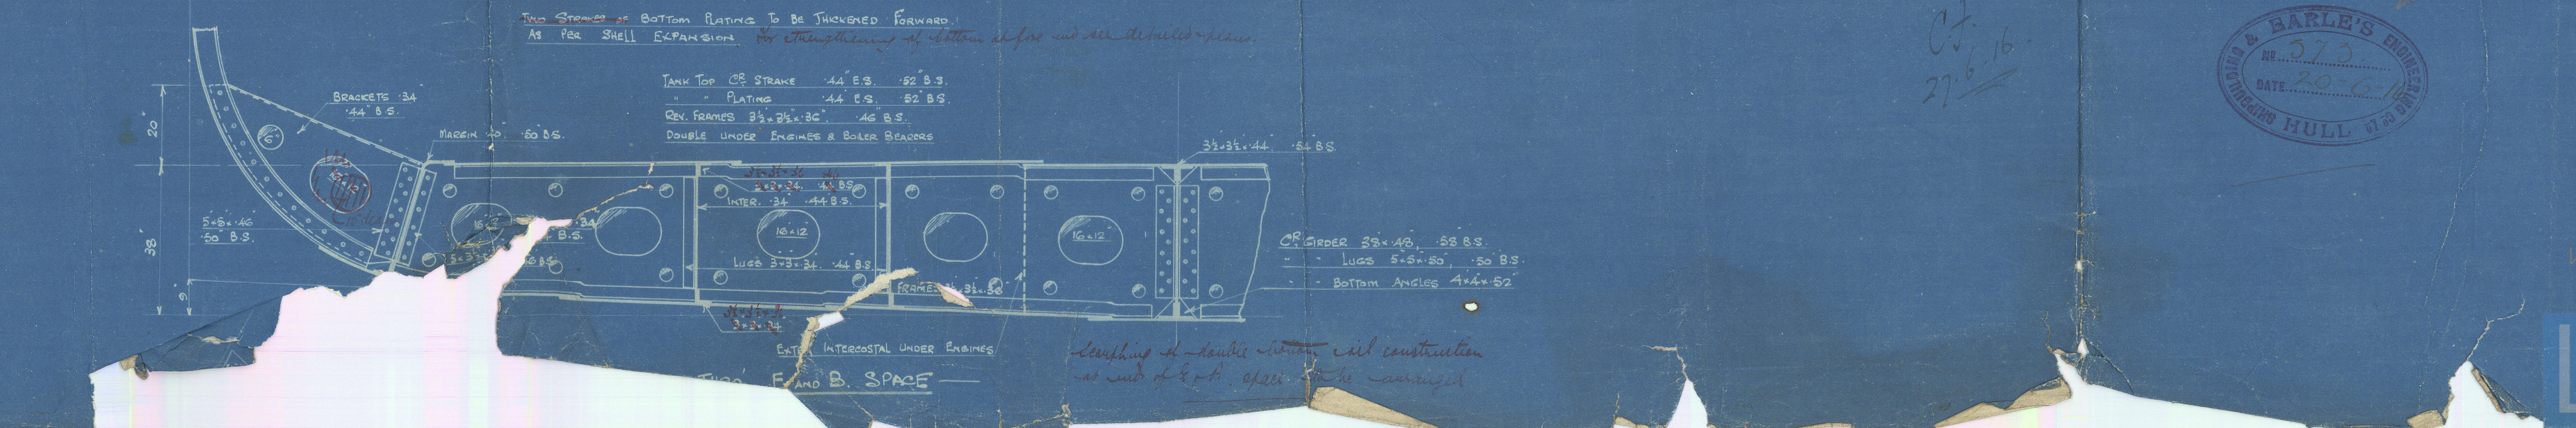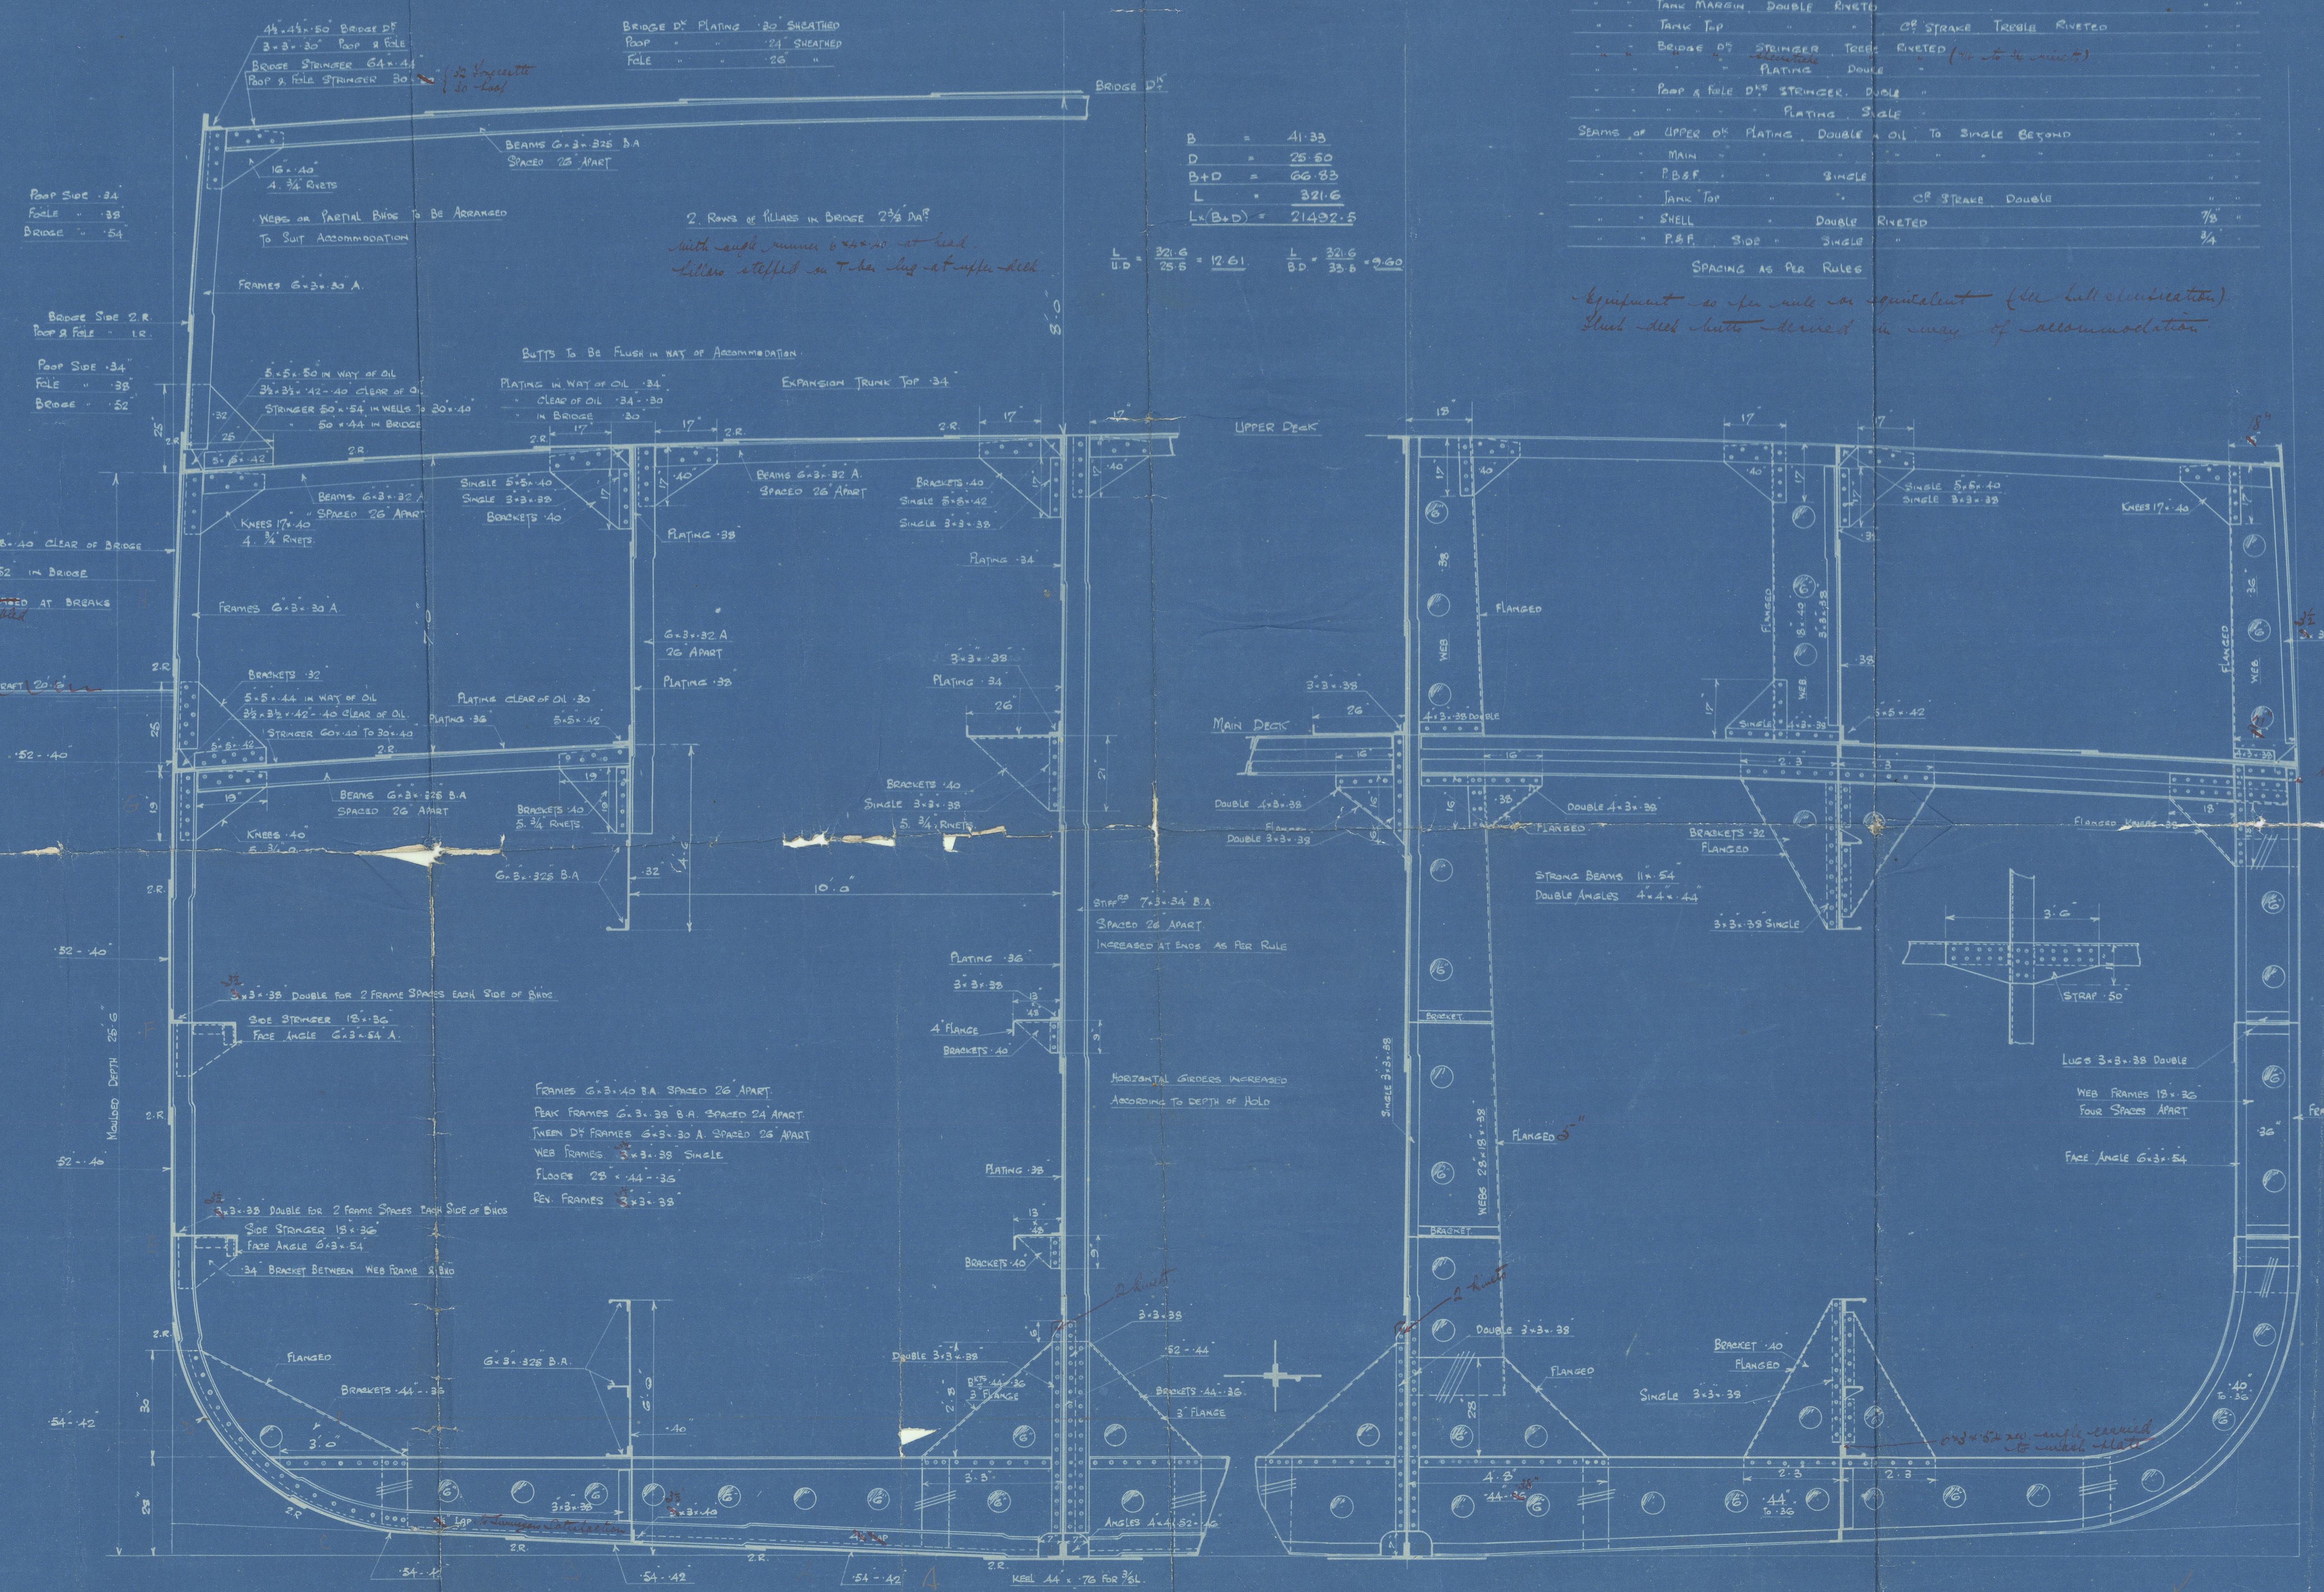

W160-5561


W.S. 195-7

R. F. A. Francol.


Messrs Earle's S. B Co S/s N° 624

Mudship Section

Hull Rpt No. 30,303

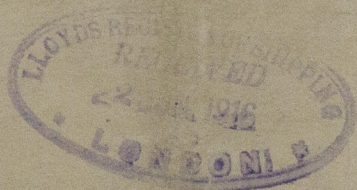

RETAIN

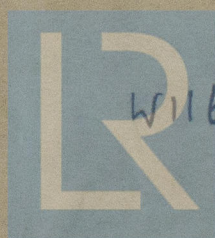

© 2020

W1160-0061

Lloyd's Register
Foundation