



N^{os} 504 & 511
STEEL SCREW STEAMERS

DIMENSIONS 168 O.A.P. 26.6-1/2 MLD. *Benkox*

PROFILE AND DECK PLAN *2684*

SCALE 1/4" = 1 FOOT

*Following arrangements throughout
to Surveyors satisfaction*

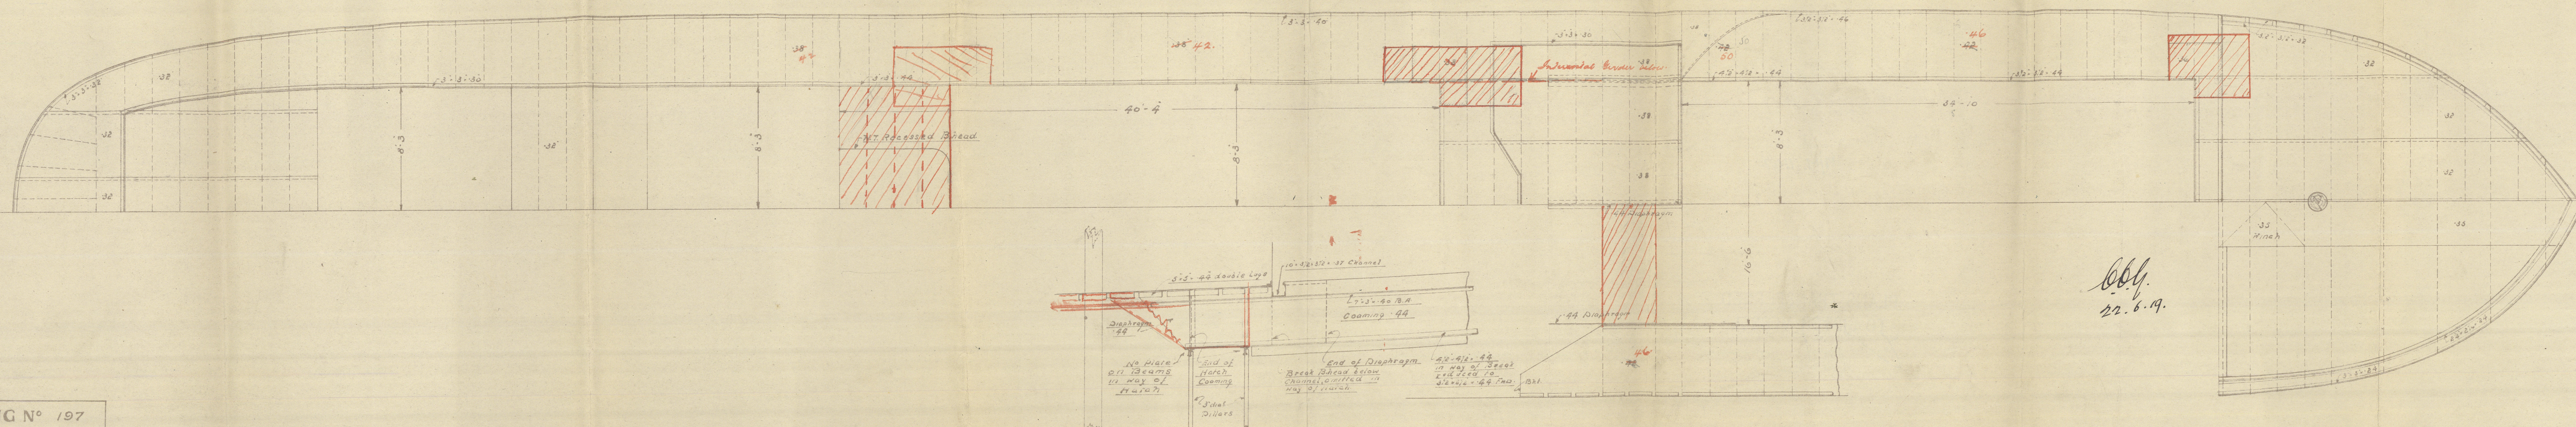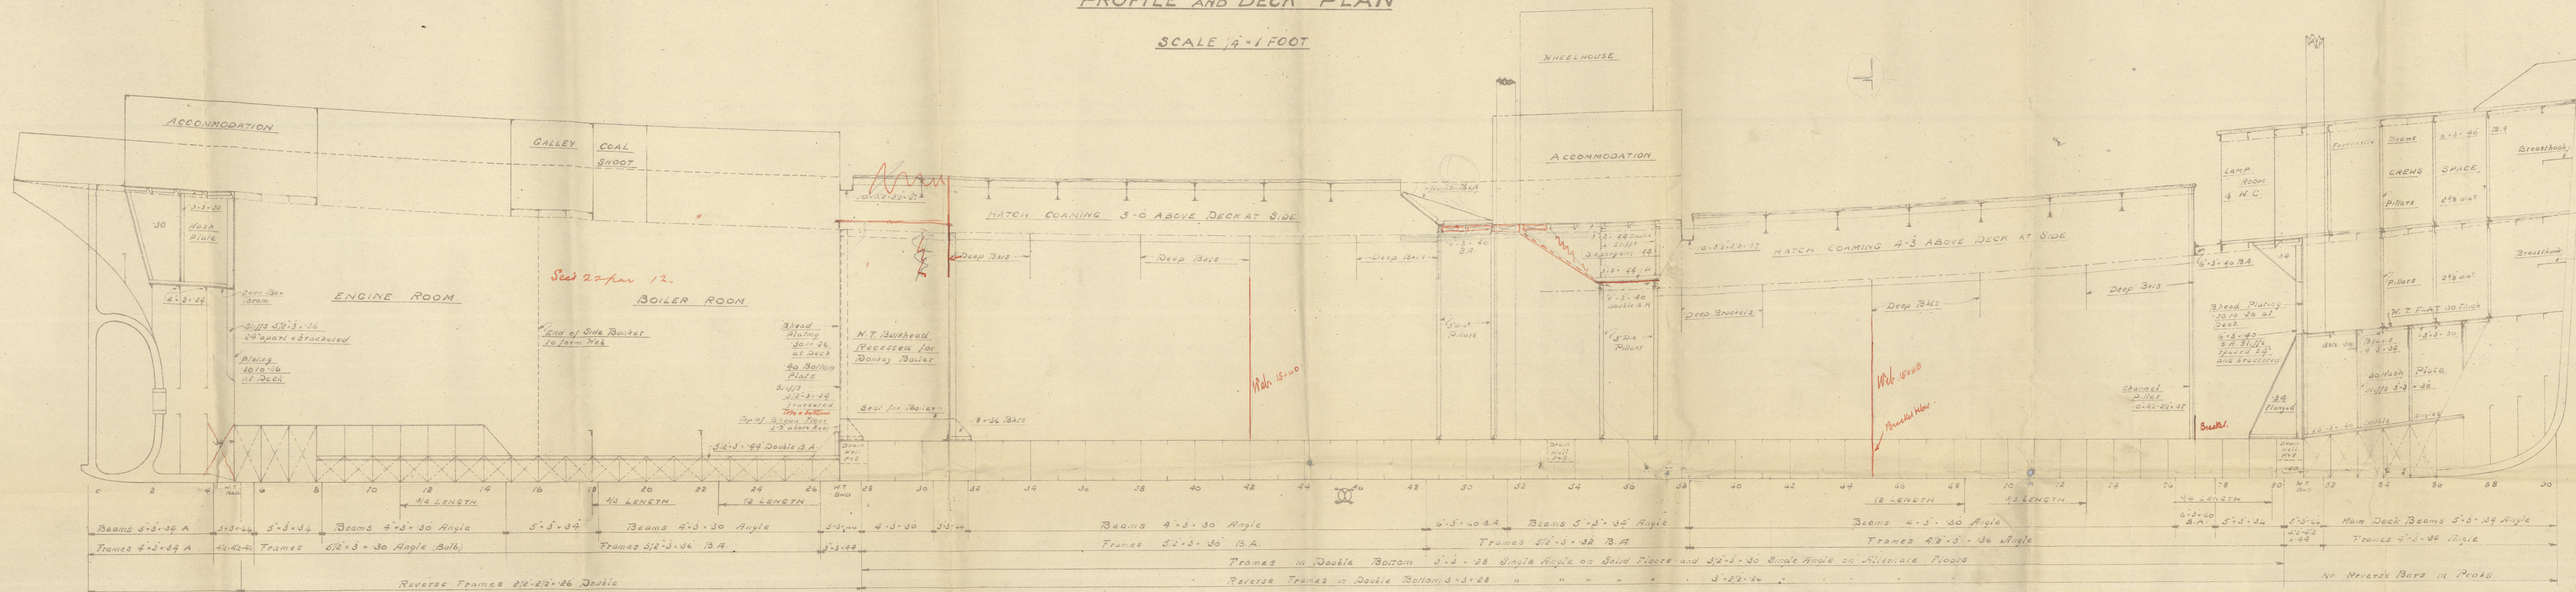

DRAWING N^o 197
 THE ABOVE DRAWING NO MUST BE
 QUOTED IN ALL CORRESPONDENCE IN
 REFERENCE TO SAME.
JOHN CHAMBERS LTD
 SHIPBUILDERS AND ENGINEERS
 OULTON ROAD, LOWESTOFT.

*Sketch showing overlap of
hatch coaming & superstructure
in way of break.*

*bbg.
22.6.19.*

Drawing Office

504811

Profile & Decks

Reamended plan

appt 20/11/19

"Royal Regis"

Lon. 85671

Berrisdale

M/M. 1162

PLANS TRANSFERRED
TO SISTER VESSEL

Barmelita



© 2021

Lloyd's Register
W1162-0071
Foundation