

— M.V. DUNEDIN STAR —

SKETCH SHOWING POSITION OF TWEEN DECK BHDs

NOW FITTED IN AFTER BODY OF SHIP.

NOTE: - IT IS CONSIDERED THAT THE STEEL BHDs ORIGINALLY
FITTED IN TWEEN DECKS IN FORE BODY OF SHIP AND
AT PRESENT INSULATED ON BOTH SIDES MAY BE
ACCEPTED WITHOUT BEING MODIFIED.

*all fit w.t. casing
& cover*



© 2020


Lloyd's Register
Foundation

W1164-0129

M/V. "Bunedin Star".

Sketch showing position
of tween deck Bhds.

Liv rept. No. 118647.

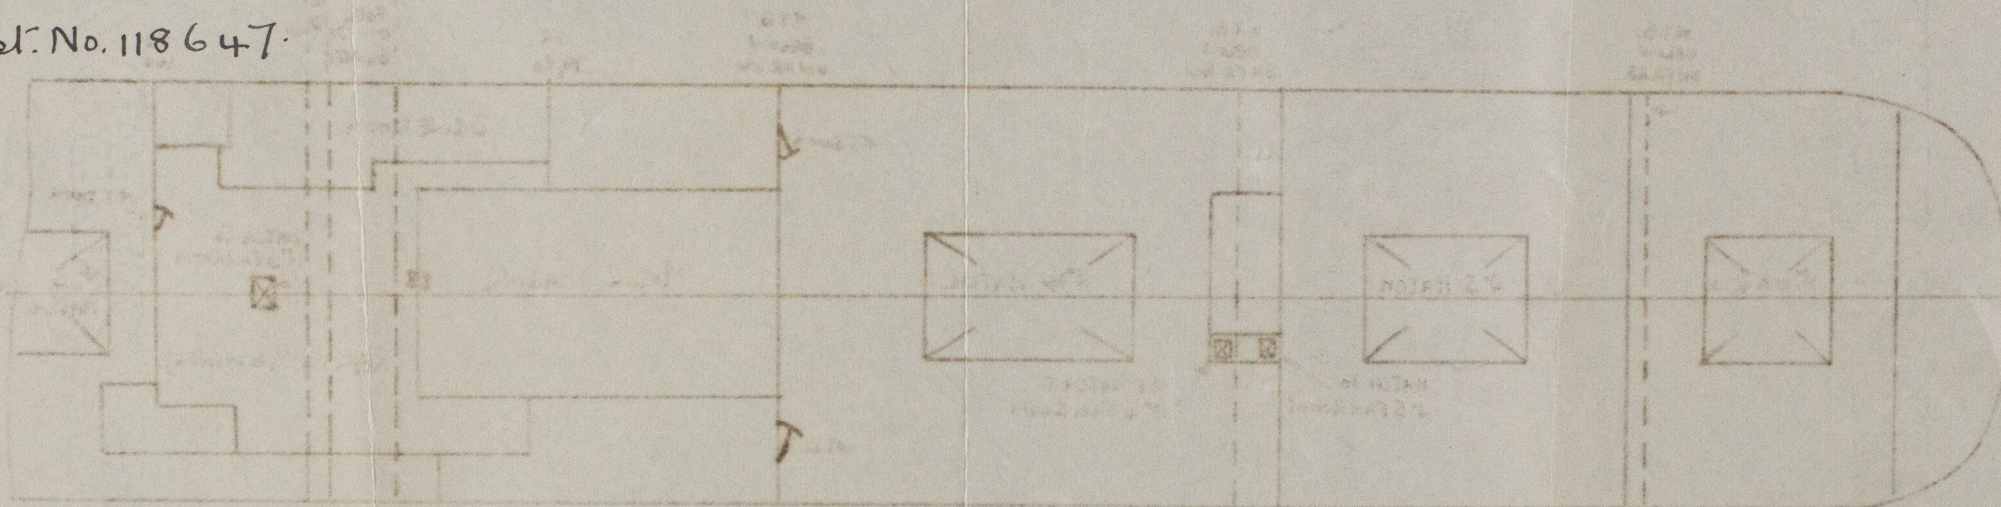

Sketch showing position
of tween deck Bhds.
Liv rept. No. 118647.



© 2020

Lloyd's Register
Foundation