

### — M.V. "DUNEDIN STAR" —

SKETCH SHOWING POSITION OF TWEEN DECK BMDs

NOW FITTED IN AFTER BODY OF SHIP.

NOTE: — IT IS CONSIDERED THAT THE STEEL BMDs ORIGINALLY  
FITTED IN TWEEN DECKS IN FORE BODY OF SHIP AND  
AT PRESENT INSULATED ON BOTH SIDES MAY BE  
ACCEPTED WITHOUT BEING MODIFIED.

*access hatch  
to be fitted  
with w.t. coaming  
& cover*



© 2020

Lloyd's Register  
Foundation


W1164-0130



M/V. "Bunedin Star"

Sketch showing Position  
of Tween Deck Bkds.

Liv rept No. 118647

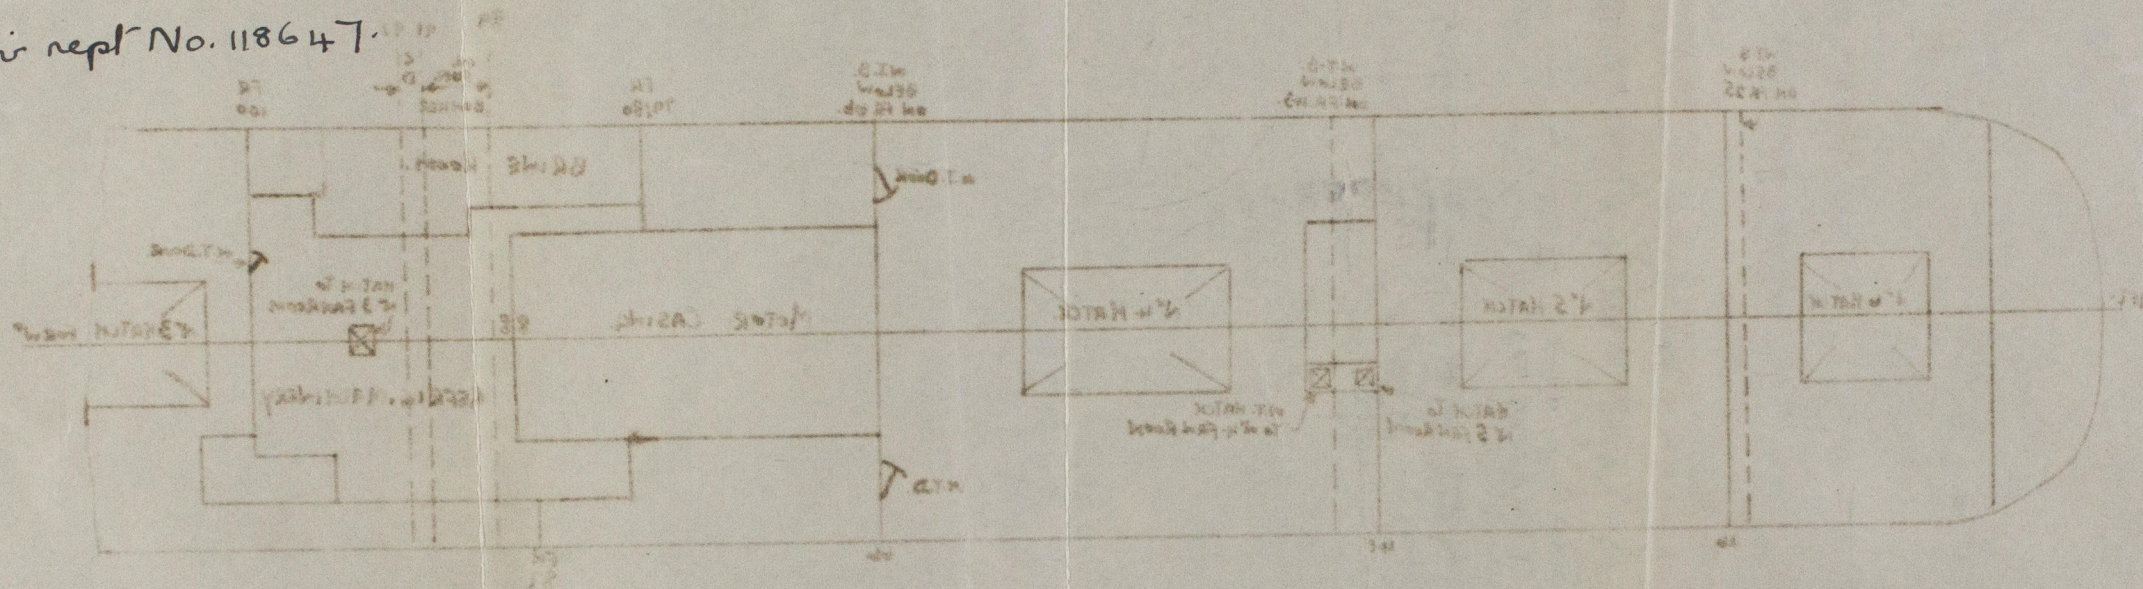

— M/V. BUNEDIN STAR —

Sketch showing Position of Tween Deck Bkds.








© 2020

Lloyd's Register  
Foundation