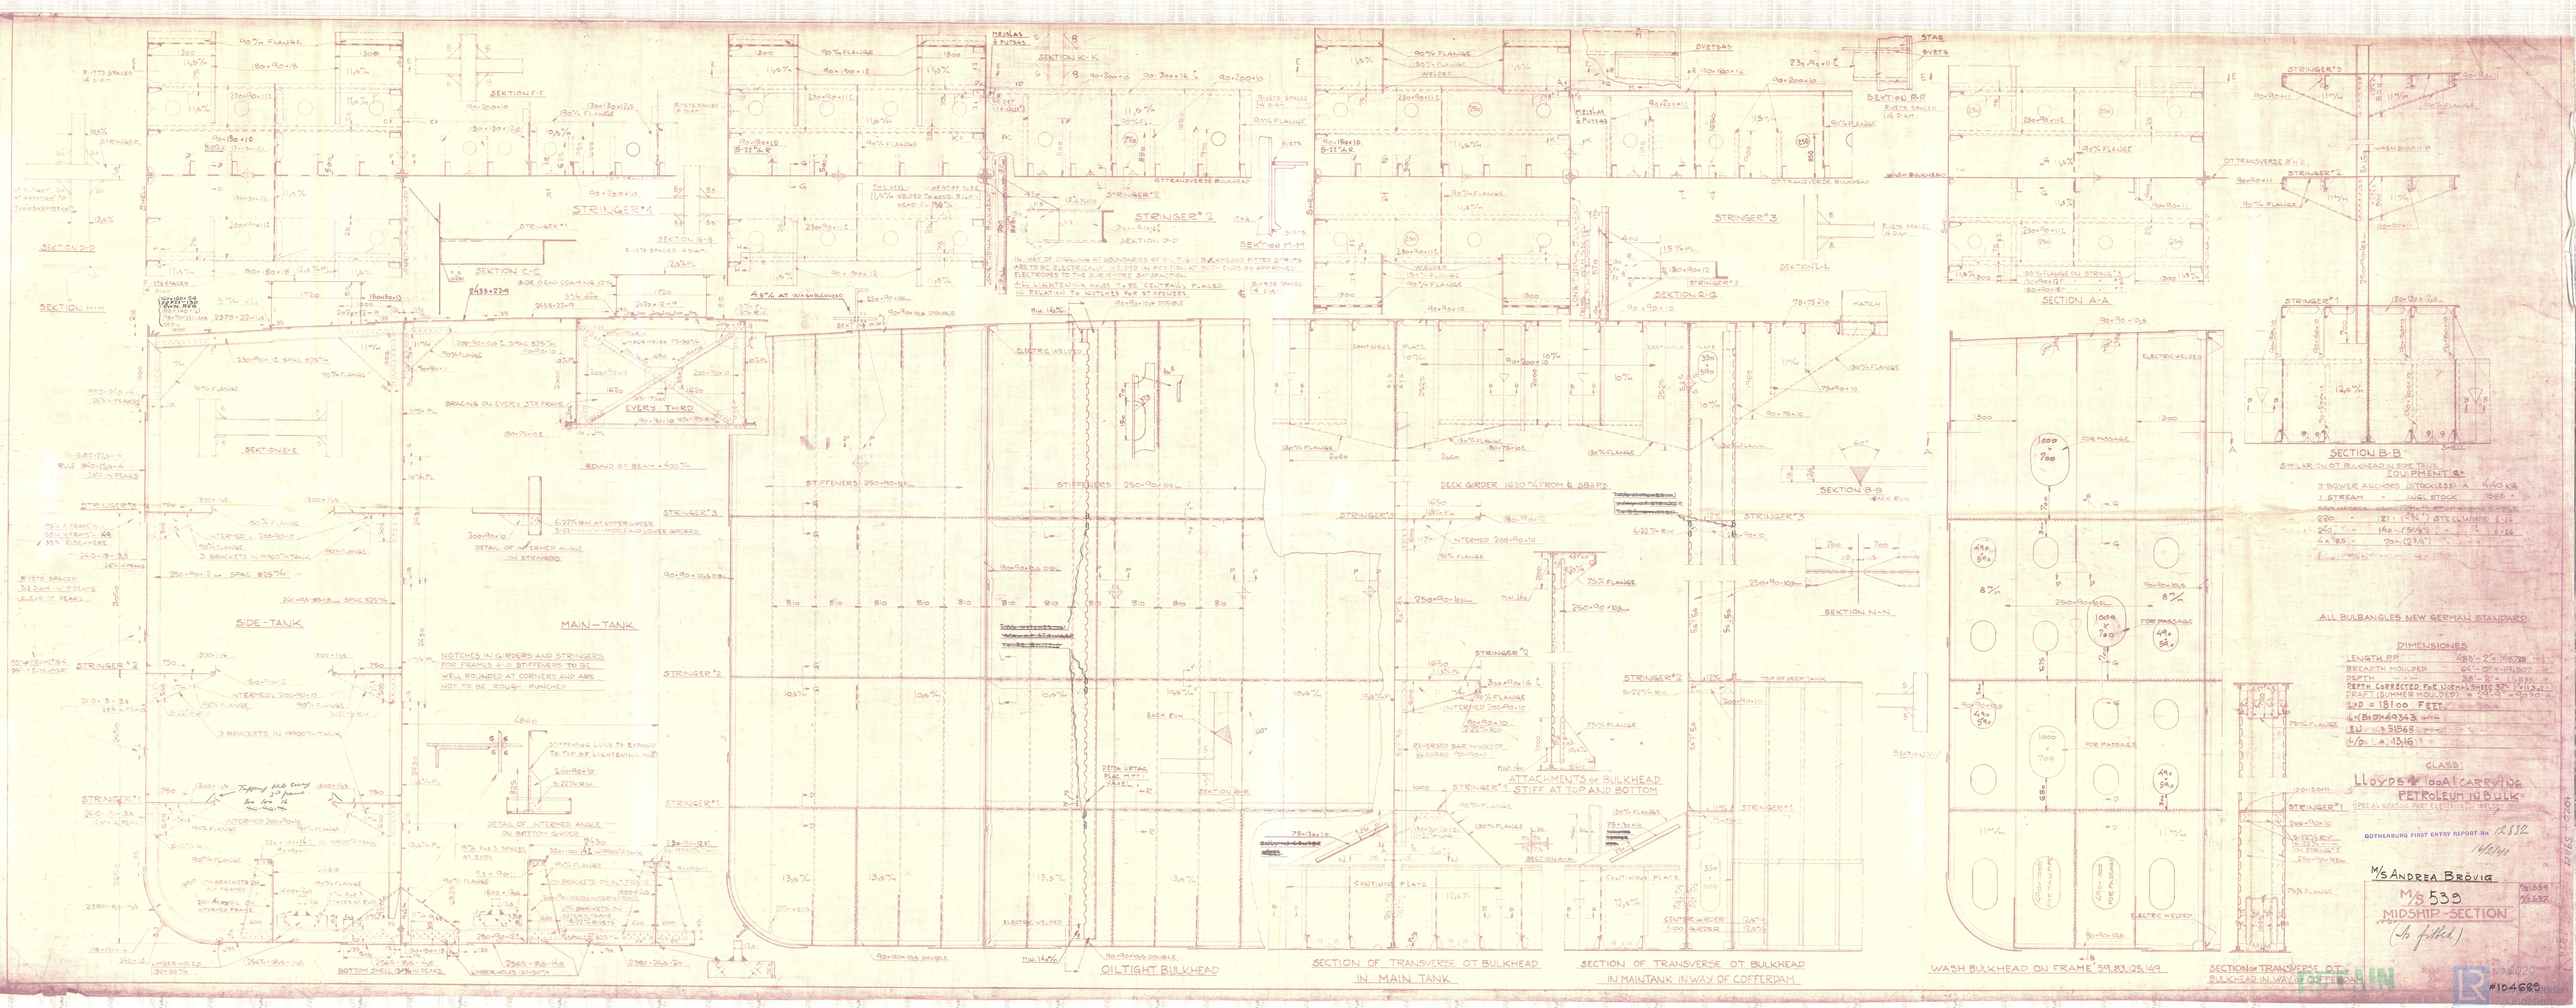
SECTION M-M
SECTION E-E
SECTION F-F
STRINGER #1
SECTION C-C
SECTION G-G
SECTION H-H
SECTION K-K
STRINGER #2
SECTION P-P
SECTION Q-Q
STRINGER #3
SECTION L-L
SECTION R-R
SECTION A-A
SECTION B-B
SECTION N-N
SECTION W-W
SIDE TANK
MAIN TANK
NOTCHES IN GIRDERS AND STRINGERS FOR FRAMES AND STIFFENERS TO BE WELL ROUNDED AT CORNERS AND ARE NOT TO BE ROUGH PUNCHED
DECK GIRDER
ATTACHMENTS OF BULKHEAD STIFF AT TOP AND BOTTOM
OILTIGHT BULKHEAD
SECTION OF TRANSVERSE OT BULKHEAD IN MAIN TANK
SECTION OF TRANSVERSE OT BULKHEAD IN MAINTANK IN WAY OF COFFERDAM
WASH BULKHEAD ON FRAME 59,83,125,149
SECTION OF TRANSVERSE OT BULKHEAD IN WAY OF COFFERDAIN
EQUIPMENT &c
DIMENSIONES
CLASS:
LLOYDS ✠ 100A1 CARRY 10% PETROLEUM IN BULK
GOTHENBURG FIRST ENTRY REPORT No 12832
M/S ANDREA BROVIG
M/S 539
MIDSHIP-SECTION
(As fitted)
#104689