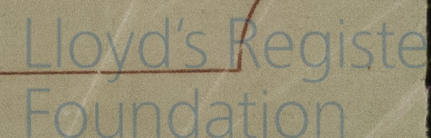


Nº 542.

SCALE $\frac{1}{2}'' = 1$ FOOT ✓

TO CLASS LLOYDS:- 100A.1. "STEAM TRAWLER" ✓

$$B+D = 37.62$$
$$d = 12.33$$


W1166-0072

Cook, Welton & Gemmell Ltd.
Beverley

Middlelip Section
No. 542 + 564/5-572/3

W.S. 308
* "Aventurine" 542
S.S. _____
HULL REPORT No. 40707

S.S. "Siberite" 564
HULL REPORT No. 42000

3/4 "Eucrase" 565

S.S. "Almandine"
HULL REPORT No. 42794

W1166-0072

S.S. "Pyrope"
HULL REPORT No. _____



© 2021
Lloyd's Register
Foundation
W1166-0072