


ANCHORS & CHAINS


EQUIPMENT NO.	34719
1 BOWER ANCHOR	60-0-0 STOCKLESS
1 " "	60-0-0 " "
1 " "	50 2 0
1 " "	170 2 0 STOCKLESS
1 STREAM ANCHOR	16-1-0 5x0-5 STOCK
1 KEEDGE	7-0-0
210 FATHOMS OF 2" STUD CHAIN CABLE	
90 "	14" STREAM CHAIN OR 4" STEEL WIRE
120 "	14" HEMPTONLINE OR 4" "
2 of 40 "	8" HEMPTONLINE OR 2" "
2 of 40 "	7" WARP " 2 1/2 " "

SECTION THRO ENGINE ROOM

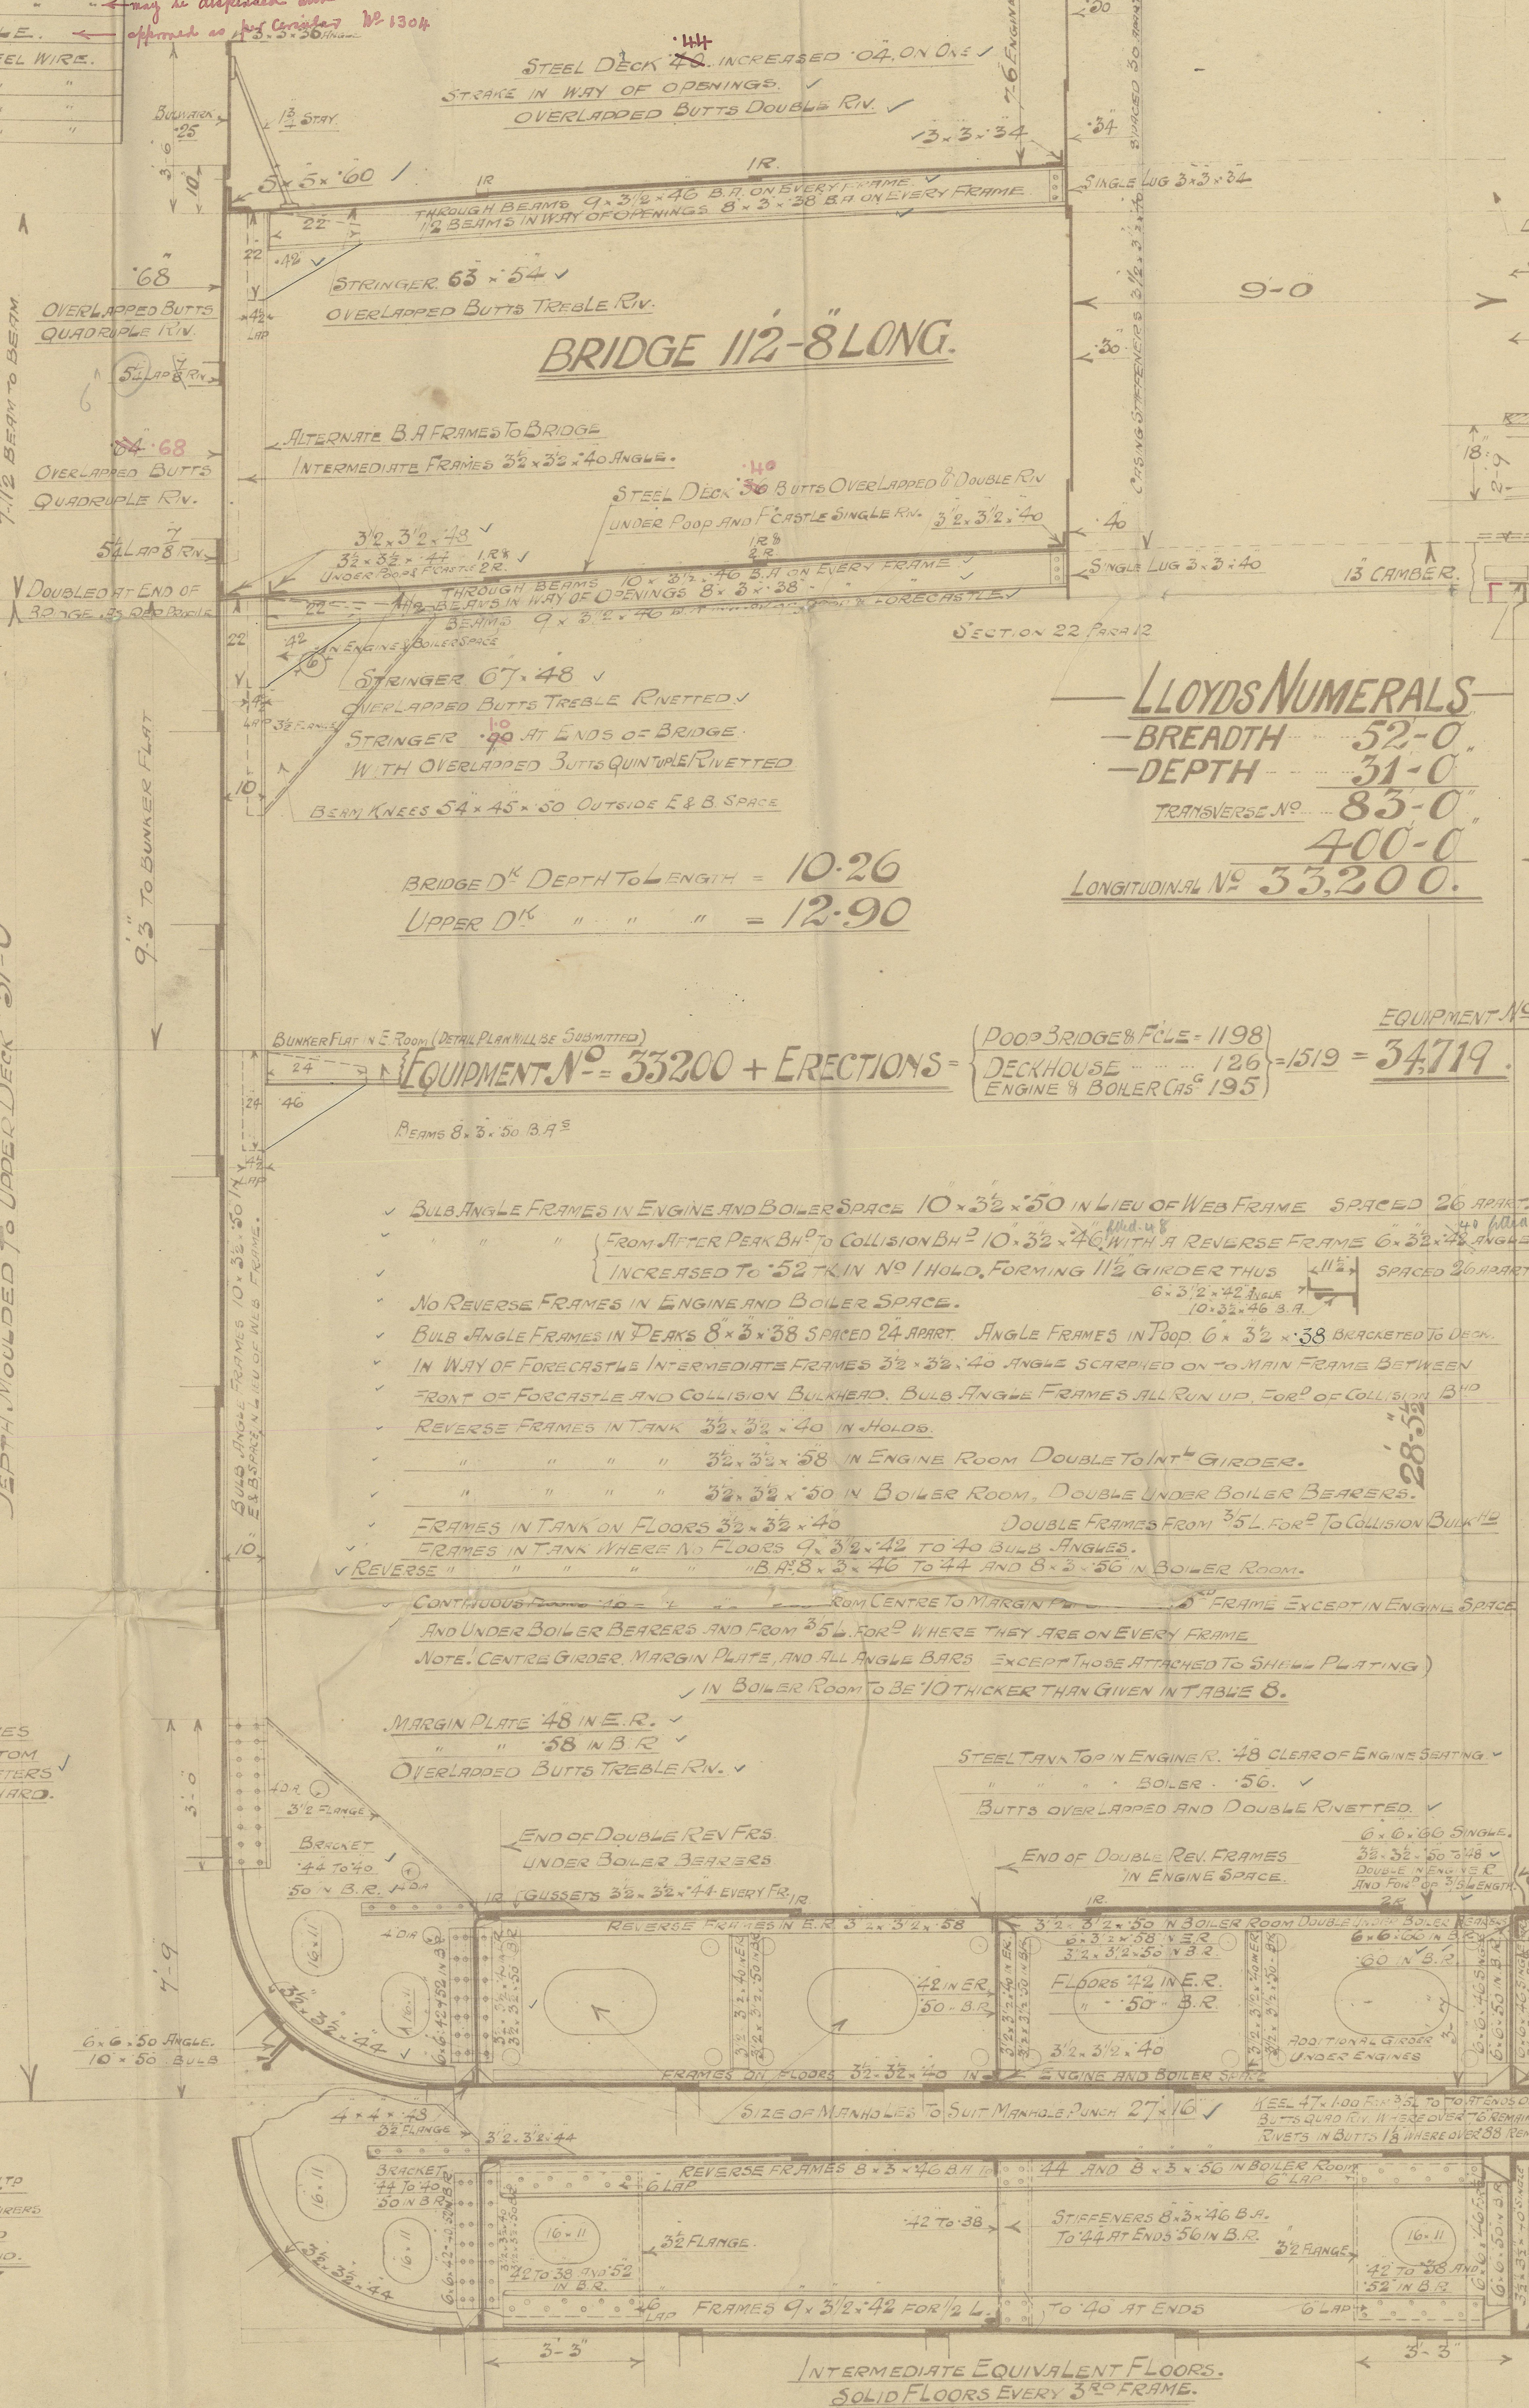

A TYPE.
MIDSHIP SECTION. No 307
STANDARD STEAMER
 LENGTH B.P. 400'-0"
 BREADTH MLD 52'-0" EX 52'-5"
 DEPTH MLD UPPER D^K 31'-0"
 DEPTH IN HOLD C.B. 28'-52"
 SCALE 1/2" ONE FOOT
 CLASS 100.91 SINGLE D^K

SECTION THRO HOLDS.

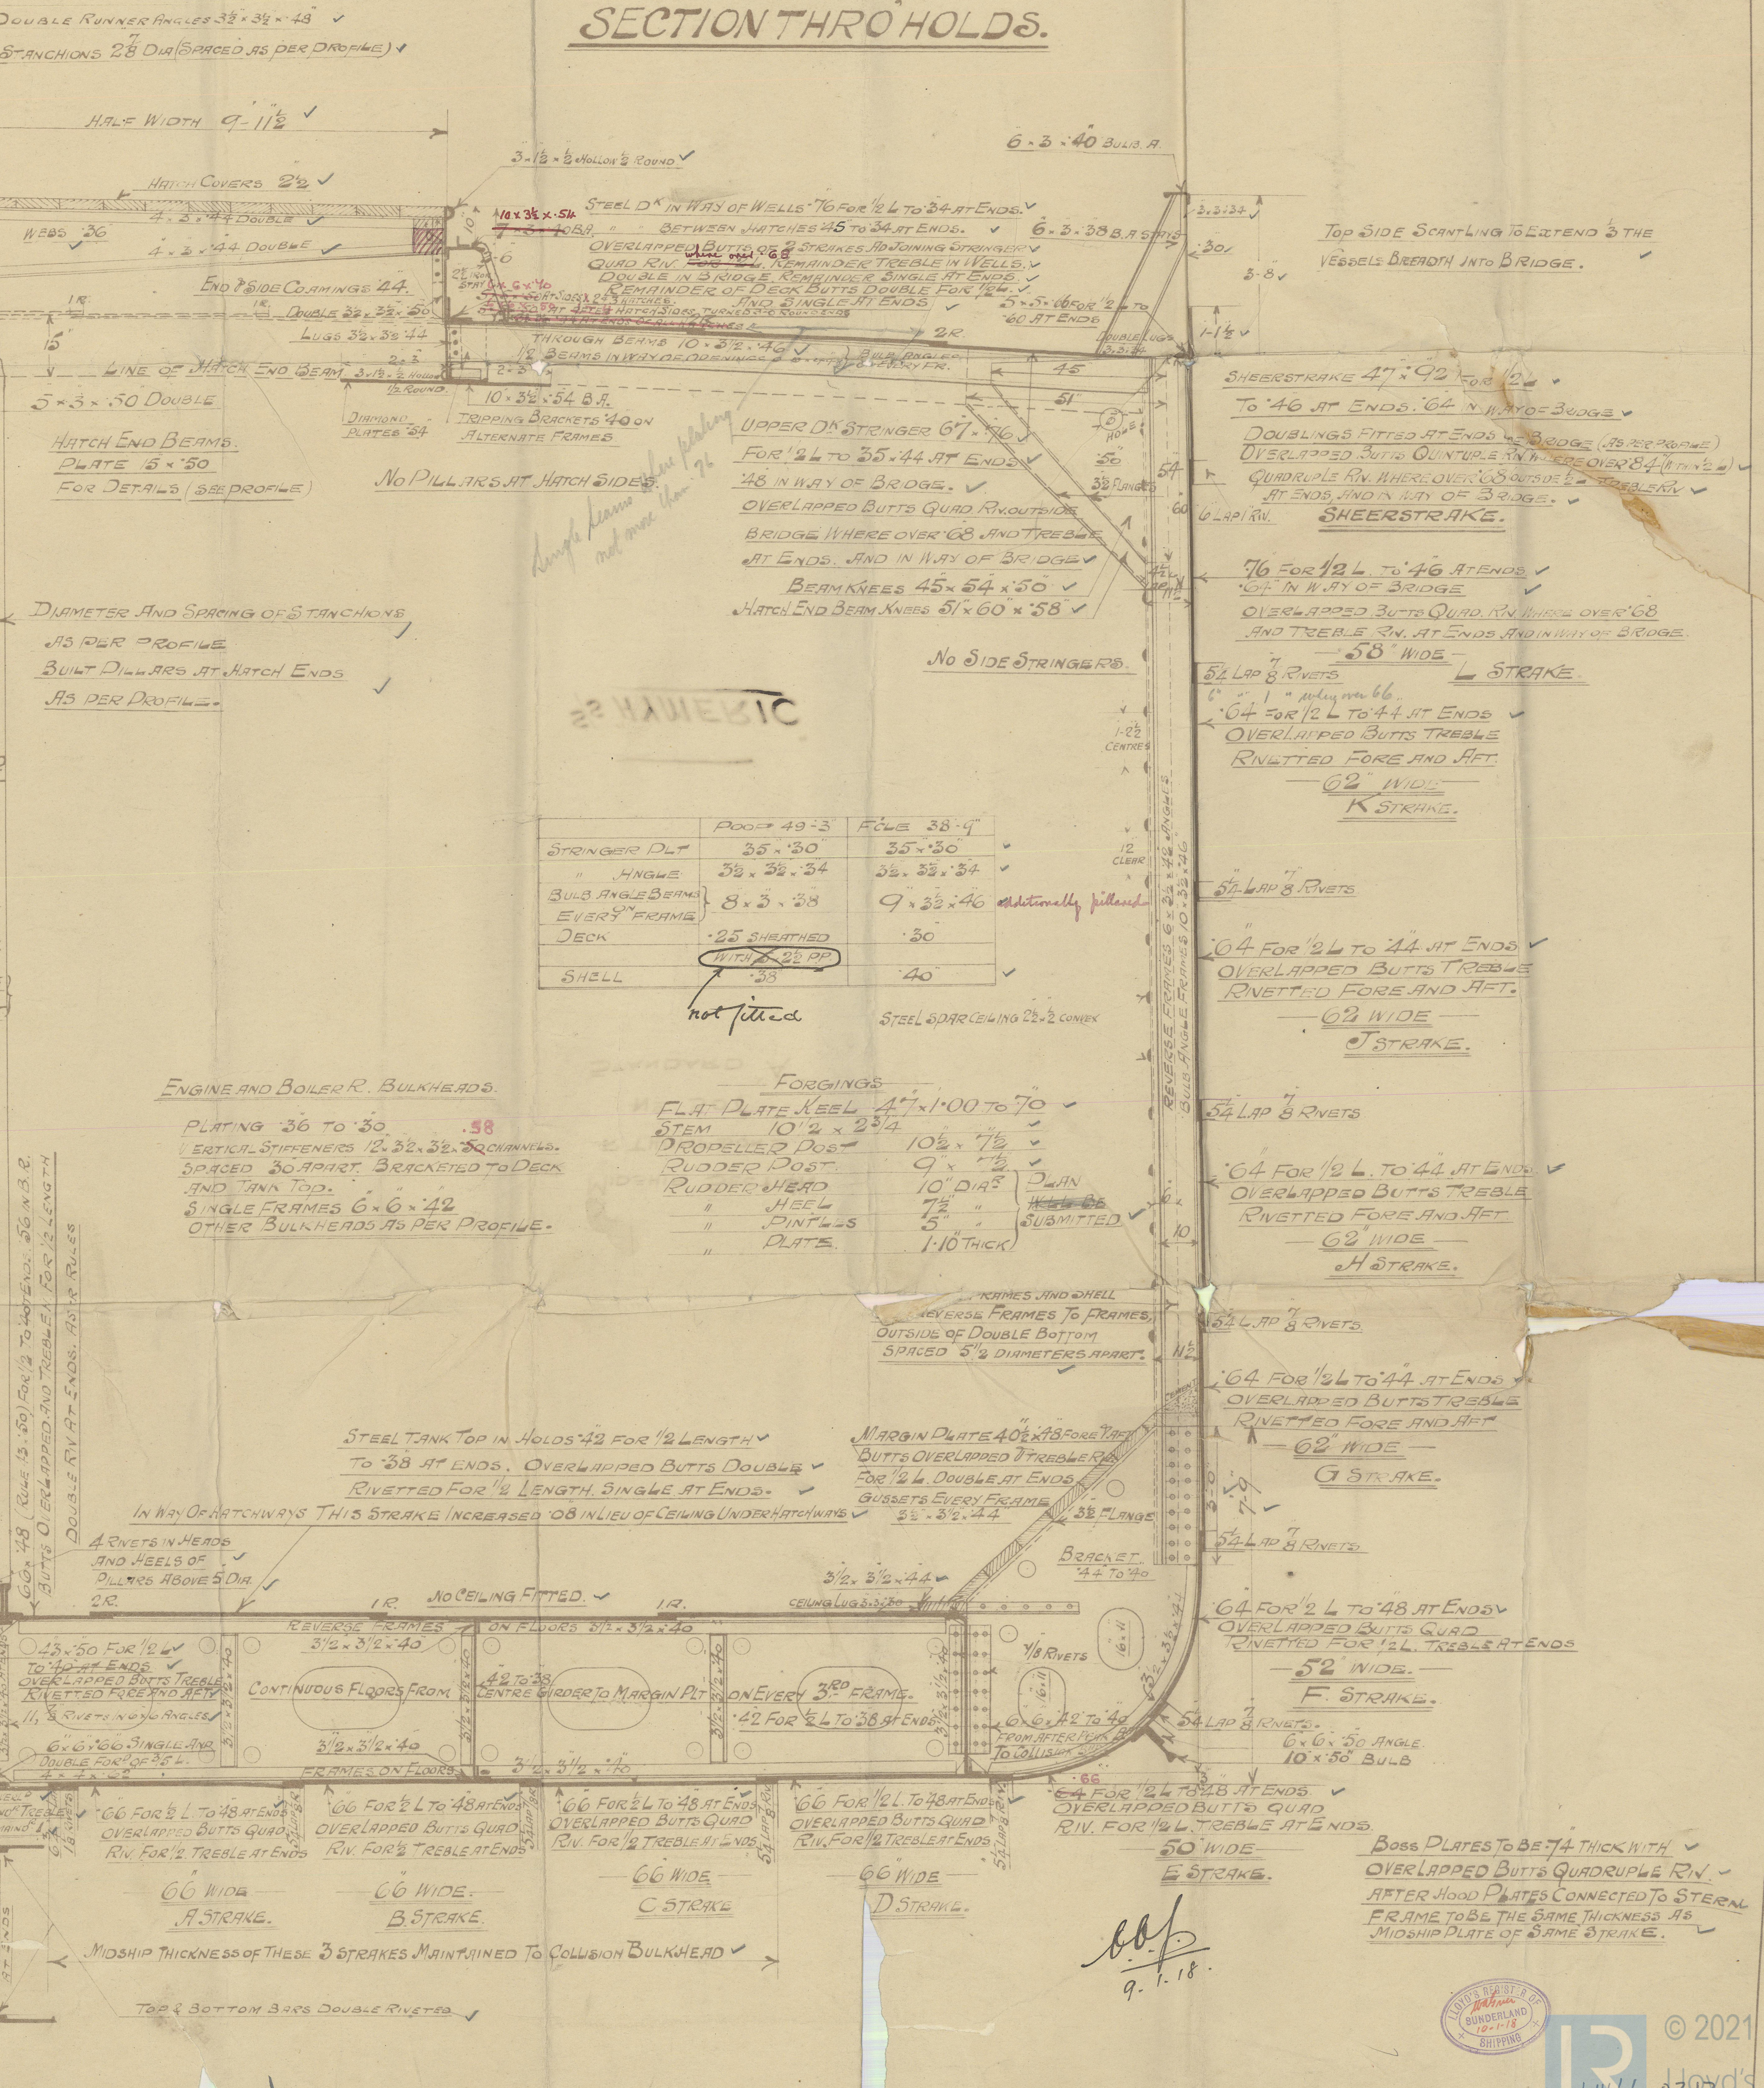

LLOYDS NUMERALS
 BREADTH 52'-0"
 DEPTH 31'-0"
 TRANSVERSE No 85-0
 400'-0"
 LONGITUDINAL No 33,200


EQUIPMENT No 33200 + ERECTIONS = 126 + 19 = 34719
 DECKHOUSE 126
 ENGINE & BOILER C^K 195

MIDSHIP SECTION

R. THOMPSONS

Nº 307.

STANDARD 'A'

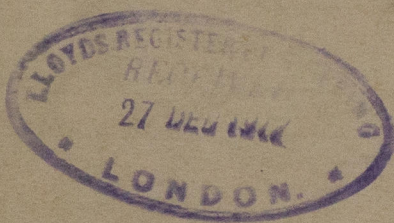

SUNDERLAND RPT. NO.

27424

~~"War Remains"~~

S/S "HYMERIC"

SUNDERLAND RPT. NO.

27532



© 2021

Lloyd's Register

Foundation
W1166-0212