
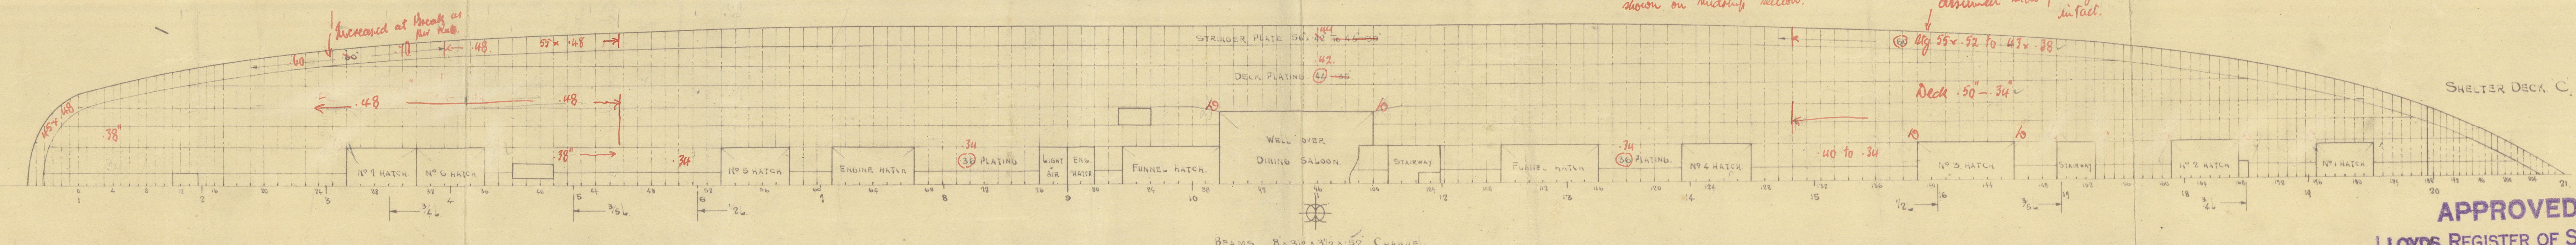
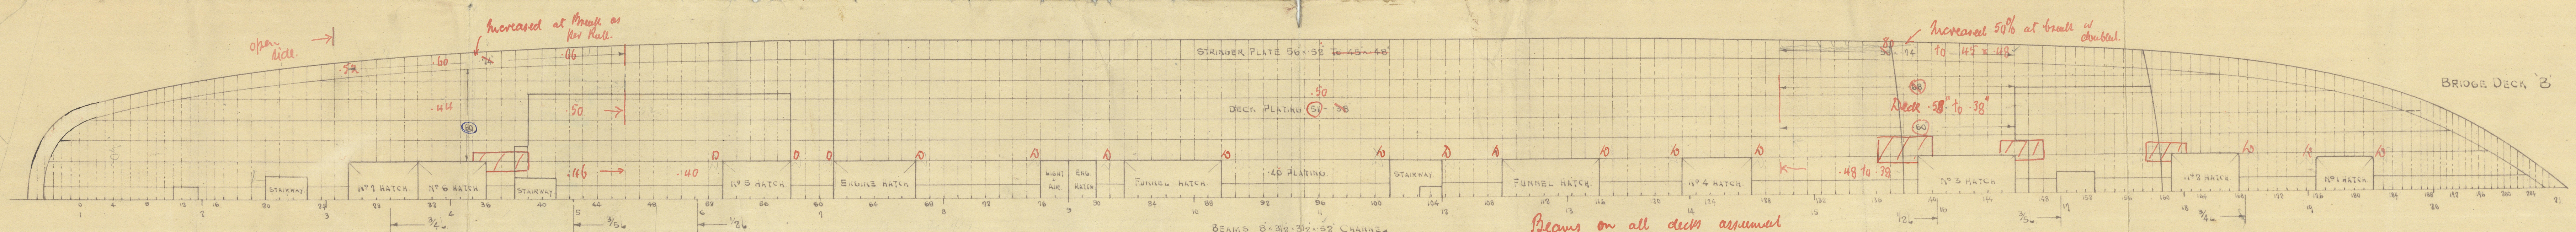
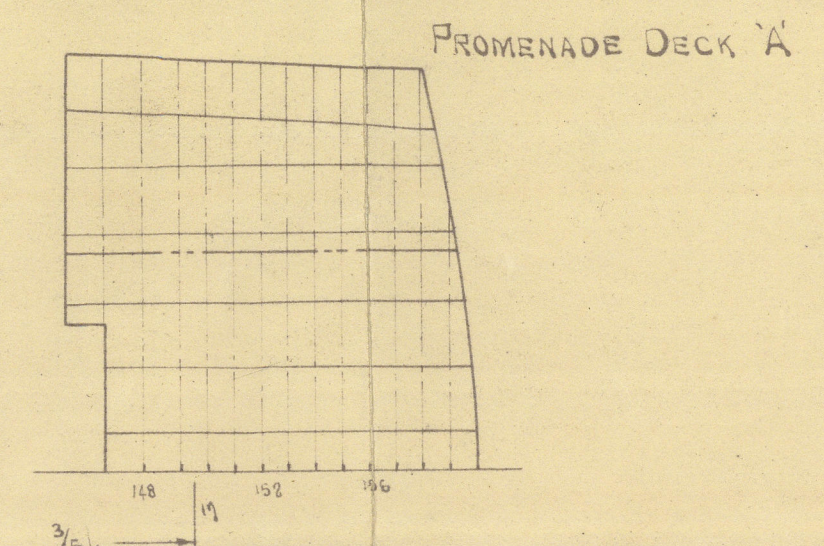
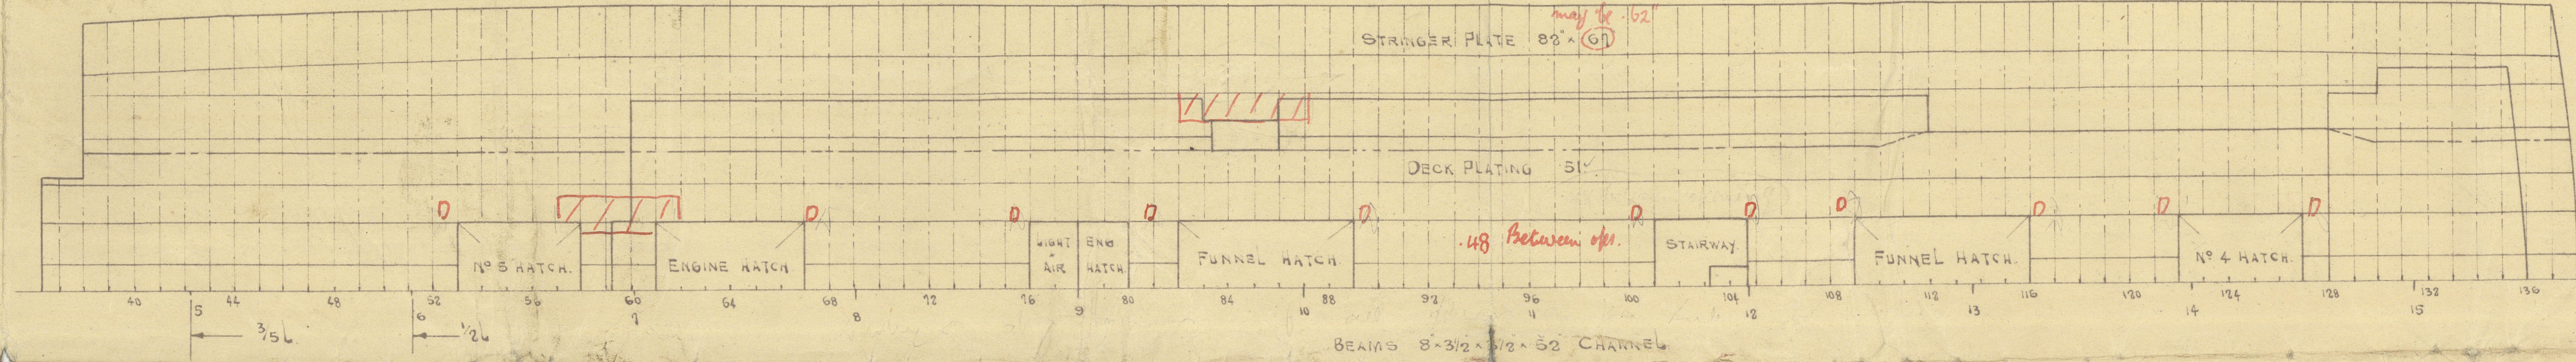


T.S.S. N° 648.
STEEL DECKS.
DIMENSIONS: 580-0 x 75-0 x 44-9 To 'C' DECK.
SCALE $\frac{1}{16}'' = 1 \text{ FT.}$

WILLIAM BERRIMORE & CO., LTD.
DESIGNING DEPT.
NUMBER 6204
DATE 1-7-26
EXAMINED BY *W.R.G.*
NAVAL CONSTRUCTION WORKS,
DALMUIR, N.B.

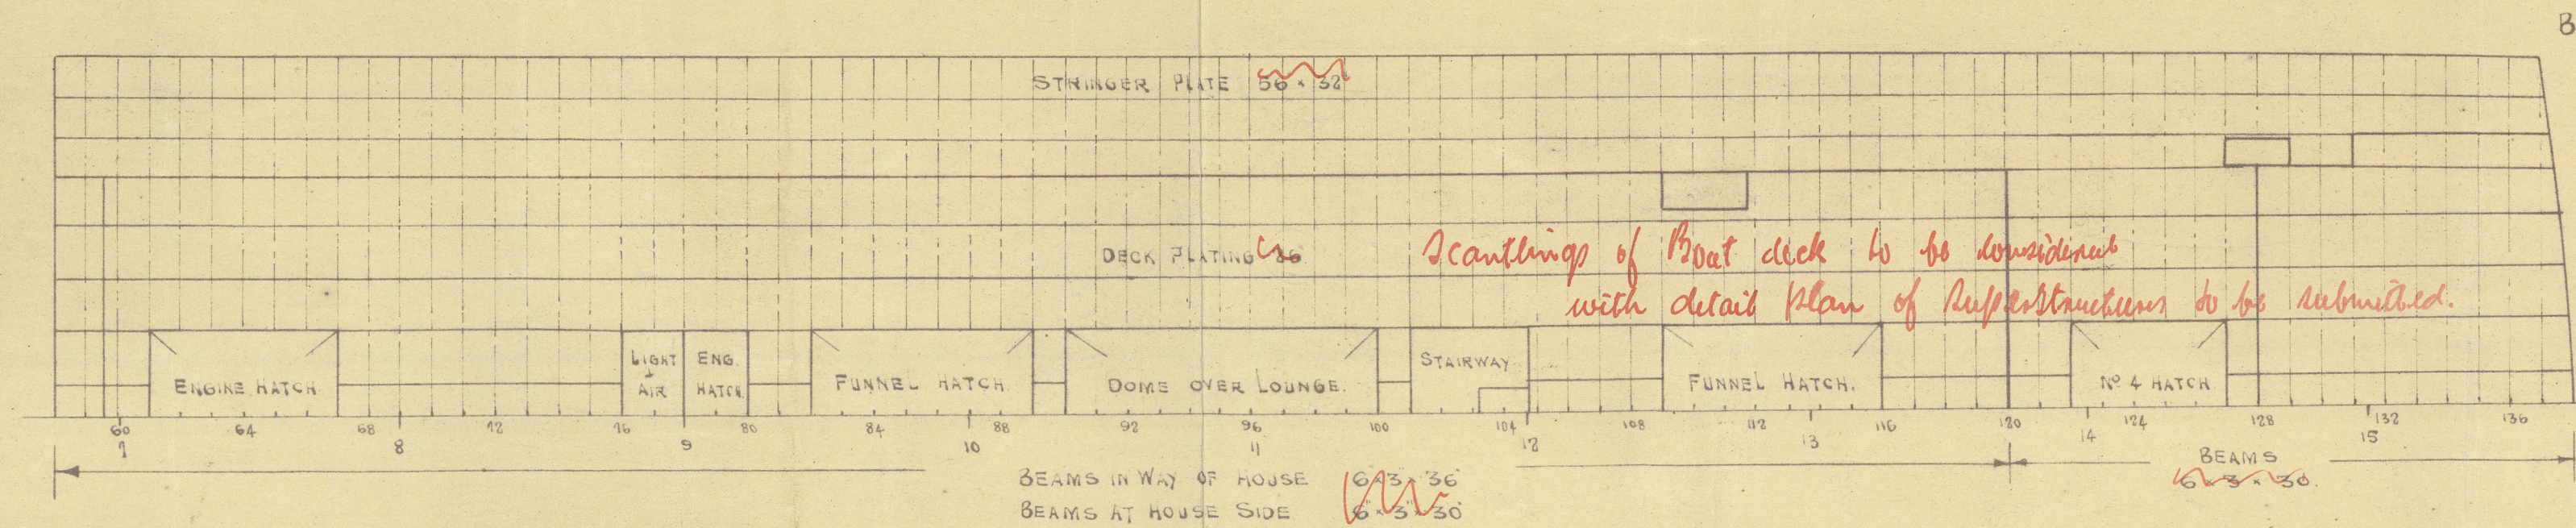

APPROVED
LLOYD'S REGISTER OF SHIPPING
Montgomery
DATE 9.9.26
Lloyd's Register
Foundation

RETAIN

A.B.C Decks

All decks above upper deck

Wm Beardmore Esq

648

Duchess of Atholl

Sl. 48074



© 2020

Lloyd's Register
Foundation

W1168-0309