


20.5.27

PLAN OF TANK TOP

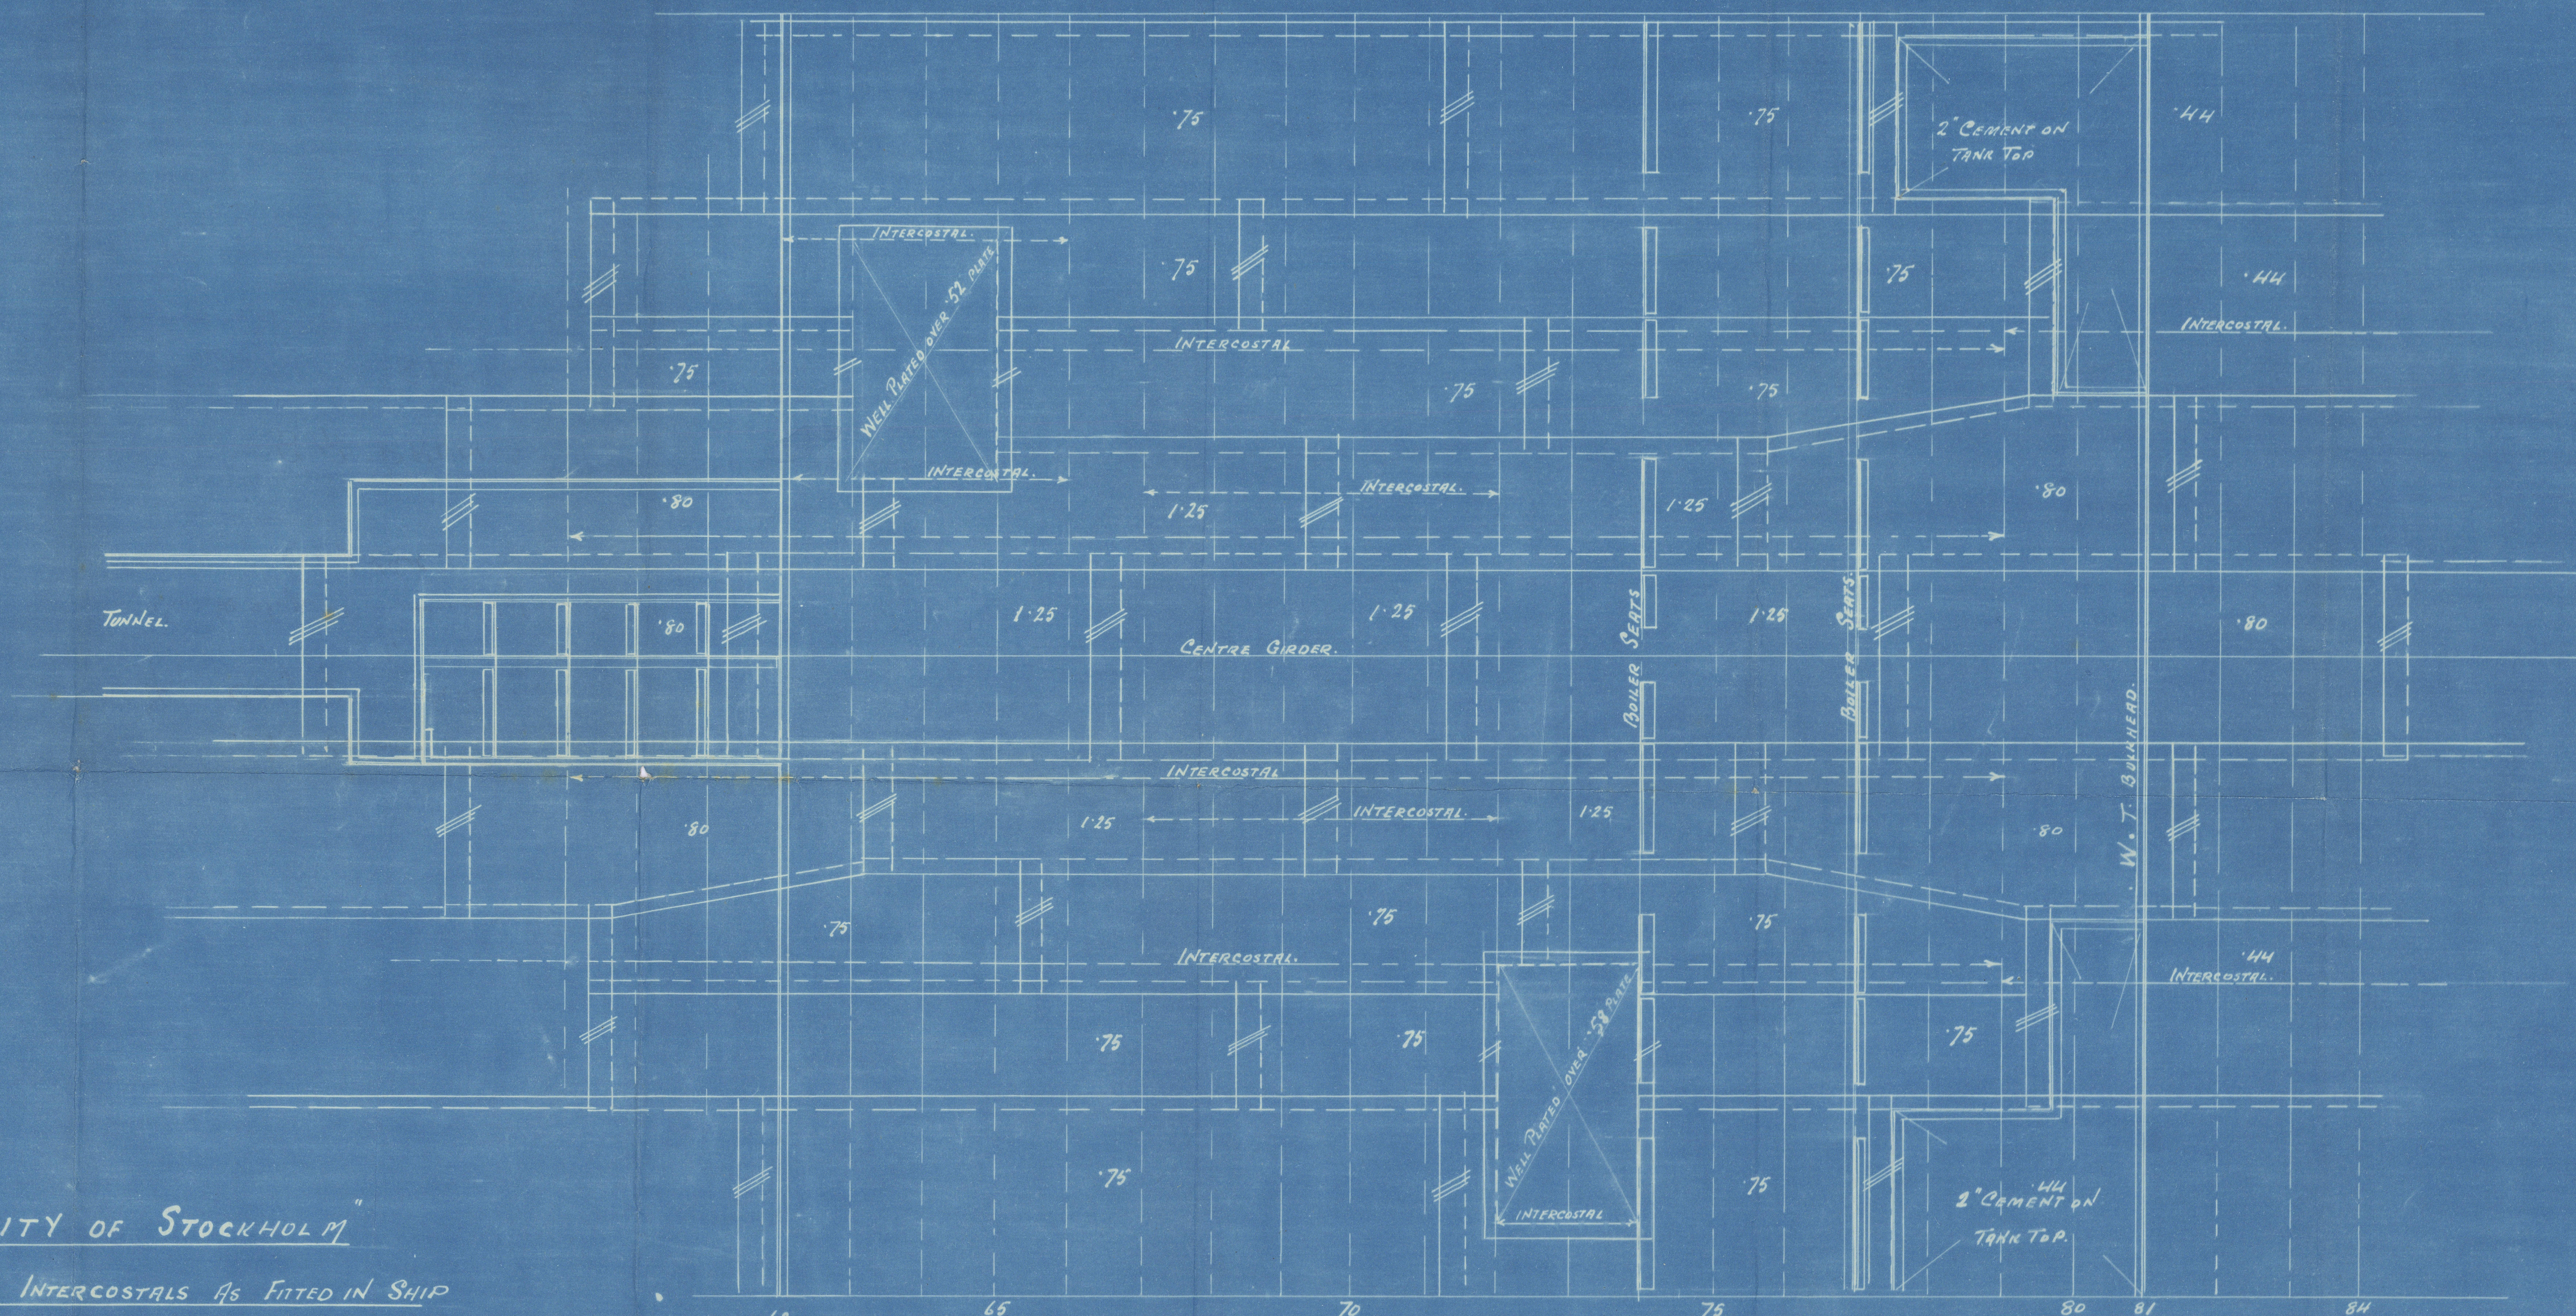

M.S. "CITY OF STOCKHOLM"

TANK TOP PLATING AND INTERCOSTALS AS FITTED IN SHIP


SCALE 1/4" = 1 FOOT

34955

13-5-27

1/16

ELEVATION OF TANK.

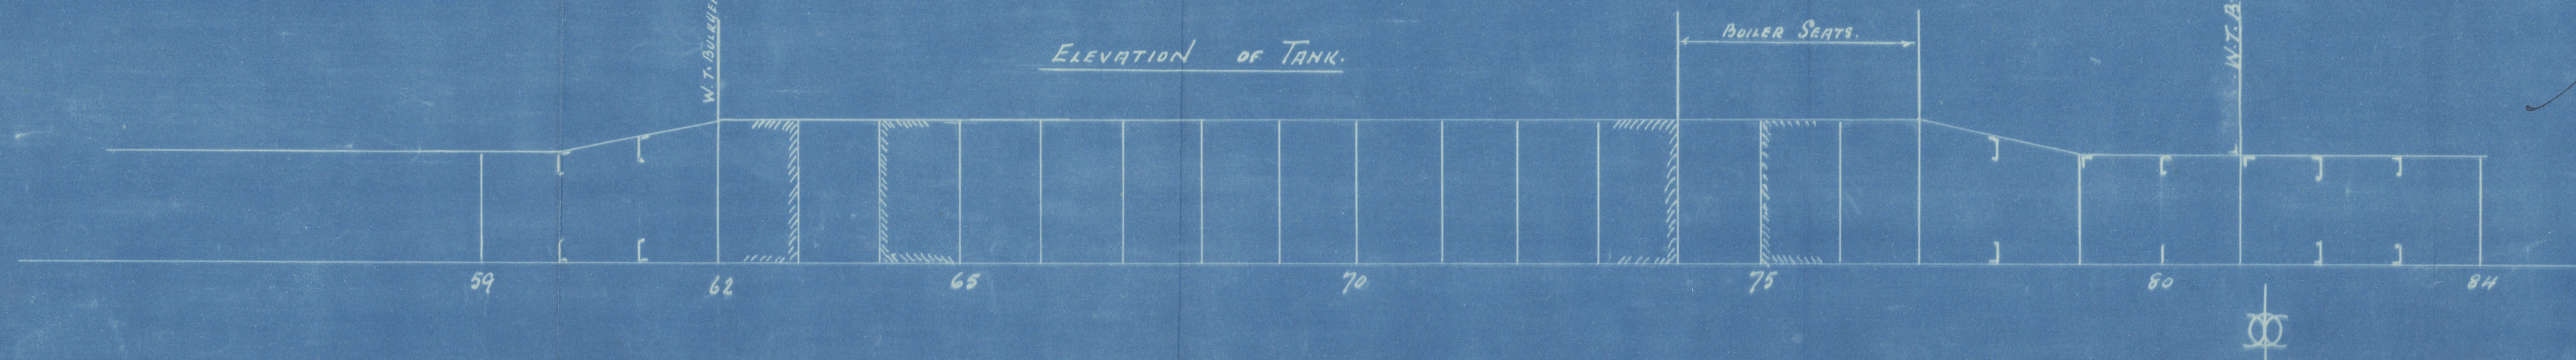

19.5.27



© 2021
Lloyd's Register
Foundation

cc S.S. Prunus 22
4 City of Stockholm.

_____ " _____
Tank Top & Intercostals in E.R.
(as fitted.)
_____ " _____

S.S. PRUNUS.
NEWCASTLE ON TYNE.
Report No. 81896.

W 117-0085



© 2021

Lloyd's Register
Foundation