

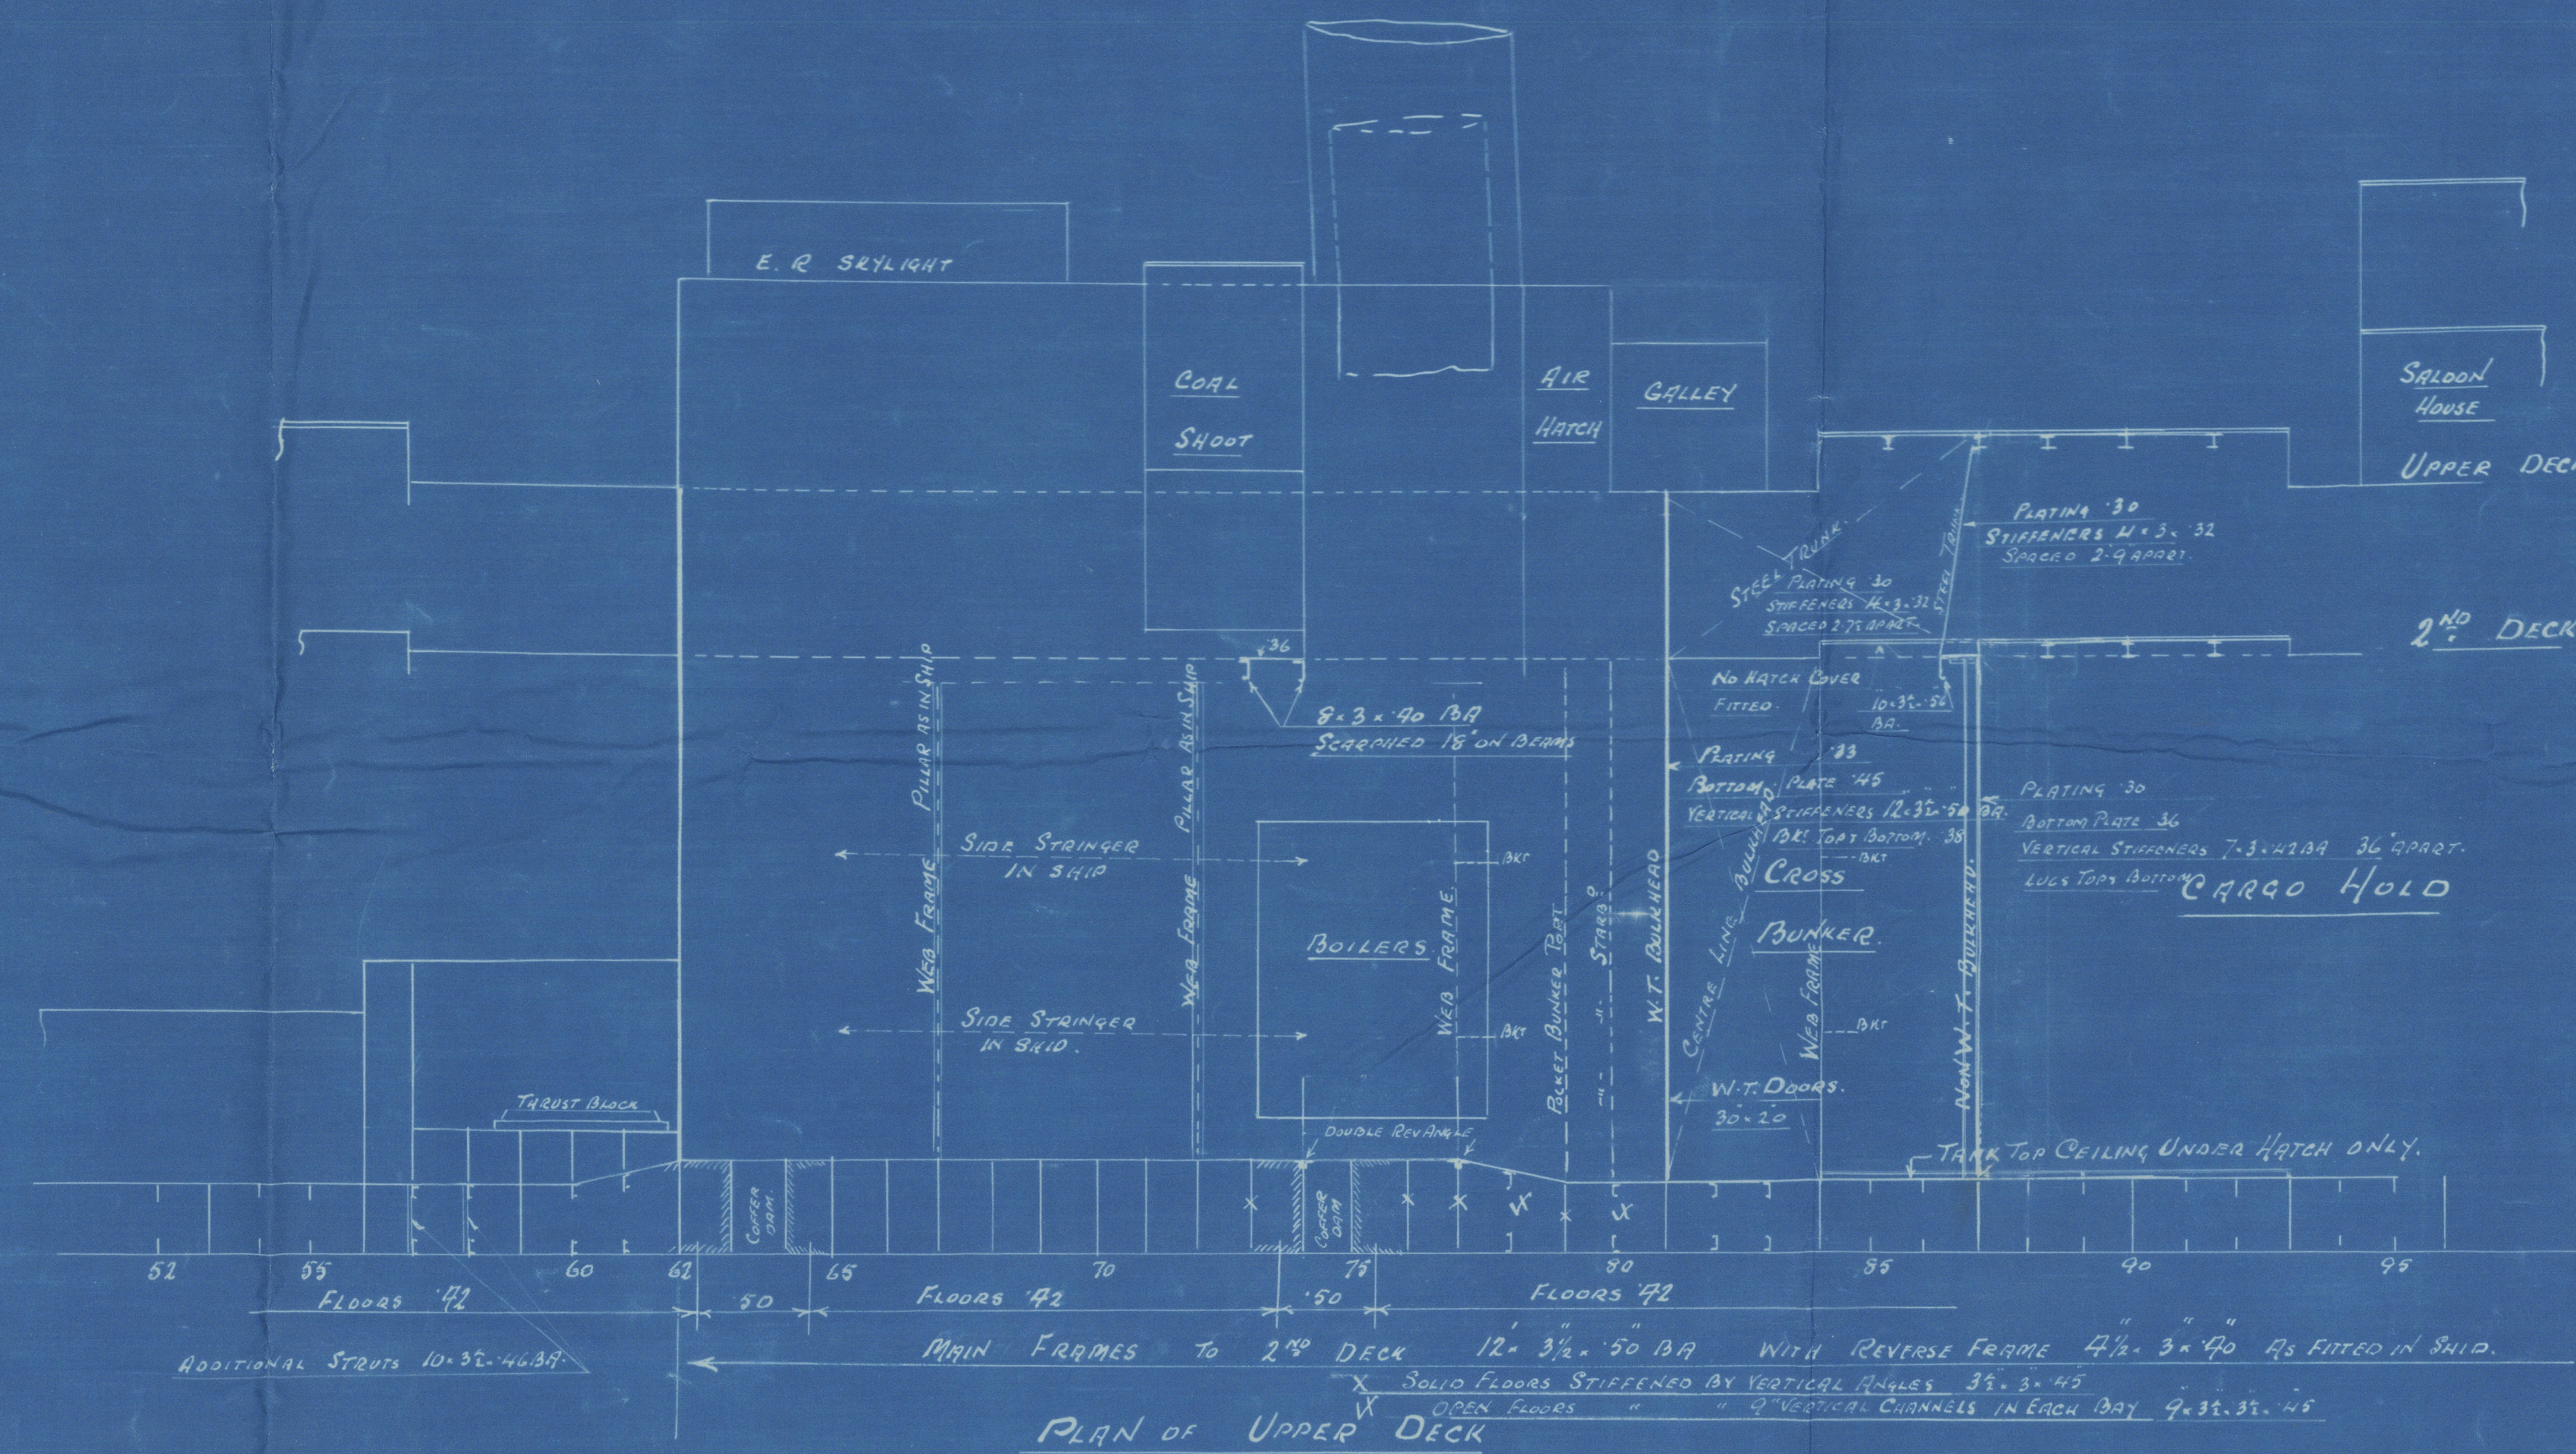


SECTION THRU THRUST SHAT
AT BRACKET FLOORS
SCALE 1/2" = 1 FOOT

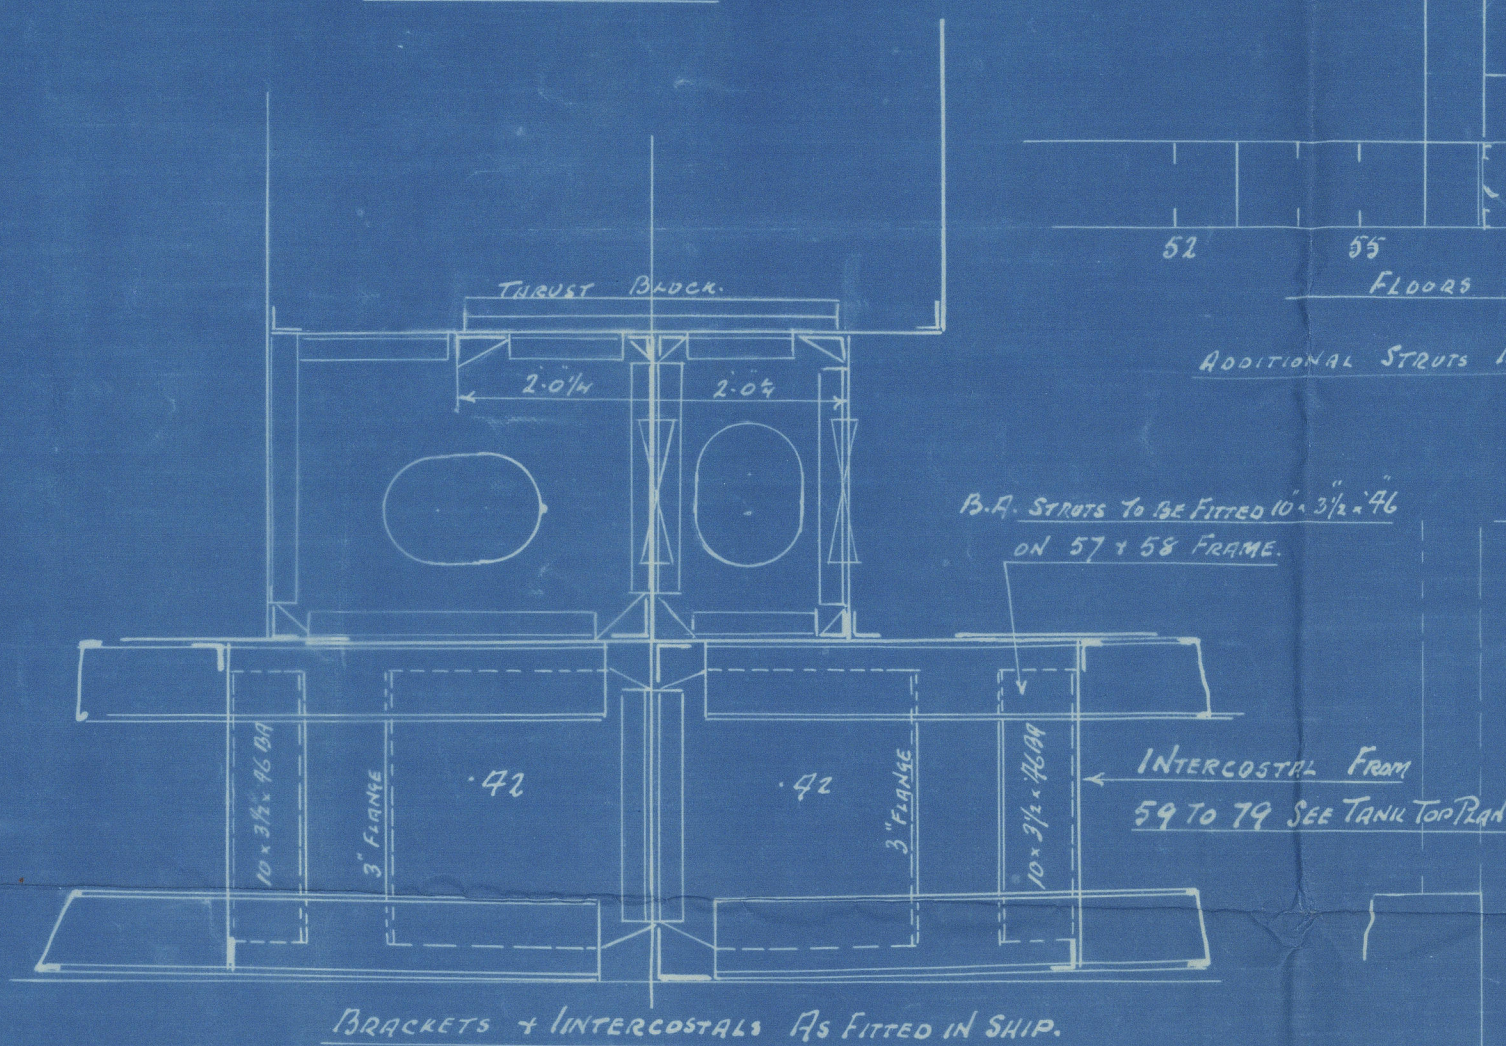


WEB FRAME ON
77 FRAME.


WING PLATE OF OLD BA
CUT DOWN TO FORM
WEB FRAME ON 77
FRAME.

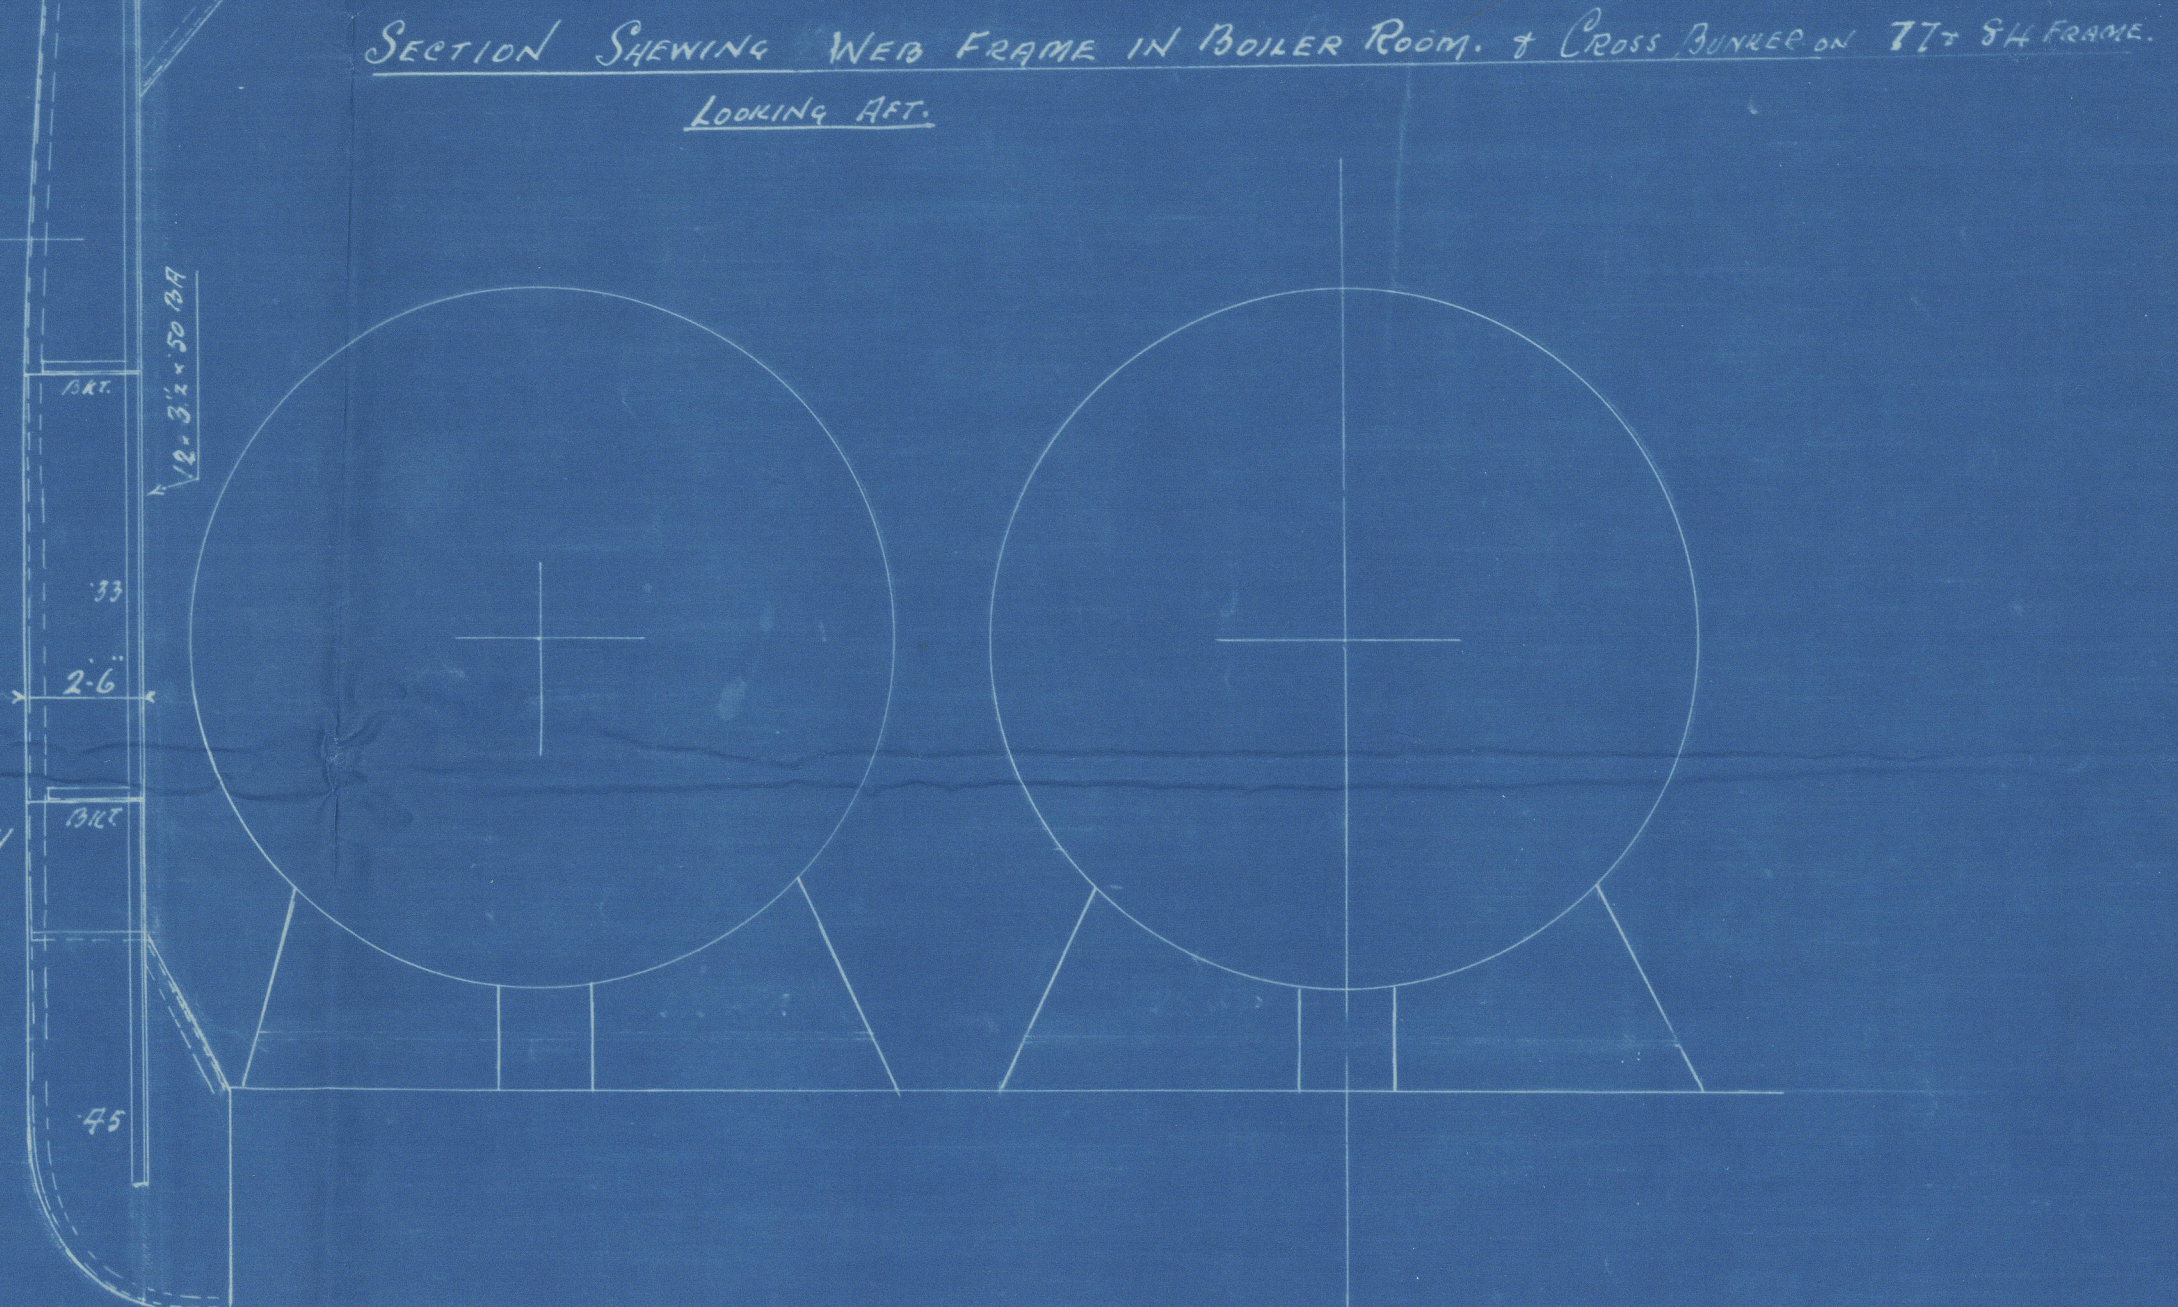

PLAN OF 2ND DECK

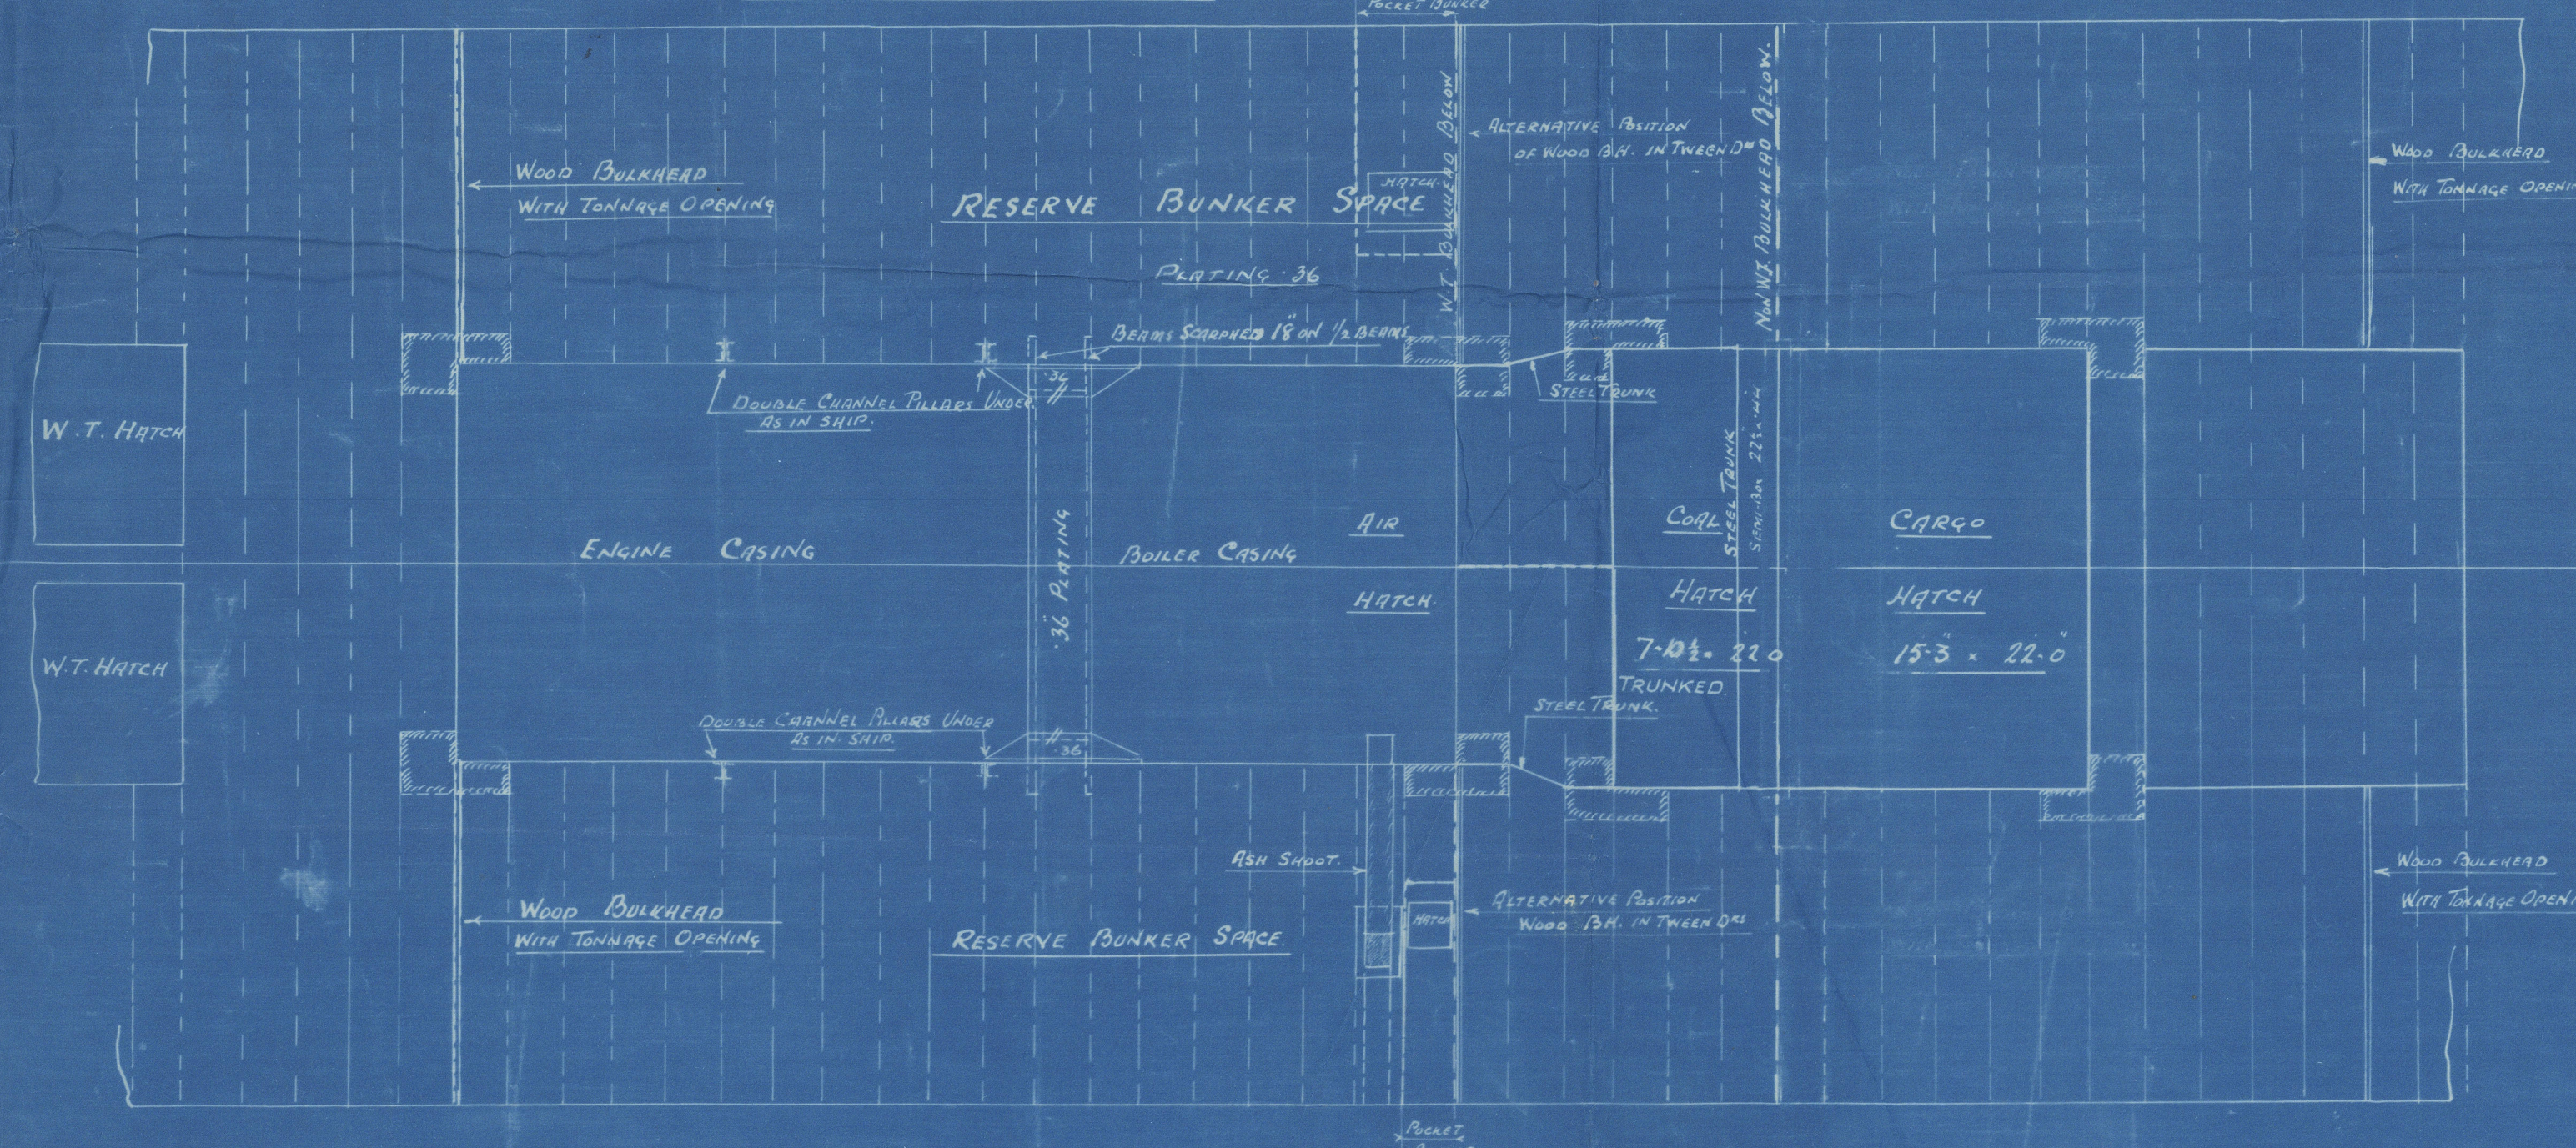

Nº 1246
M.S. "CITY OF STOCKHOLM."
MODIFICATION TO MACHINERY SPACE
SCALE 1/8" = 1 FOOT

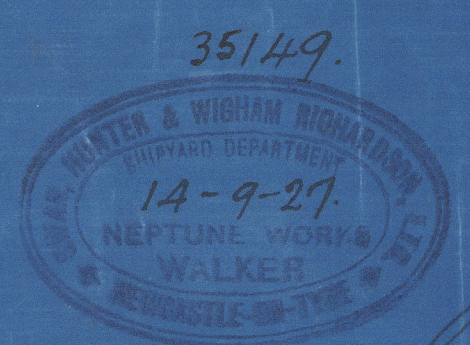

S.S. Prunus

City of Stockholm

Modification in way
machinery space

S.S. PRUNUS.
NEWCASTLE ON TYNE.

Report No. 81896.

W117-0087



© 2021

Lloyd's Register
Foundation