


Office Copy


W. T. BULKHEAD N° 81 (LOOKING AFT)

BULKHEAD FRAME  
3' LAP


BULK + REVERSE FRAME CUT OFF full  
+ 134 PLATING LAPS + FRAMES WELDED  
JEE OF FRAME BOLCAULDED  
W. T. shales to be fitted  
Bld. made W. T. 6 Summerson  
submarine

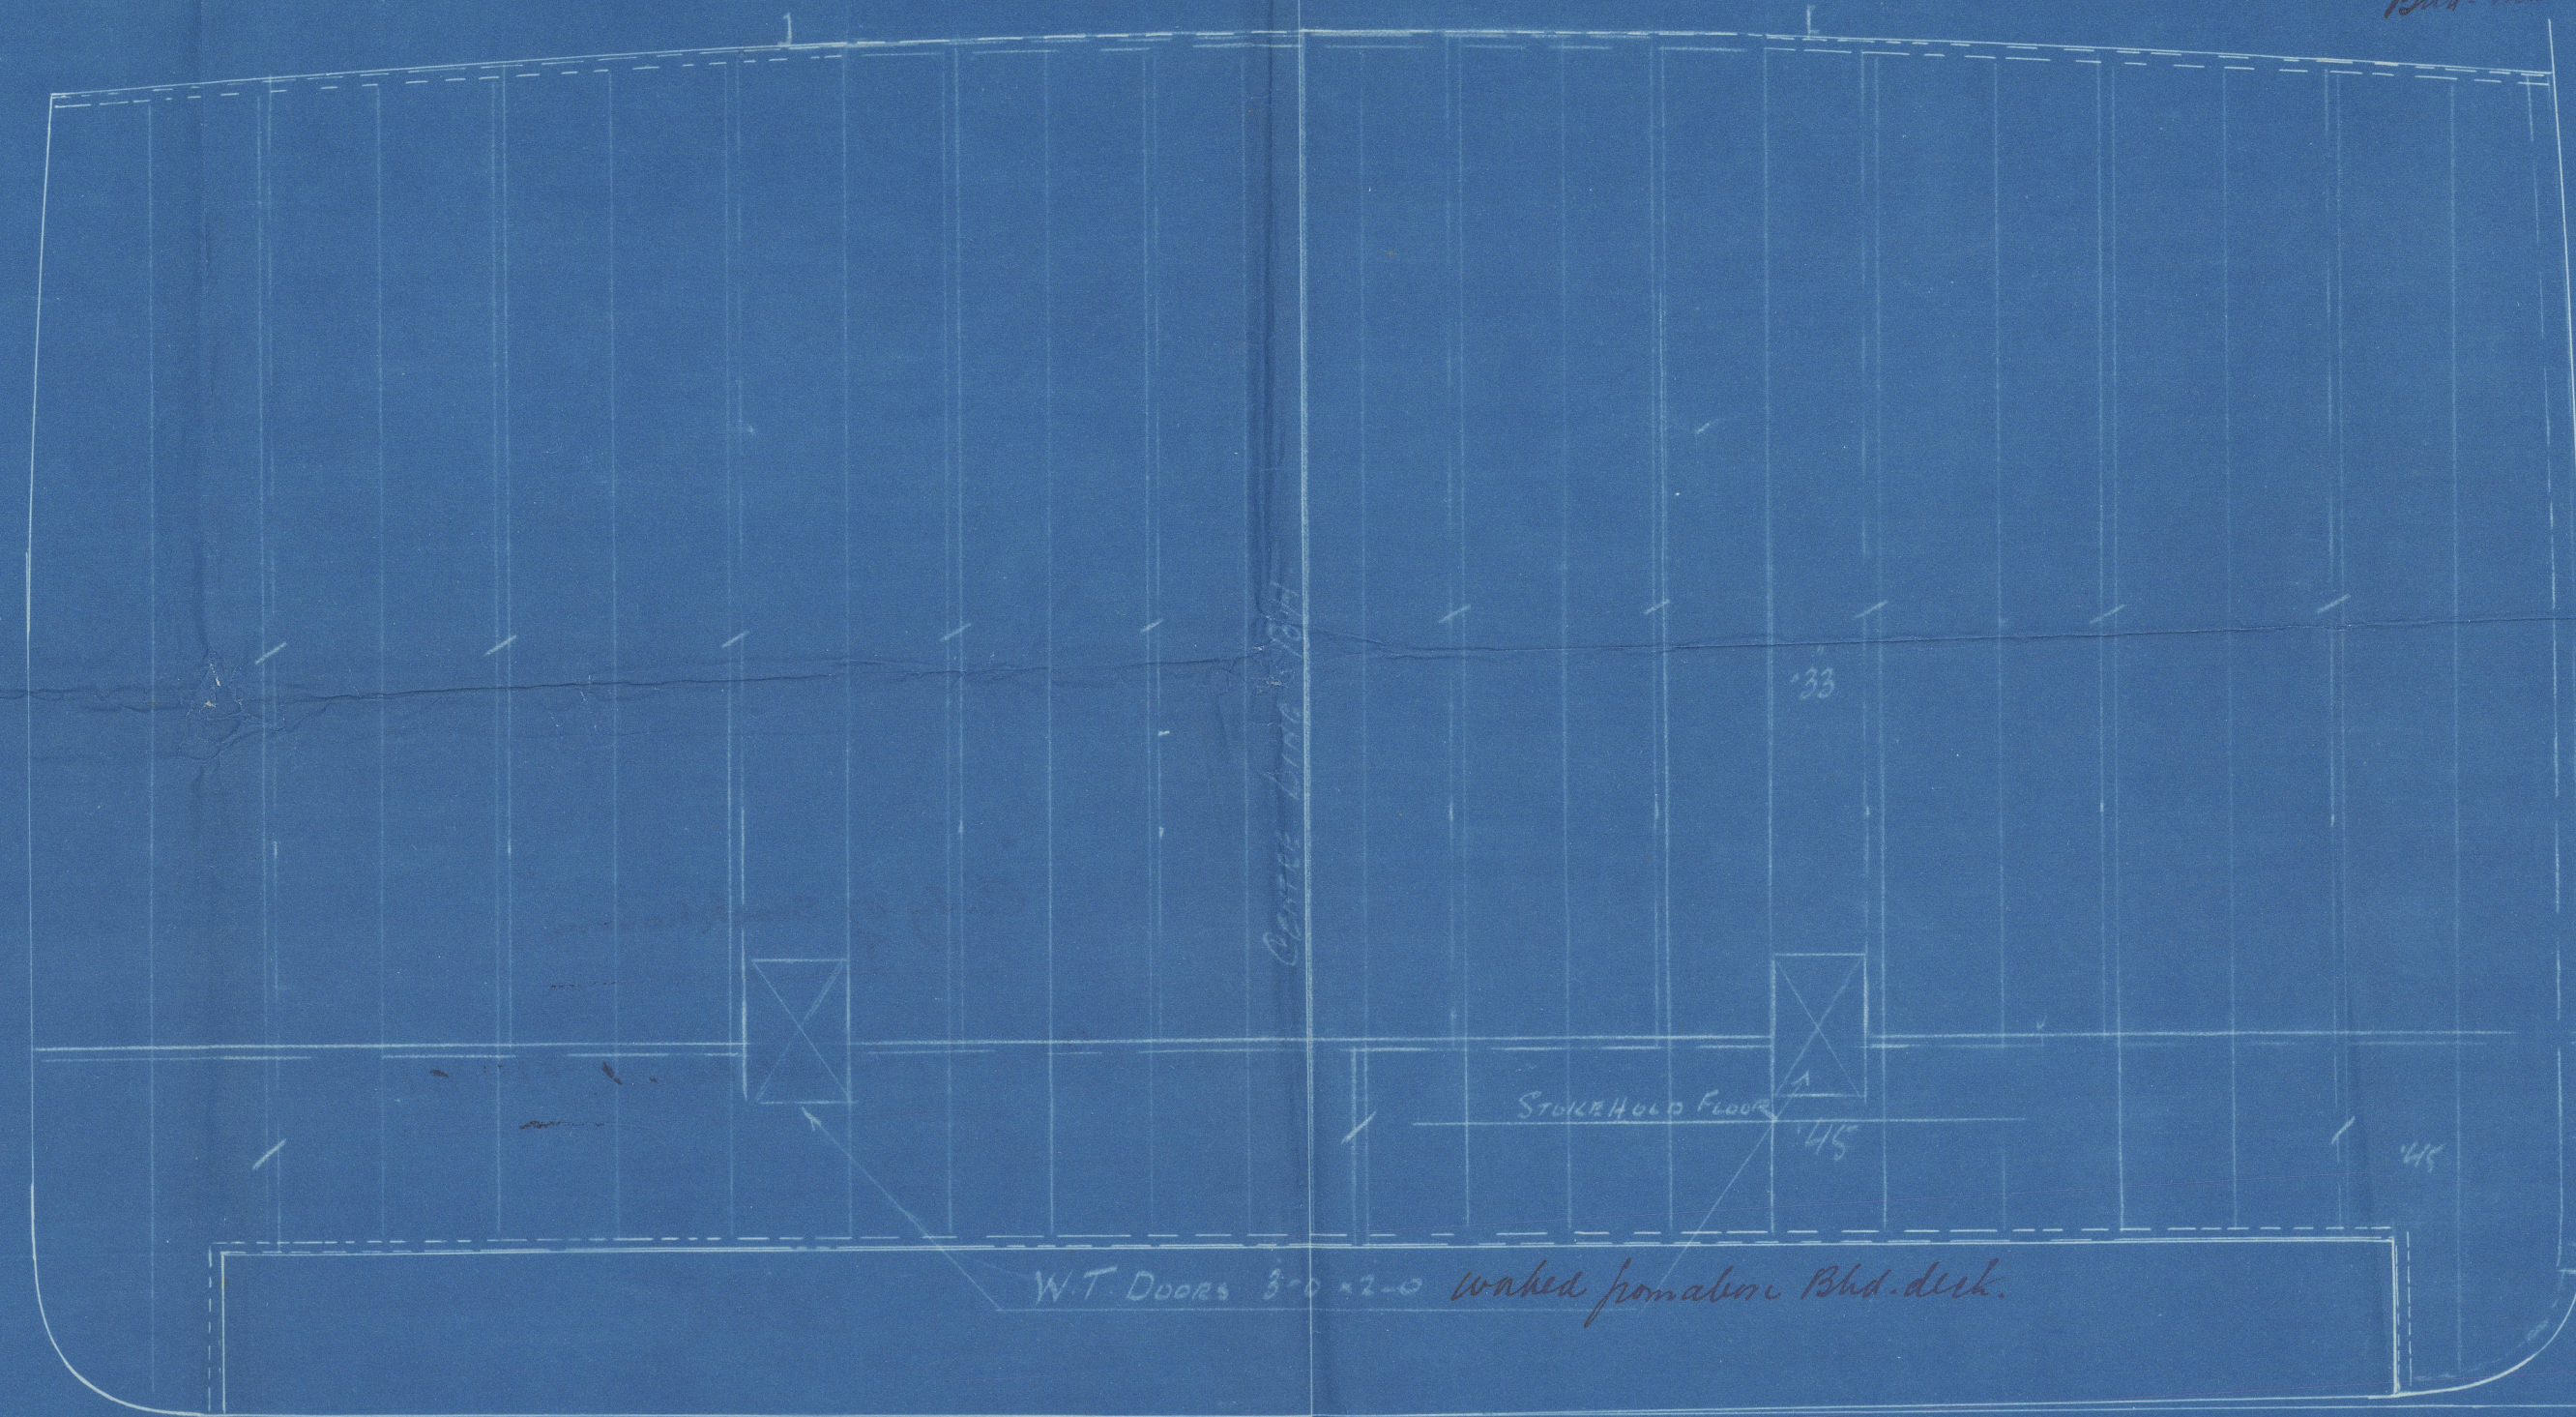

12-3 1/2 - 50 BA STIFFENERS WITH BOLCAULDED  
TOP + BOTTOM 2 1/2" FLANGES  
2 1/2" ON FACE = 7-7/8 CENTS

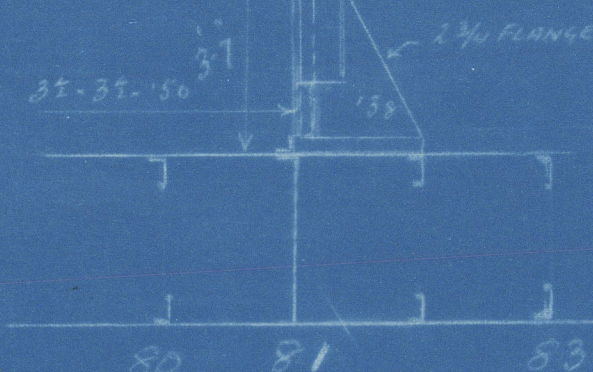


NON-W.T. BULKHEAD N° 87  
LOOKING FORWARD

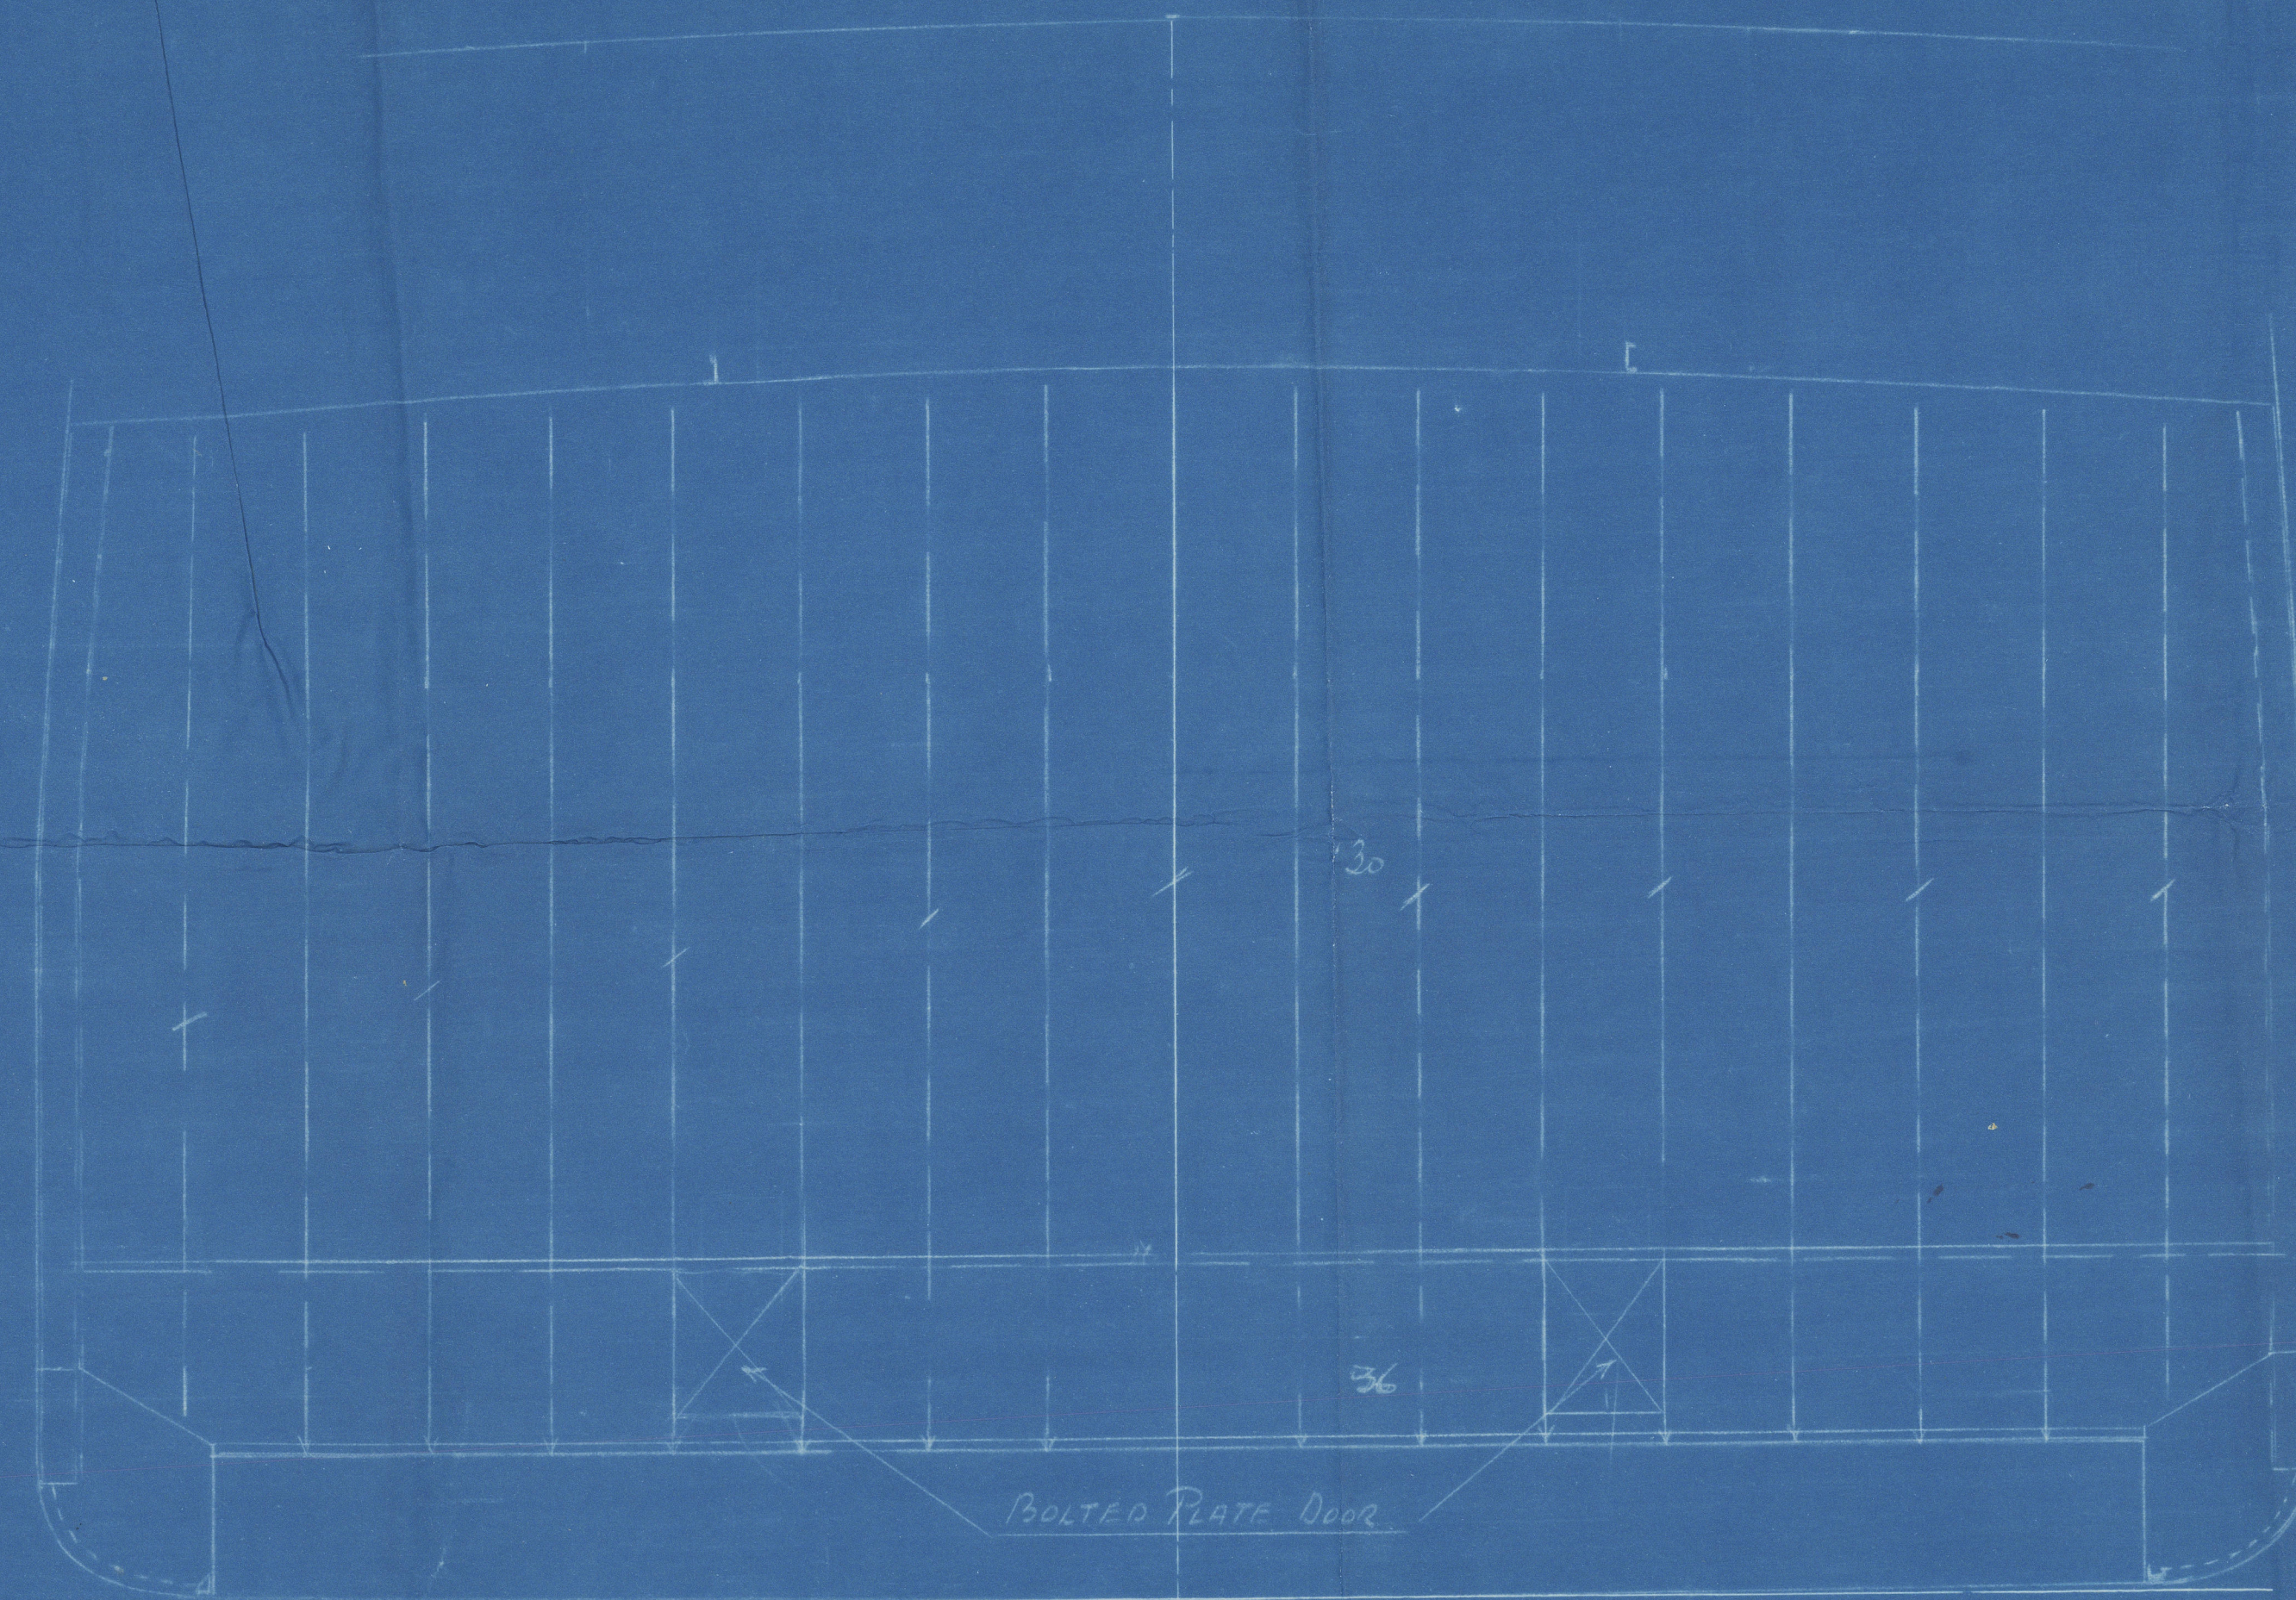

STIFFENERS 7-3-42  
TANK TOP

Stiffeners dugged to bottom

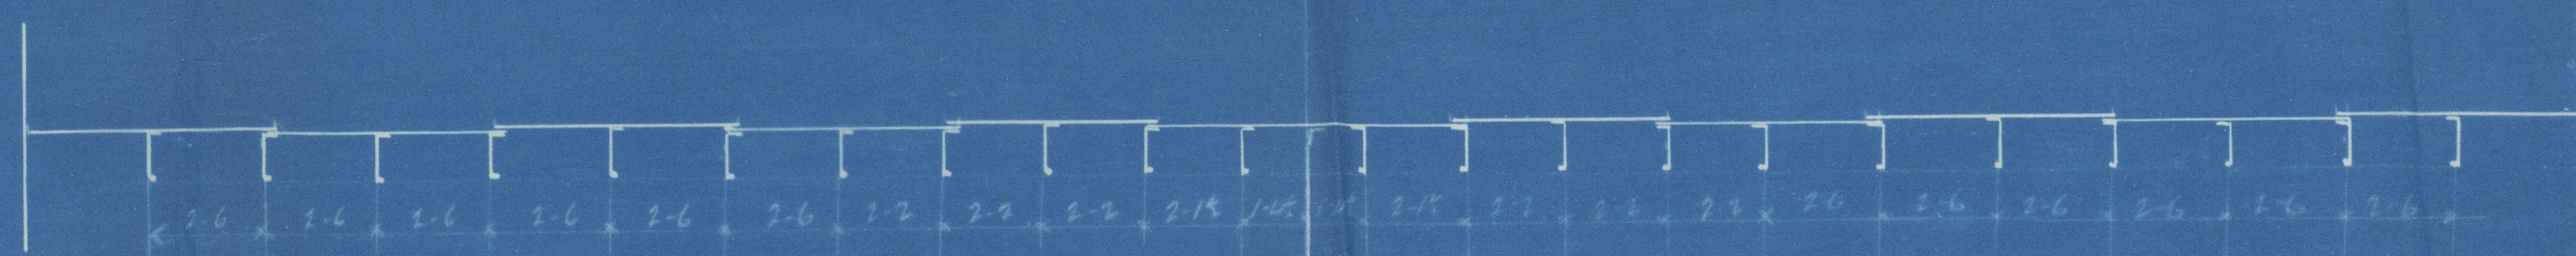

M. S. "CITY OF STOCKHOLM"  
BULKHEAD PLAN  
SCALE 1/4" = 1 FOOT

34853

13-5-27

W. T.

W. T.  
19-5-27.



"  
City of Stockholm."  
" "

W. J. Bulkhead No 81  
" "

X1117-0088



© 2021

Lloyd's Register  
Foundation