


PLAN OF TANK TOP


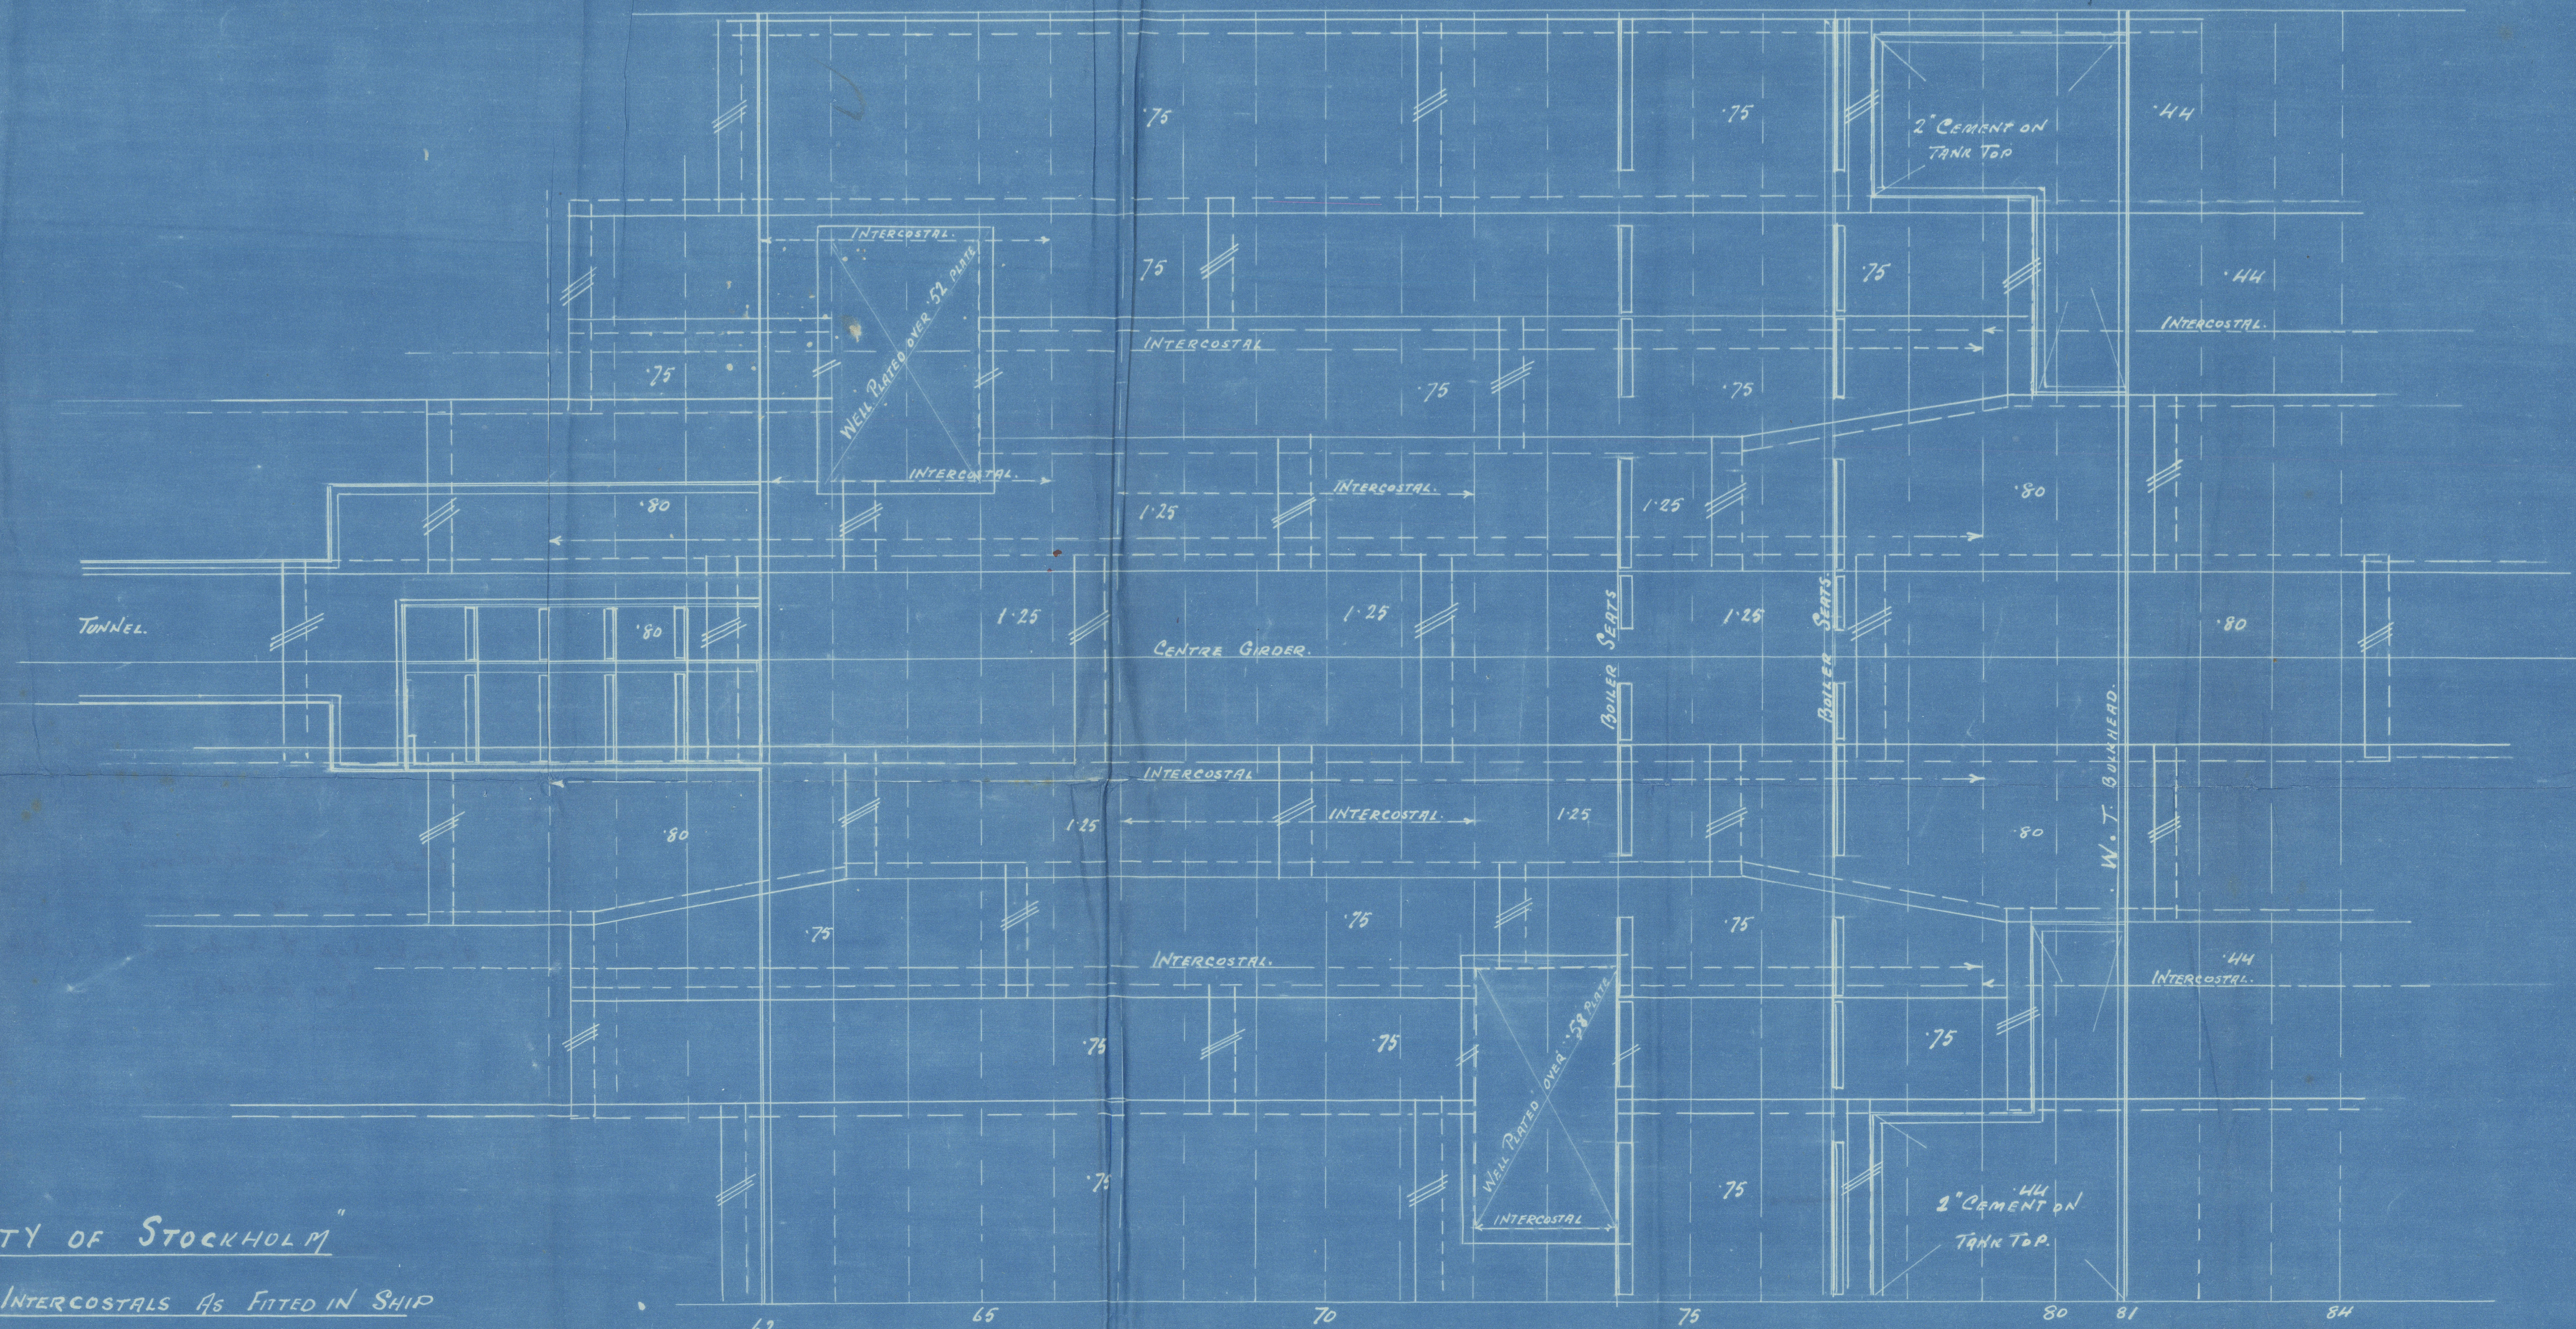


M.S. "CITY OF STOCKHOLM"

TANK TOP PLATING AND INTERCOSTALS AS FITTED IN SHIP

SCALE 1/4" = 1 FOOT

34855

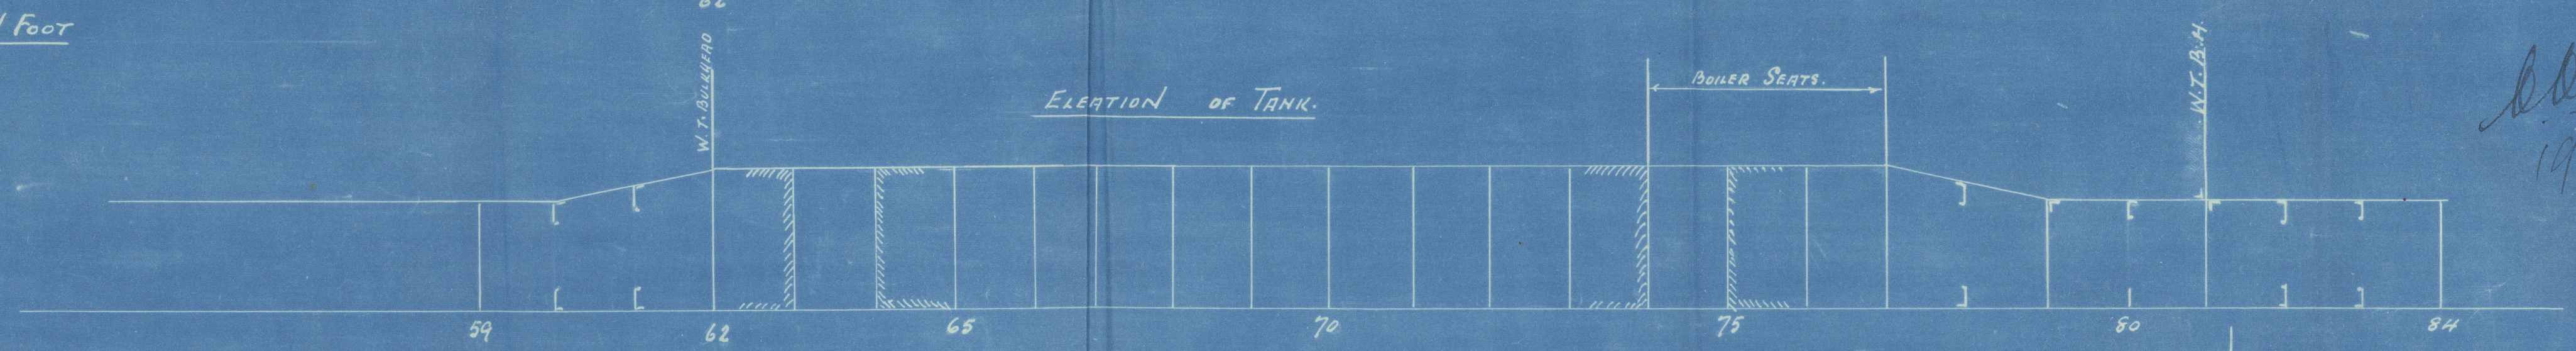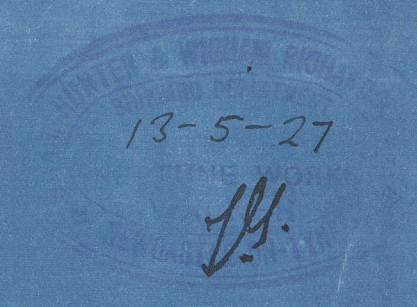


Handwritten signature and date:
19. 4. 27.

"
City of Stockholm."
"

Tank Top + Intercostals in E.R.
(as fitted)
"

W117-0091

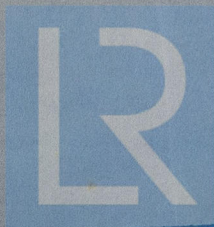

© 2021

Lloyd's Register
Foundation