

T.S.S. N° 525

PROFILE & DECKS

SCALE: 1/8" = 1 FOOT


MOULDED DIMENSIONS 280'-0" B.P. x 41'-0" x 17'-0" TO MAIN DECK; 24'-8" TO PROMDE. DK.
TO CLASS 100A.1 WITH FREEBOARD CORRESPONDING TO A MOULDED DRAFT OF 13'-6"

*For Channel Service, Weymouth and Channel Islands
and Irish Channel Service.*

ALEXANDER STEPHEN & SONS, LTD.
SHIPBUILDERS & ENGINEERS

GLASGOW

LAN NO 2 18.4.29
SHIPYARD DEPARTMENT

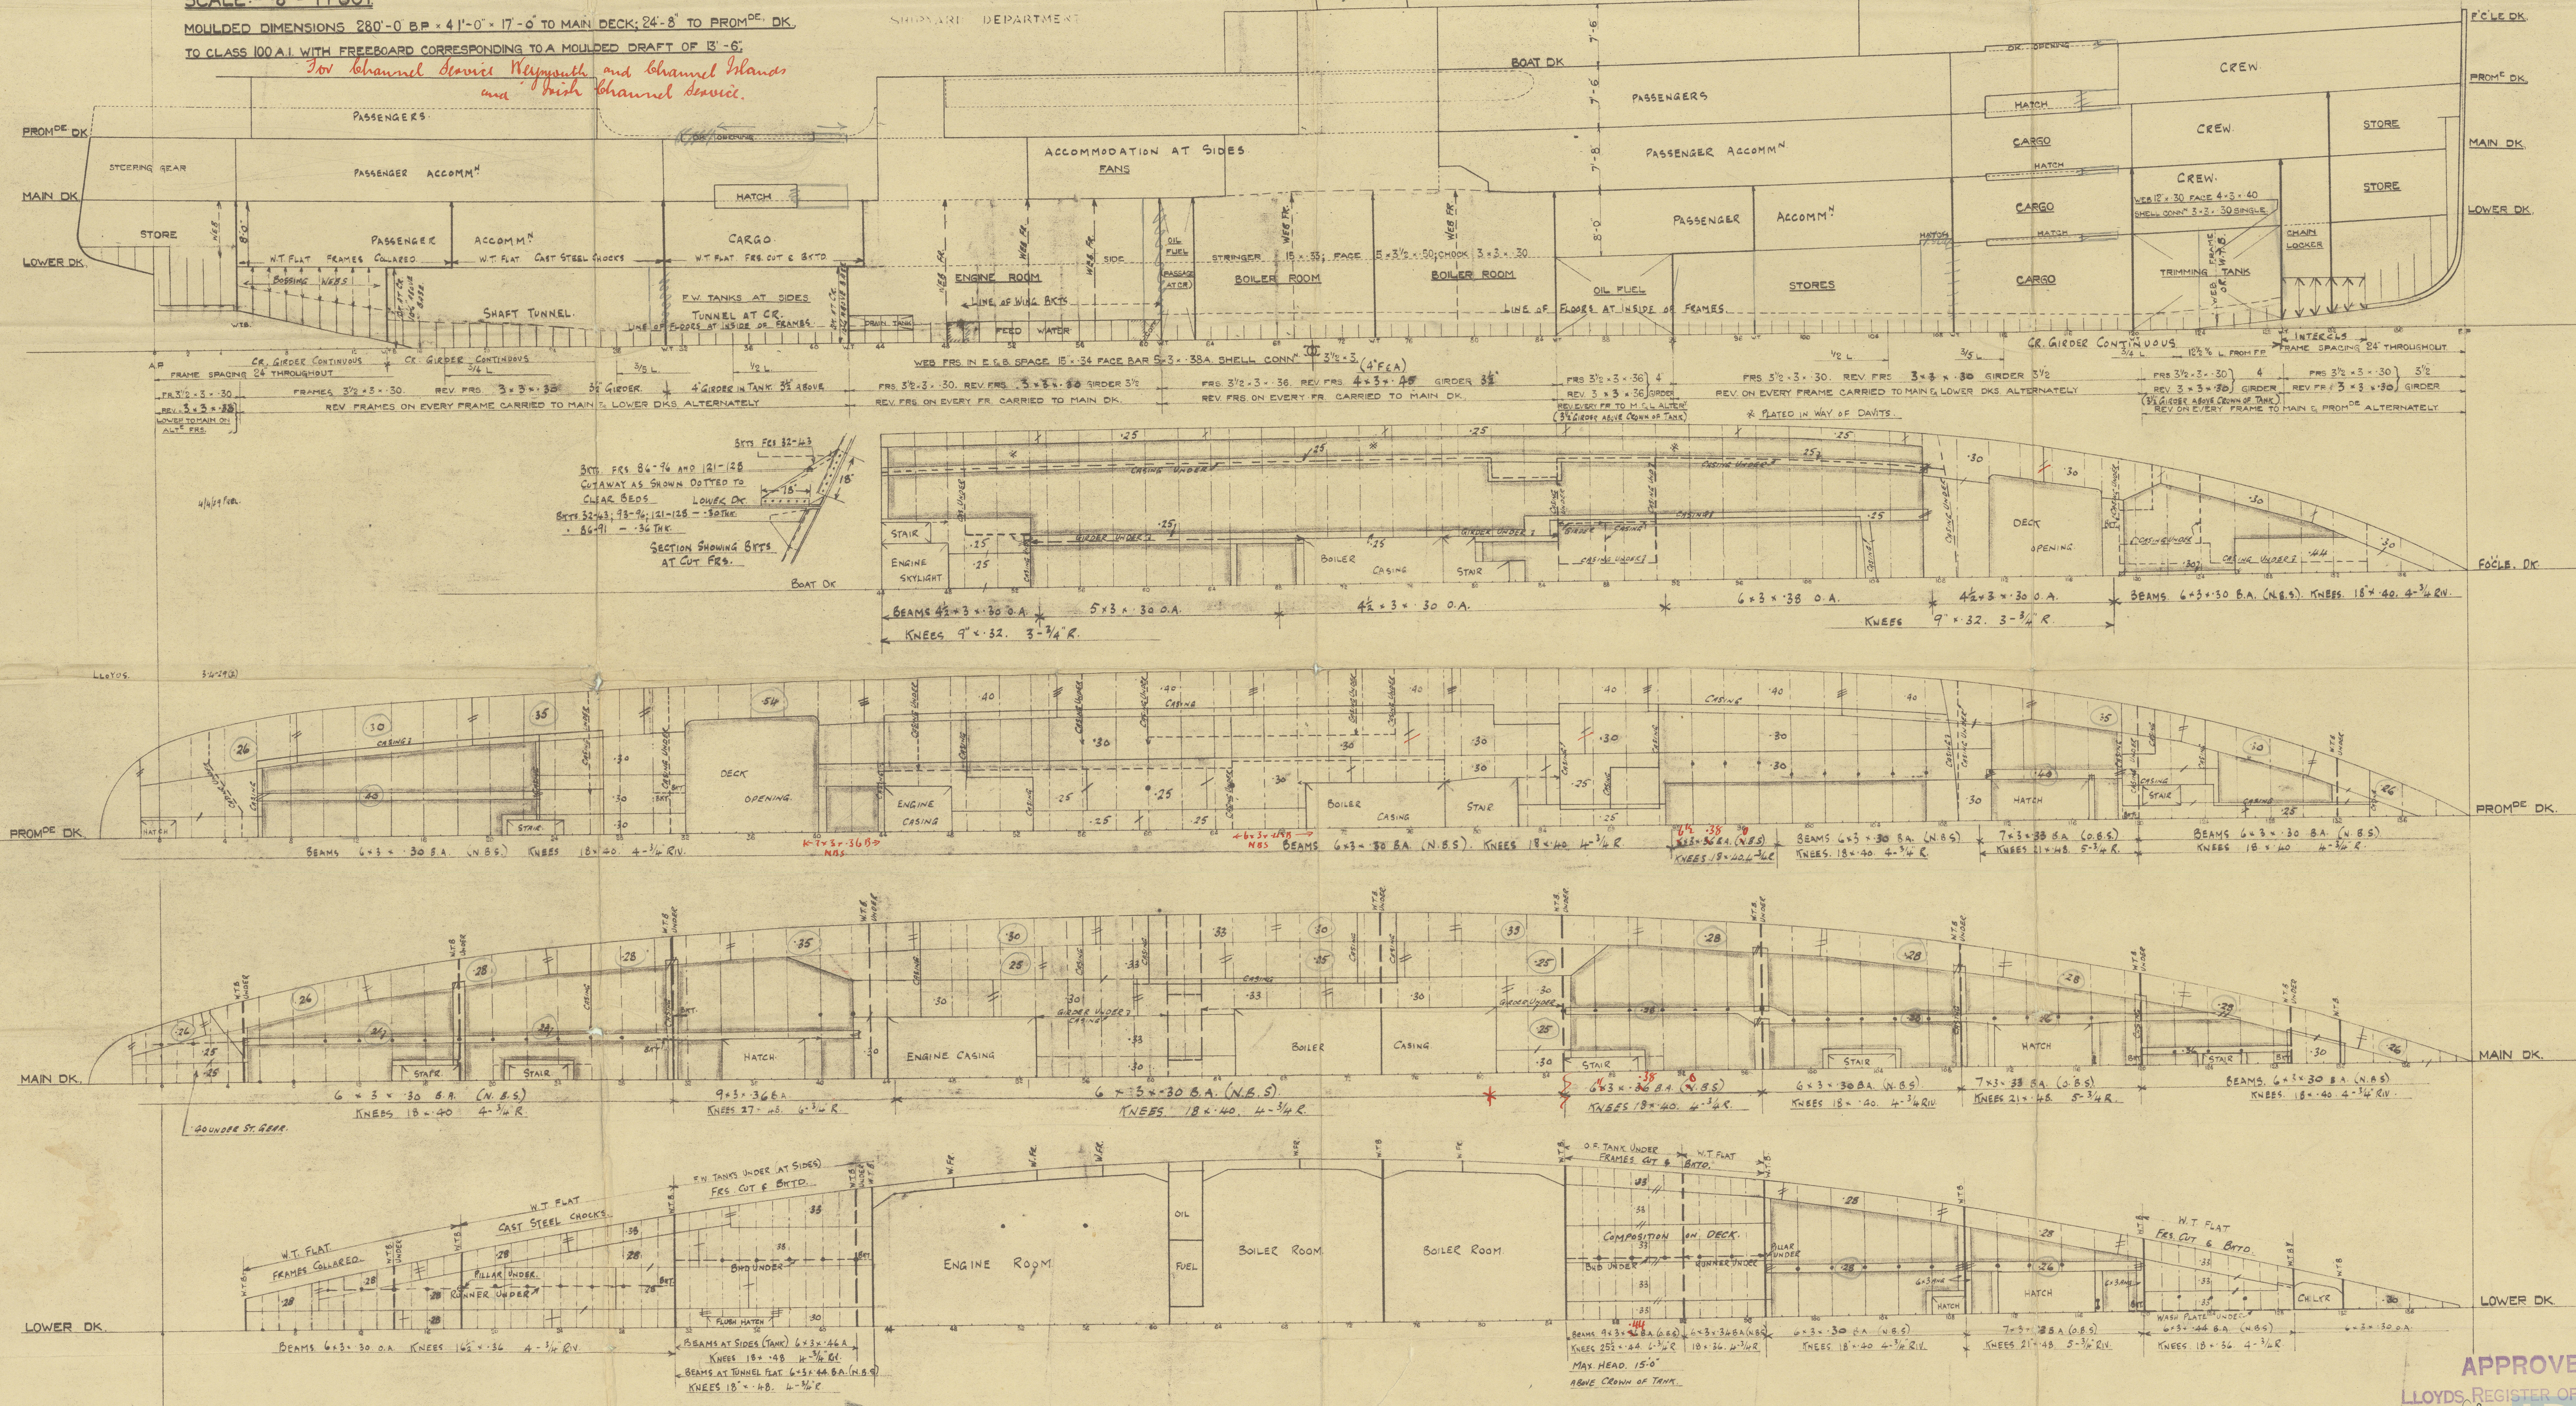

A. Stephen & Sons, Ltd.

No. 525.

Profile & Decks.

Gls. Feb 49998

St Patrick
GLASGOW REPORT No. 50280

XIII 7 - 0146



© 2021

Lloyd's Register
Foundation