

24-9-15


PLAN No. 5998
FOR ENCLOSURE TO
Master Lloyd's Register
Hull FROM
COCHRANE & SONS, LTD.
SHIPBUILDERS, SELBY.
DATE 21/9/15 *P.S.*

PROFILE & DECK PLAN

N^o 664-5-6

DIMNS 117'0" BP x 21'6" MLD x 12'3" MLD

SCALE 1/4" = 1 FOOT.


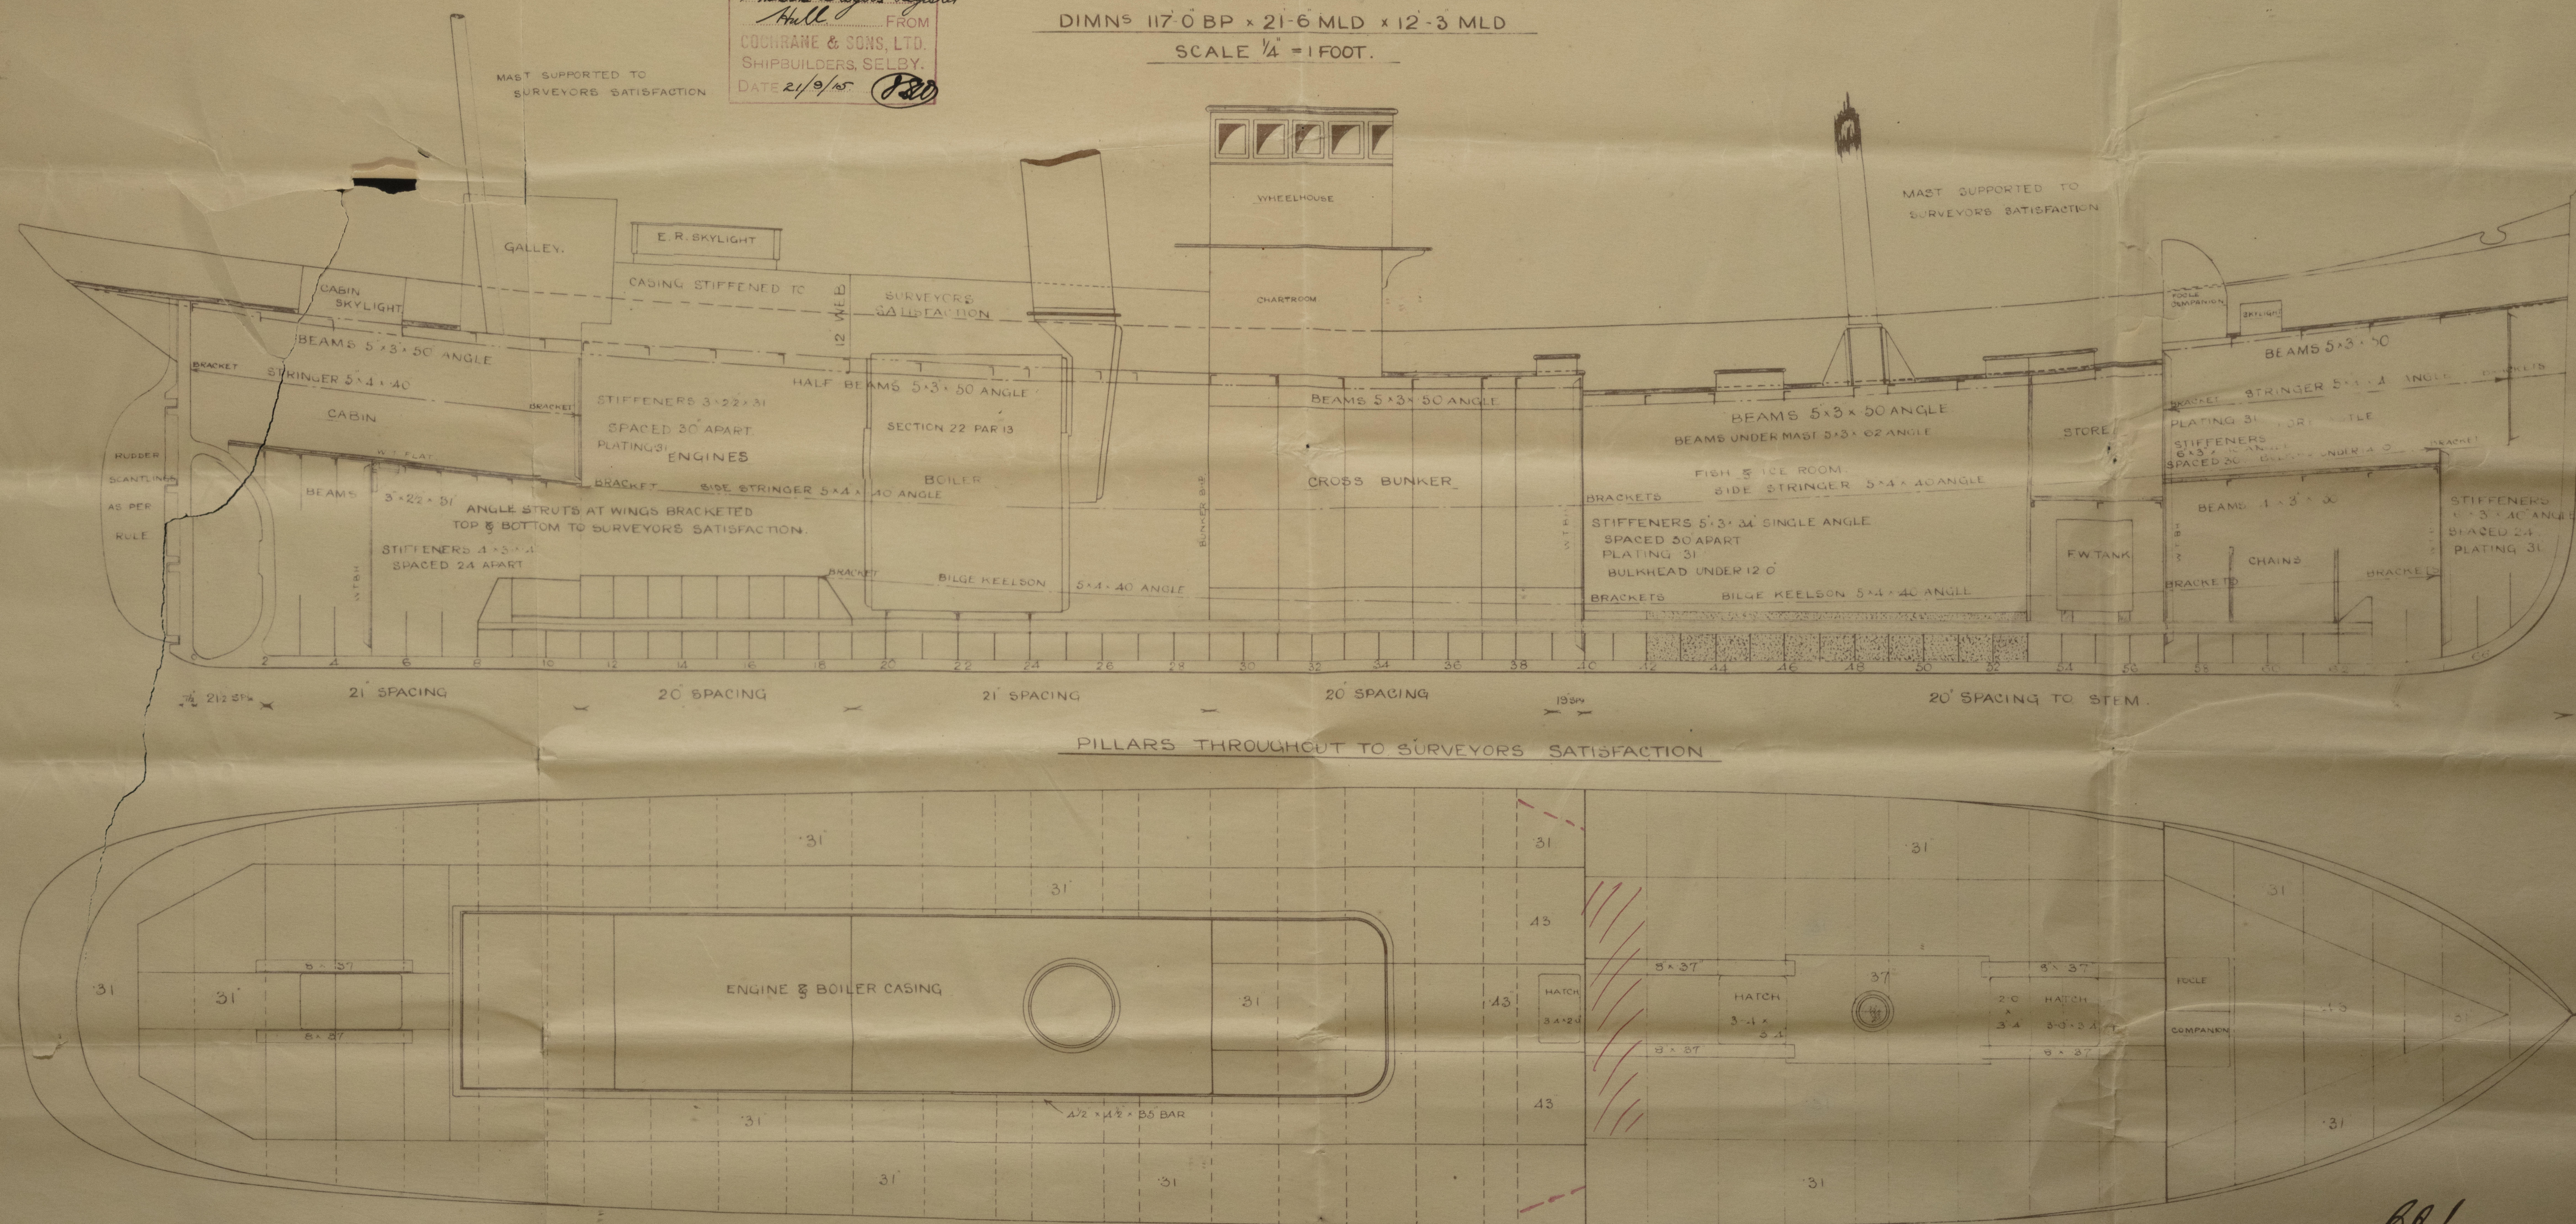


68/2
24-9-15.


PROFILE & DECK PLAN
COCHRAN & SONS LTD

N^{os} 664. 5. 6

W170-0255

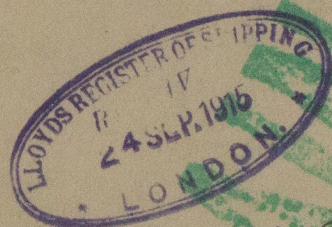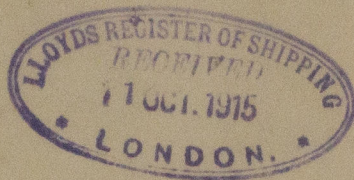

L. Windsor Hull Rpt No. 29709.

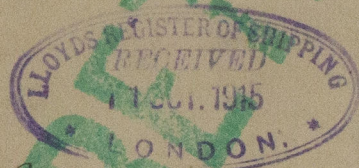

H. Palmeral Hull Rpt No. 29769.
L. Leys Hull Rpt No. 29837.



© 2021

Lloyd's Register
Foundation