



24.9.15

MIDSHIP SECTION

STEEL SCREW TRAWLERS

N^{OS} 664-5-6


DIMENSIONS:- 117'0 B.P. - 21'6 MLD. x 12'3 MLD

SCALE 1/2 INCH.

TO CLASS 100A1 STEAM TRAWLERS

DECK PLATED OVER IN WAY OF MACHINERY.
E & B CASING AS PREVIOUSLY APPROVED

PLAN No. 5997
FOR ENCLOSURE TO
Amos & Lloyd's Register
Hull FROM
COCHRANE & SONS, LTD.
SHIPBUILDERS, SELBY.
DATE 21/9/15 *SSD*

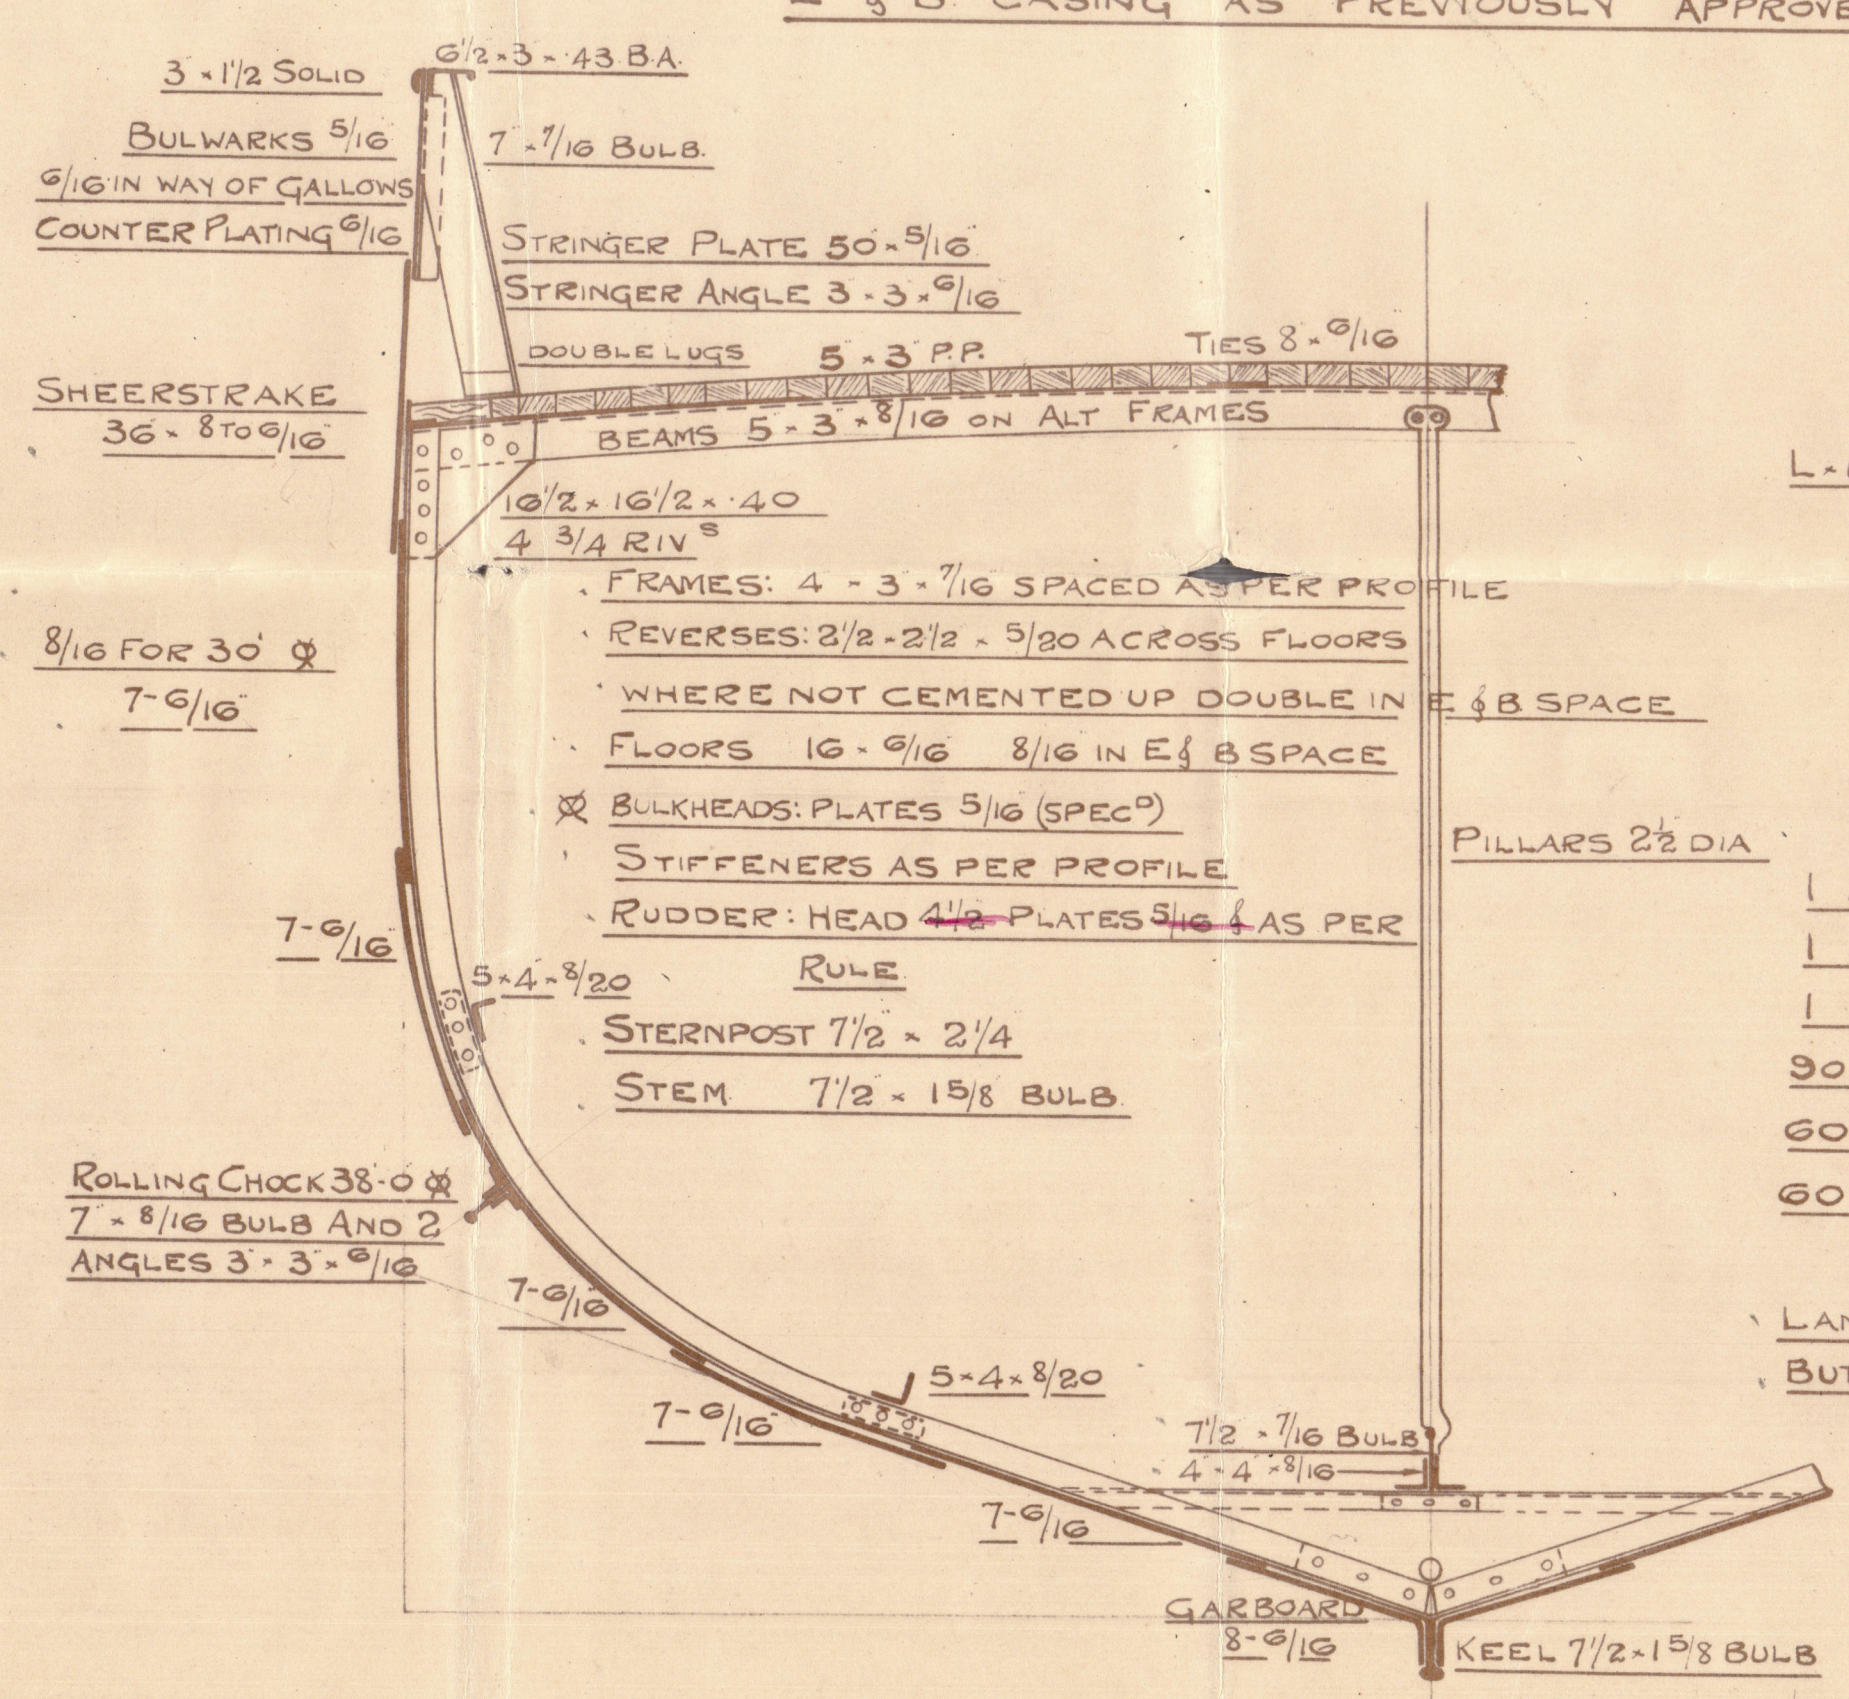

NUMERALS

B + D ----- 33.75
L x (B + D) ----- 3948.75

PROPORTIONS

L/B ----- 5.44
D/B ----- 9.55

EQUIPMENT

1 ANCHOR ----- 5 CWTs EX STOCK OR 6/4 STOCKLESS
1 " ----- 4 1/2 " " " 5 1/2 "
1 " ----- 2 1/2 " " " "
90 FATHOMS 1" STUDLINK CABLE
60 " 5/2" HAWSER
60 " 4" WARP

RIVETING




LANDINGS DOUBLE RIV'D BULWARKS SINGLE RIV'D
BUTTS STRAPPED & DOUBLE RIV'D

CCP
24.9.15



MIDSHIP SECTION
COCHRANE & SONS LTD

N^{os} 664-5-6

W1170-0256

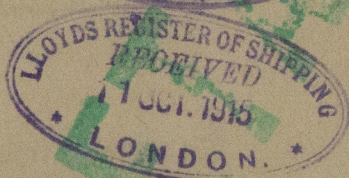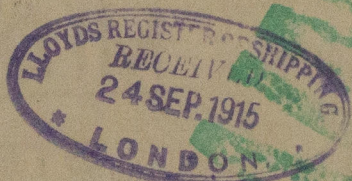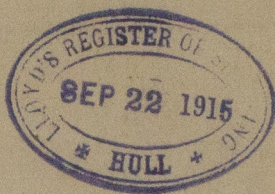

St. Windsor Hull Rpt No 29709
St. Balmoral Hull Rpt No 29769
St. Lays - Hull Rpt No 29837

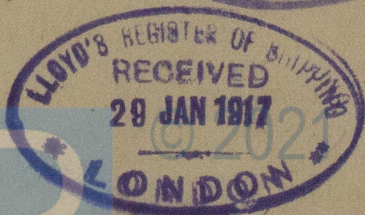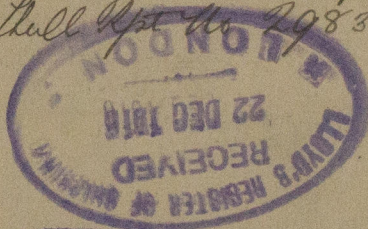

W. B.

Lloyd's Register
Foundation