




27.5.29

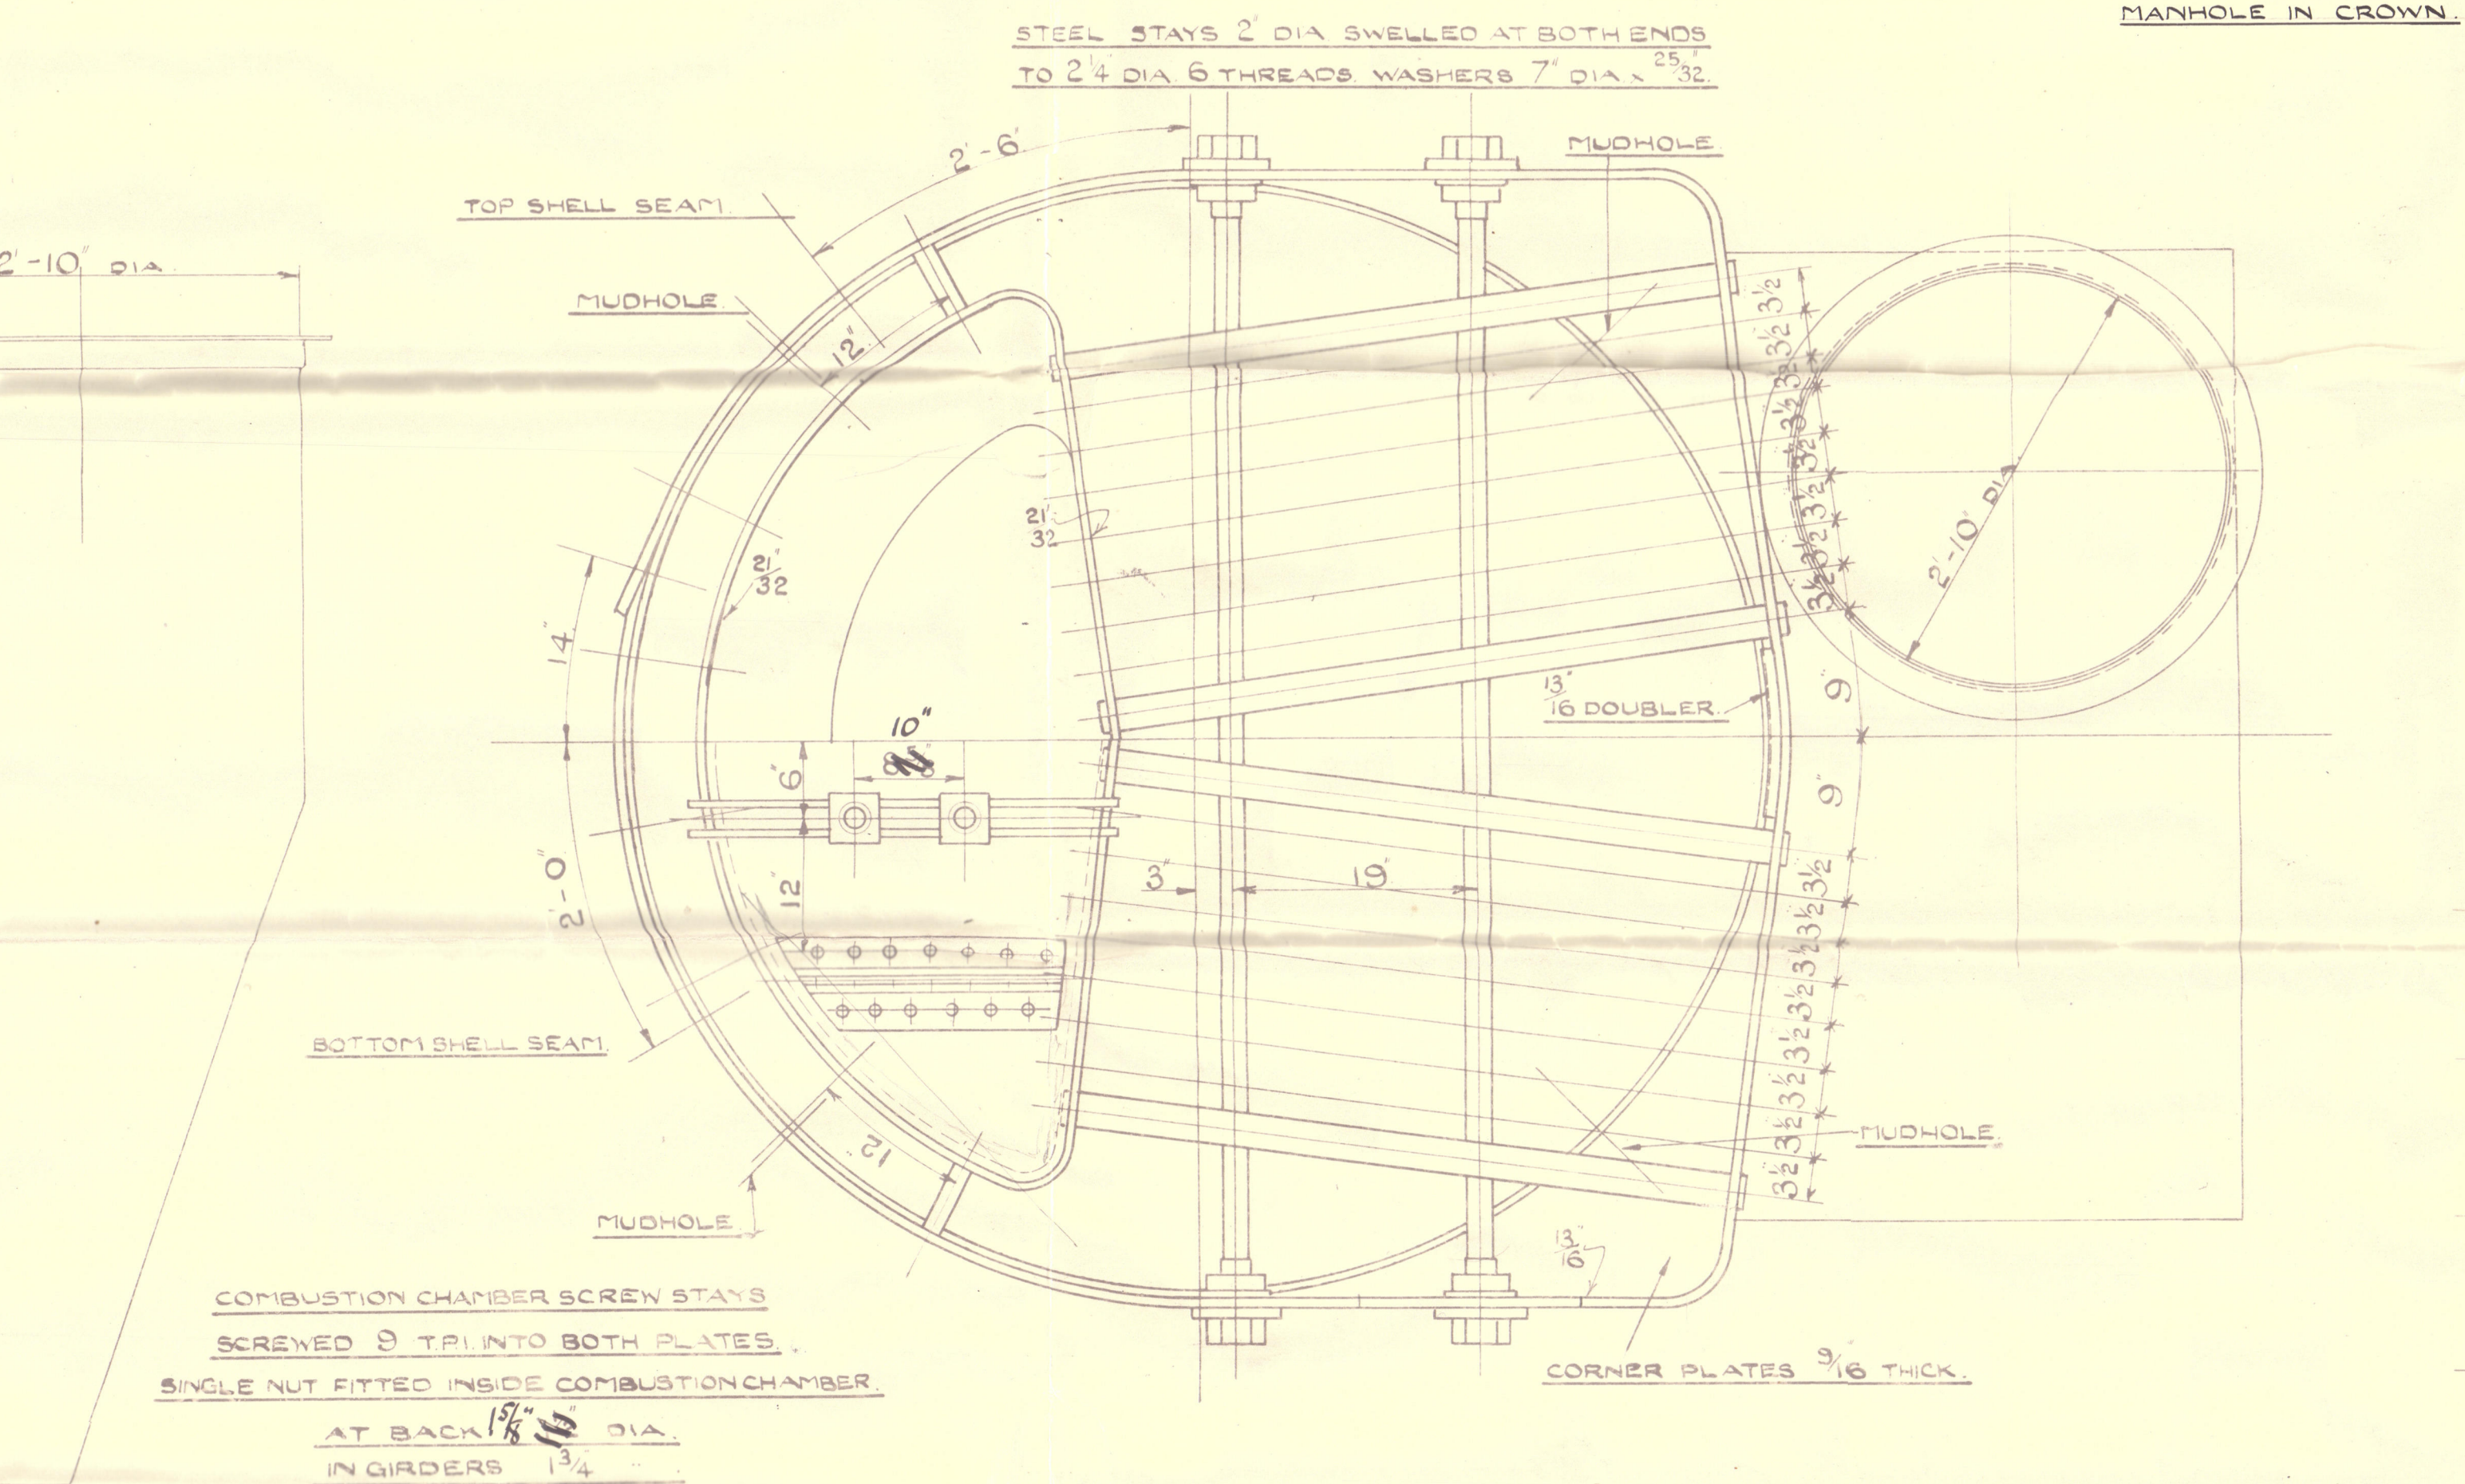

RILEY BROS (BOILERMAKERS) LTD
STOCKTON ON TEES

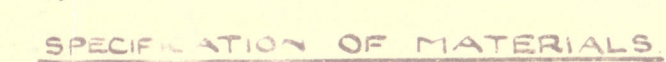

27/5/29

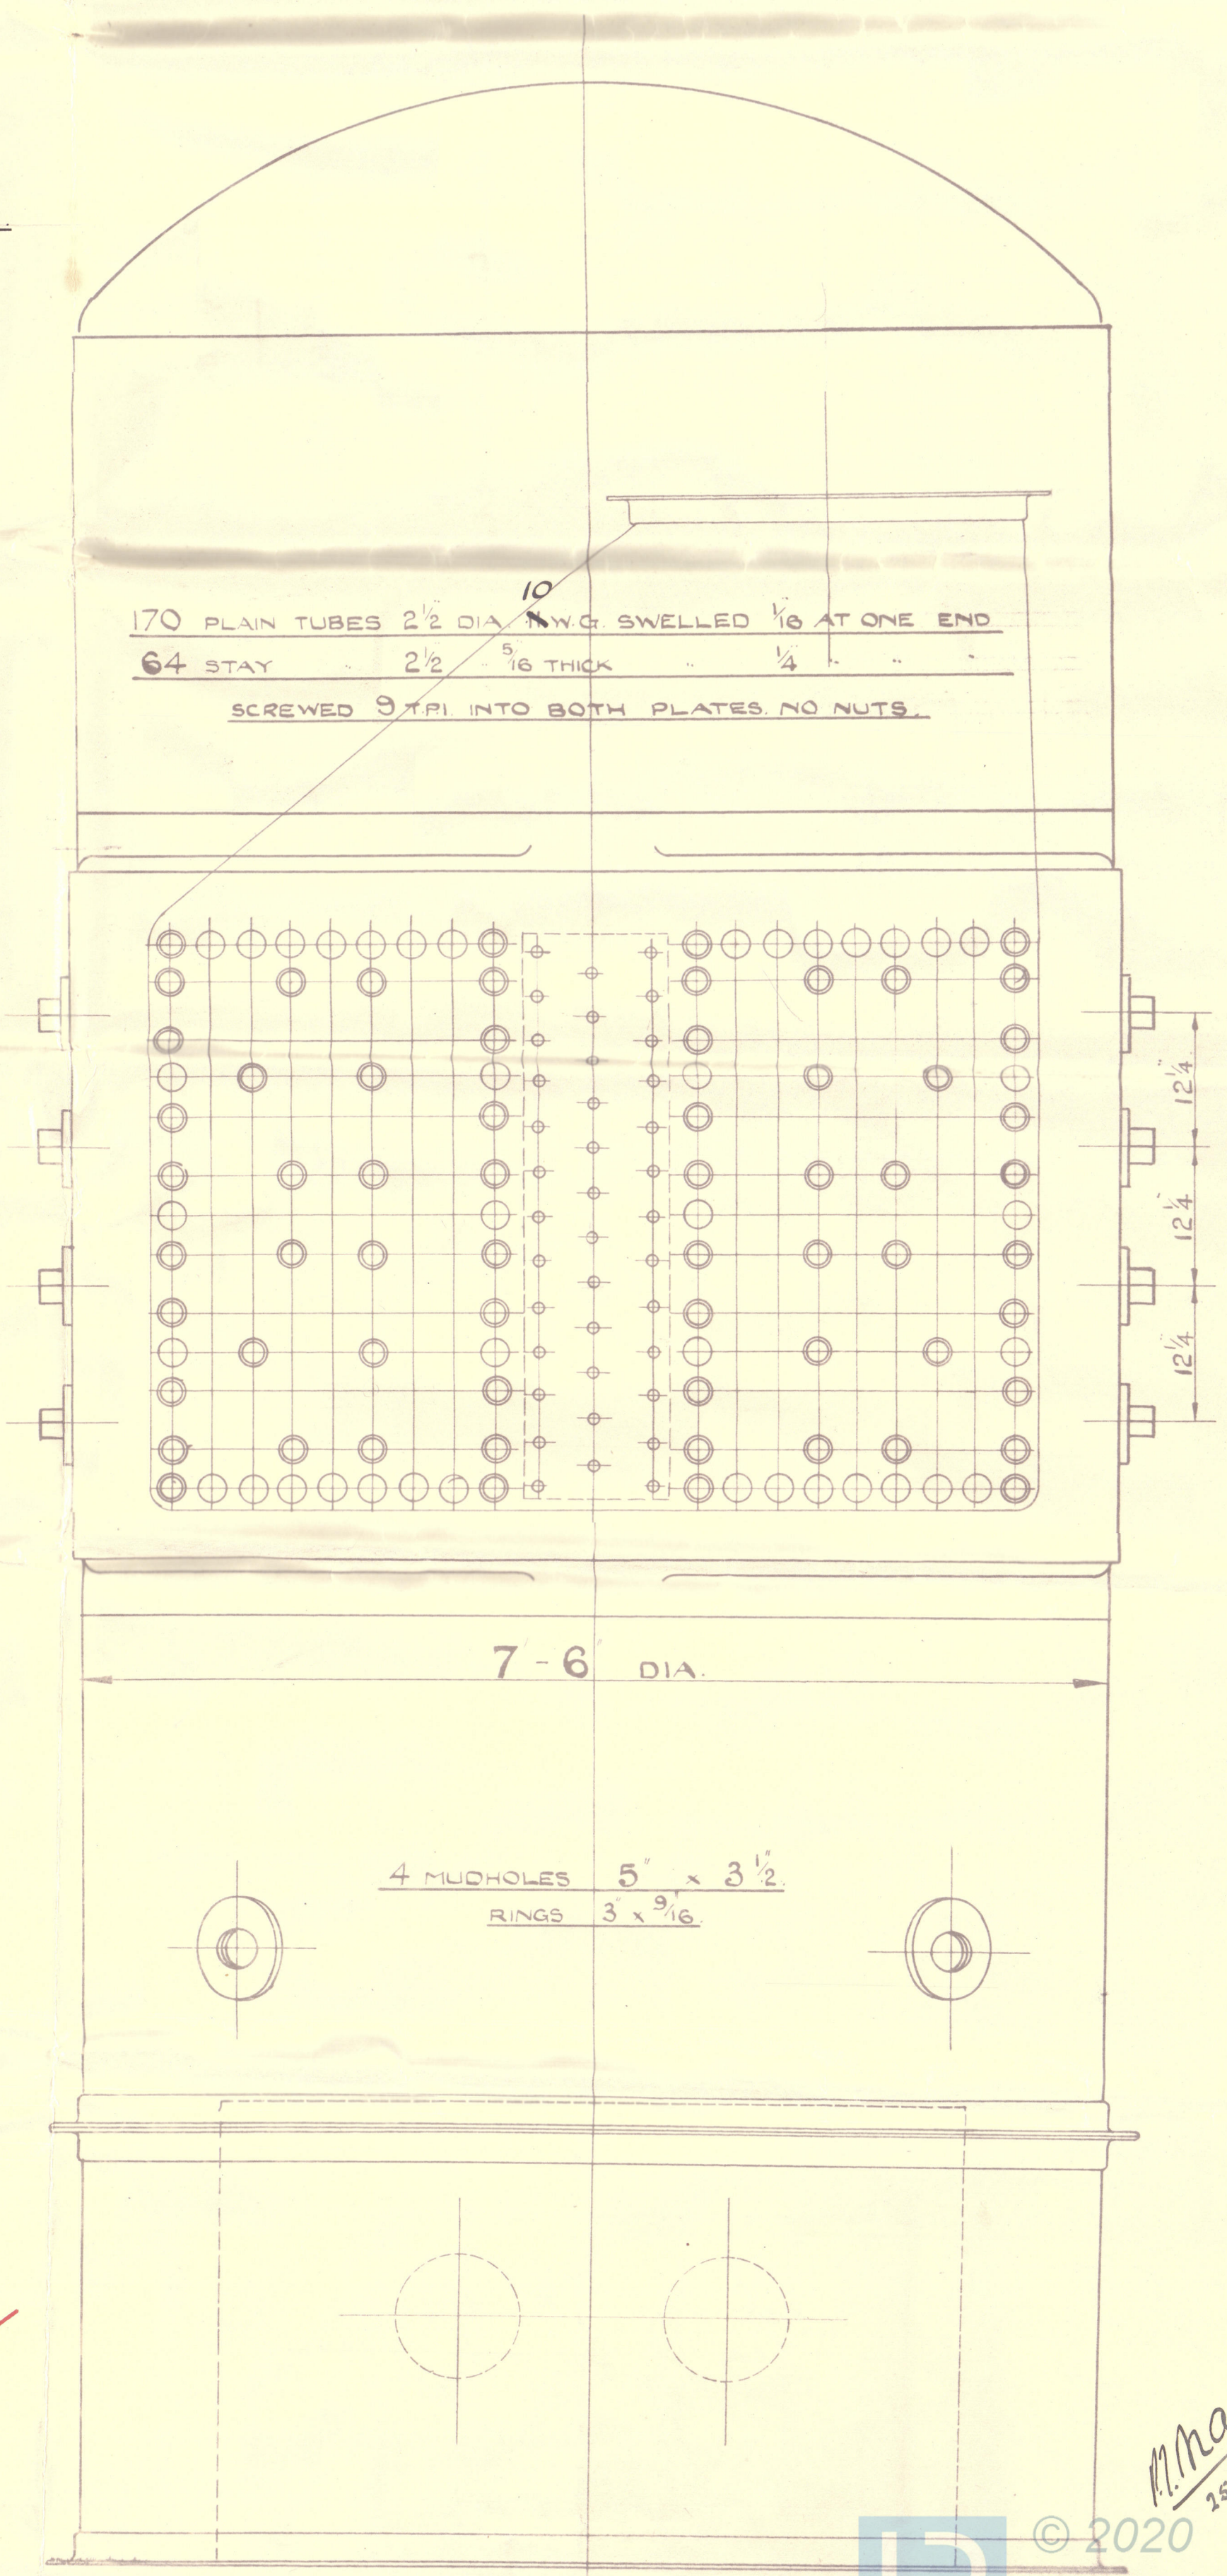

Nº 5929

RILEY BROS.

7'-6 x 18'-6 x 120 lbs.

RETAIN
for
Armstrong's Collection No.

Mod. wpt No. 13849

"Anglo Maersk"

MV. "ANGLO SWEDE"

NEWCASTLE ON TYNE

Reg. No. 85442.



W1171-0034



© 2020

Lloyd's Register
Foundation