

20.7.17

SCALE 8" = ONE FOOT.

— DIMENSIONS —


LENGTH B.P. ——— 33'-0".

BREADTH EXT. 46'-9 $\frac{1}{2}$ " (46' 6" min.)


DEPTH ML^d 25'-6".

JOHN PRESTMAN & COY.
SHIPBUILDERS *prop.*
SUNDERLAND *13/1/17*


— BRIDGE DECK

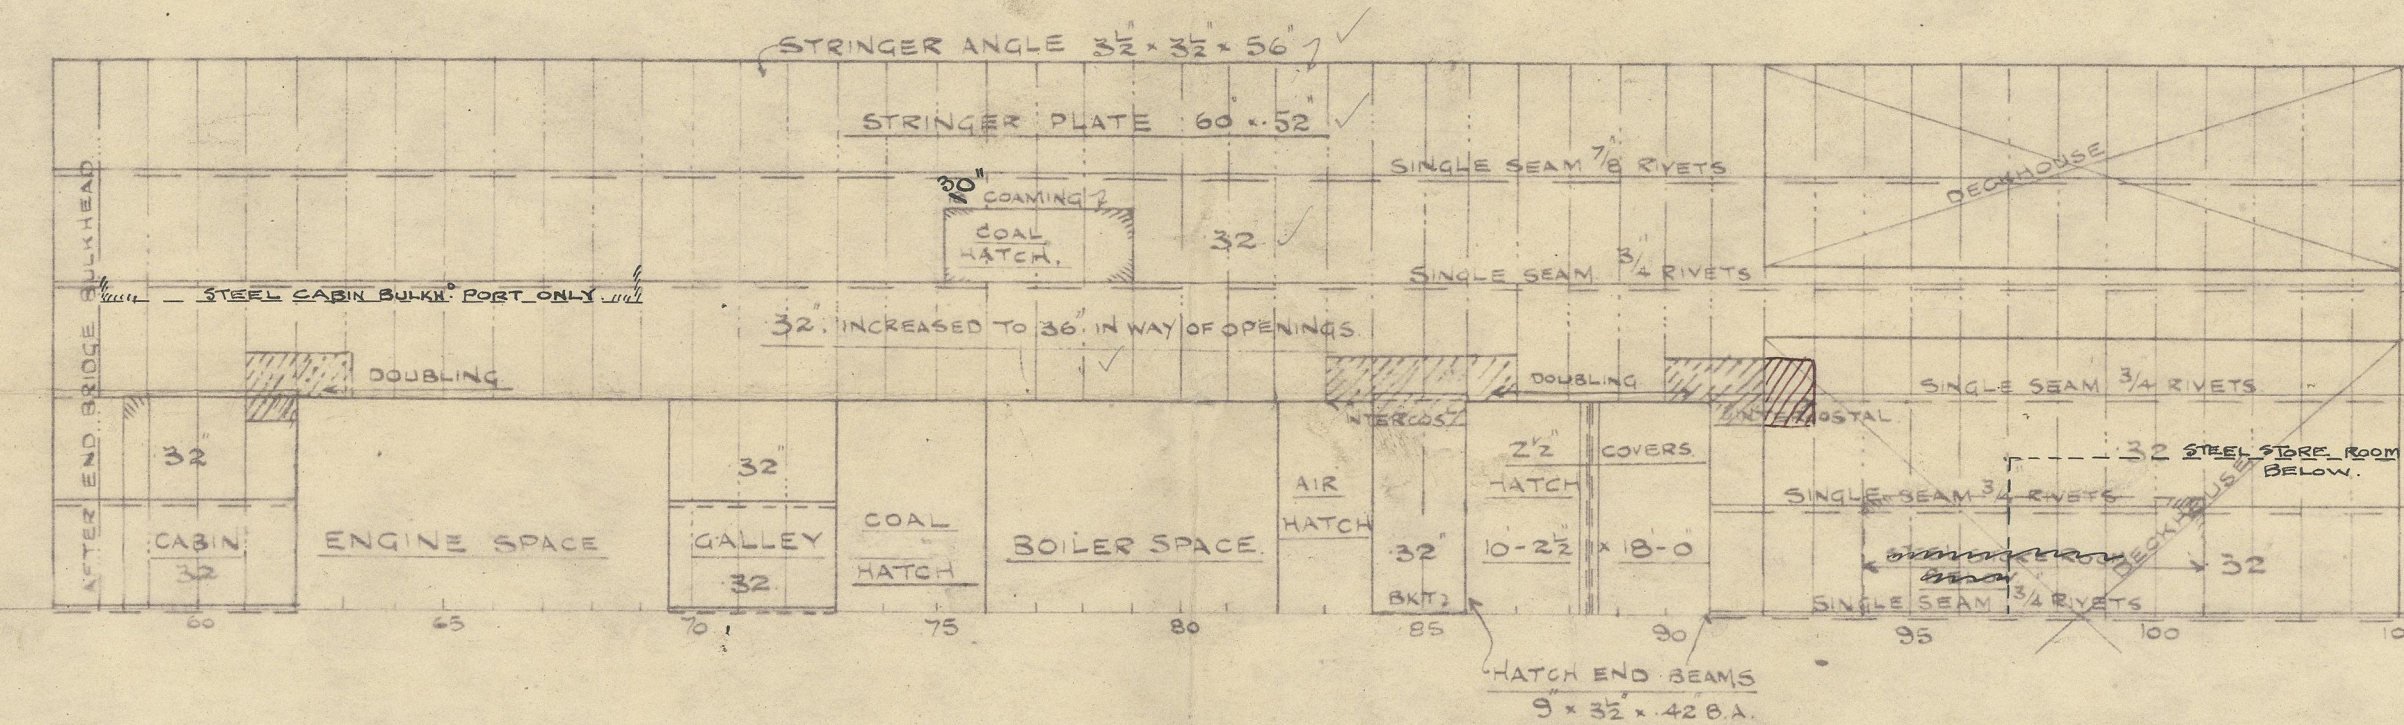


— FORECASTLE DECK —

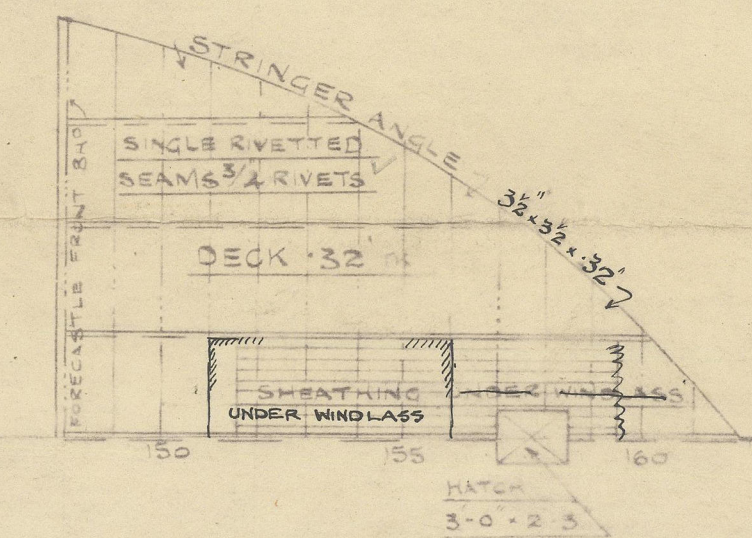

— POOP DECK

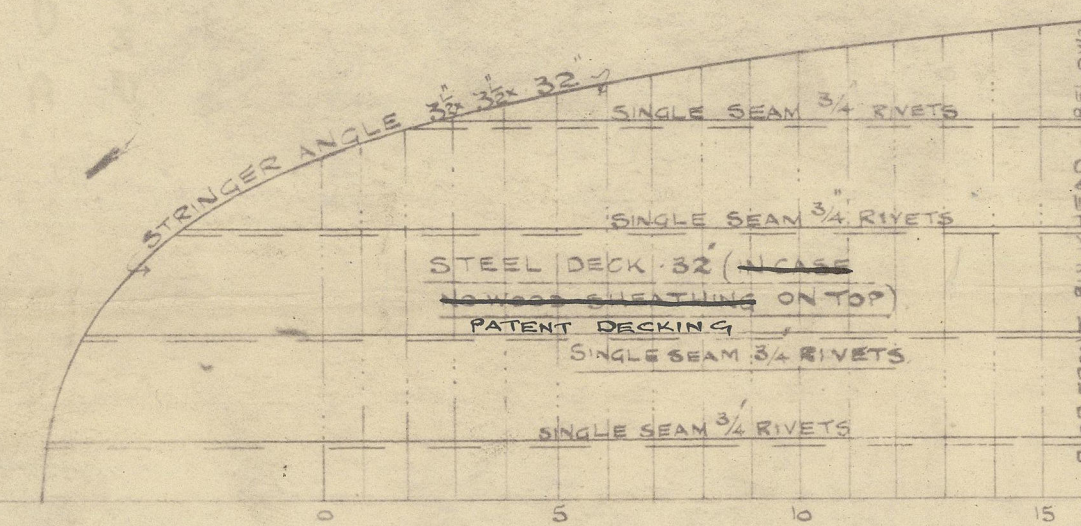

— UPPER DECK

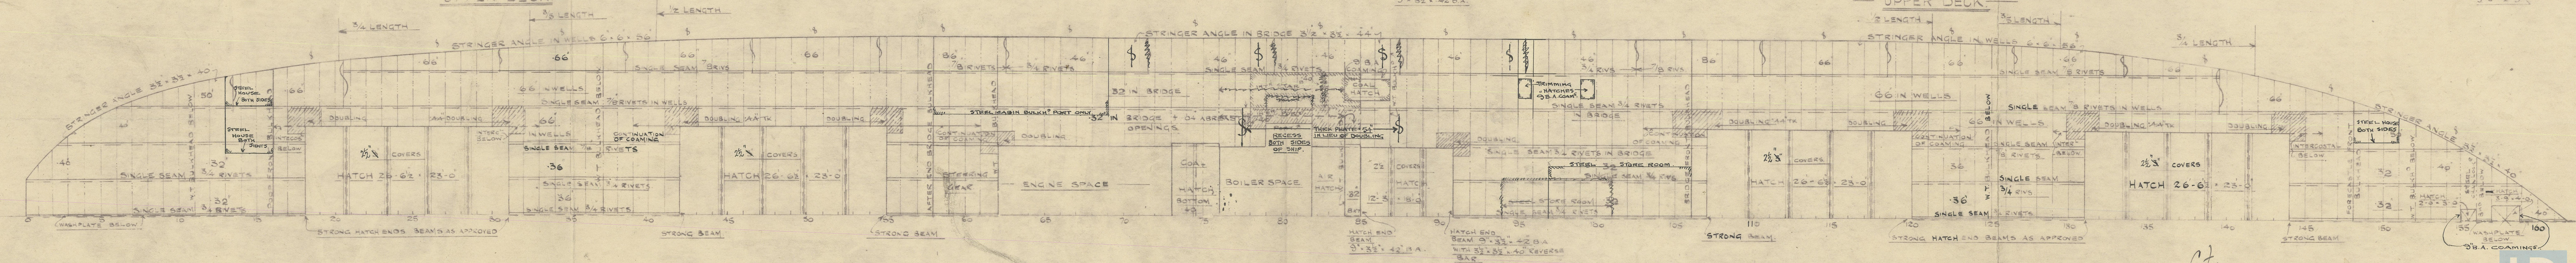

C. f.
20-7-17





PRIESTMANS N^o 266

STANDARD "C"

DECK PLANS

Bartolo ex War *Zephyr*

SUNDERLAND RPT. NO. 27366

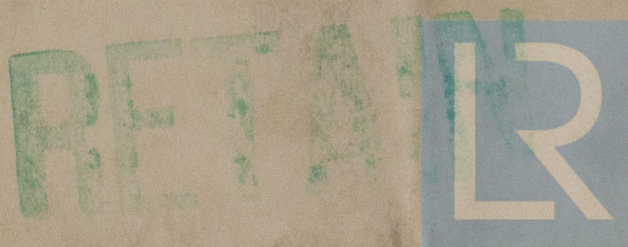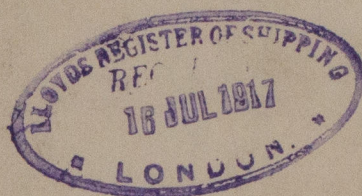

© 2020

Lloyd's Register
Foundation