

20.7.17

PROFILE N° 266.

TYPE "C" STANDARD STEAMER.

— SCALE $\frac{1}{8}$ = ONE FOOT —

— DIMENSIONS —

LENGTH S.P. 331'-0"

BREADTH EXT. 46'-9 $\frac{1}{2}$ " (46'-6" MOULDED)


DEPTH MLD. 25'-6"

JOHN PRIESTMAN & CO.

SHIPBUILDERS,

SUNDERLAND.

Derrick Pate supported to Surveyors Satisfaction
FOR CORRECT PILLARING, SEE SPECIAL APPROVED PLAN.

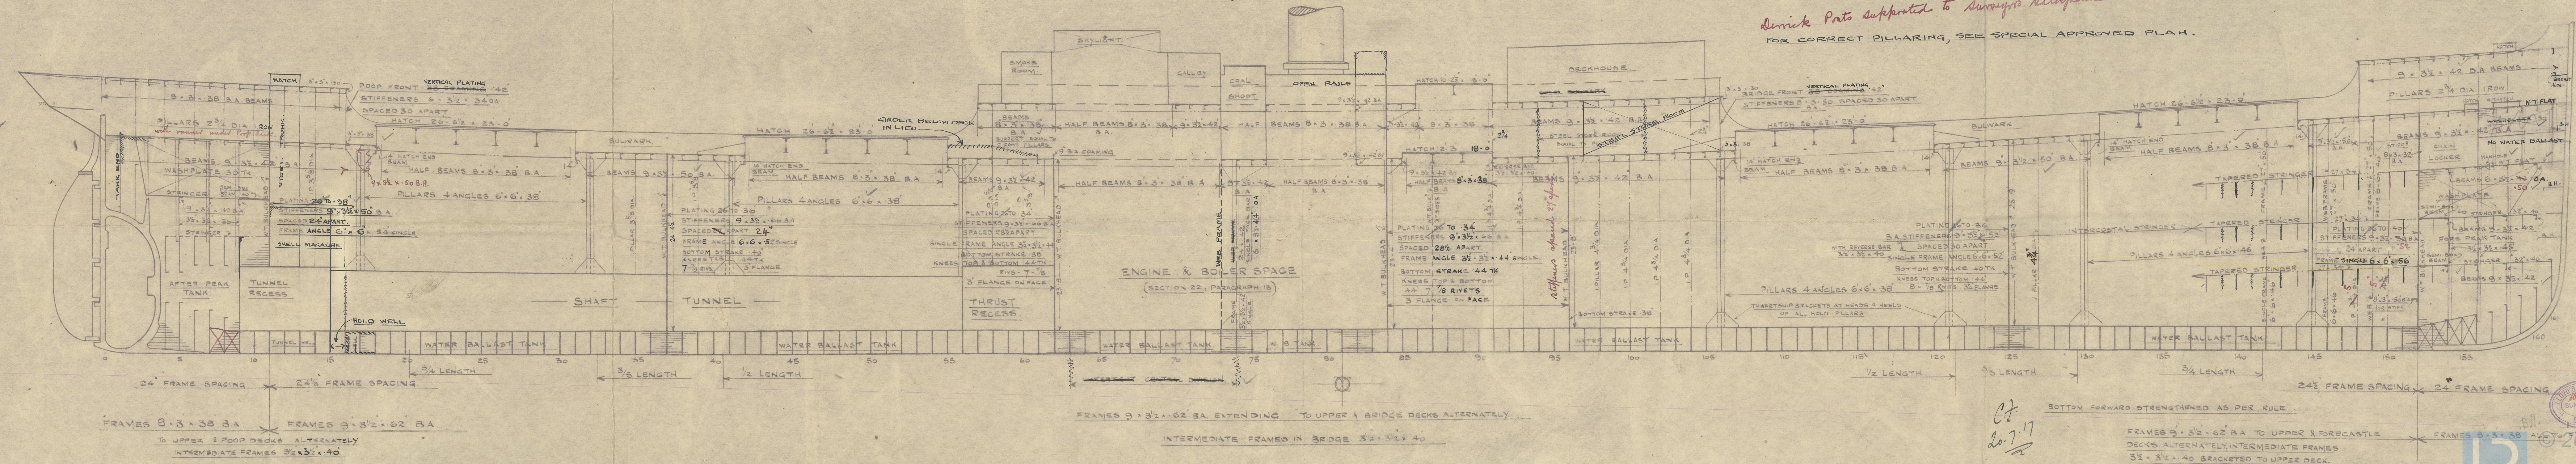

cf.
20.7.17

BOTTOM FORWARD STRENGTHENED AS PER RULE.

FRAMES 9.3.2.62 B.A. TO UPPER & FORECASTLE DECKS ALTERNATELY, INTERMEDIATE FRAMES 3.2.3.40 BRACKETED TO UPPER DECK.

FRAMES 8.3.38 B.A. TO UPPER & POOP DECKS ALTERNATELY, INTERMEDIATE FRAMES 3.2.3.40



PRIESTMANS N^o 266

STANDARD "C"

PROFILE


Bartolo
War *Lephyr*

SUNDERLAND RPT. NO. 27366

n.n."

SS.

Bartolo

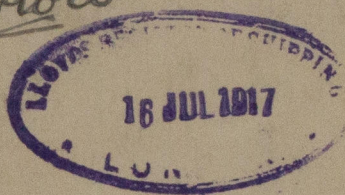

© 2020

Lloyd's Register
Foundation

W1172-0021