

# S.S. EMPIRE BEAUMONT.

## SHIP N° 345

### PROFILE & DECK PLANS.



SCALE 1" = 8' = ONE FOOT

DIMENSIONS - 425' 0" B.P. ON LWL x 56' 0" M.D. x 37' 8" FLAT SHEER TO CLASS 100-A1 WITH FREEBOARD AT LLOYD'S SPECIAL SURVEY

CHEER FORWARD	81
SHEER AFT	51
ROUND OF BEAM	14
NO TUMBLE HOME	

THE SCANTLINGS OF RIB ANGLE AND CHANNEL SECTIONS GIVEN ON THIS PLAN ARE 1" x 8"

THE SCANTLINGS ARE SUITABLE FOR LOAD DRAFT OF 26' 9" EXTREME

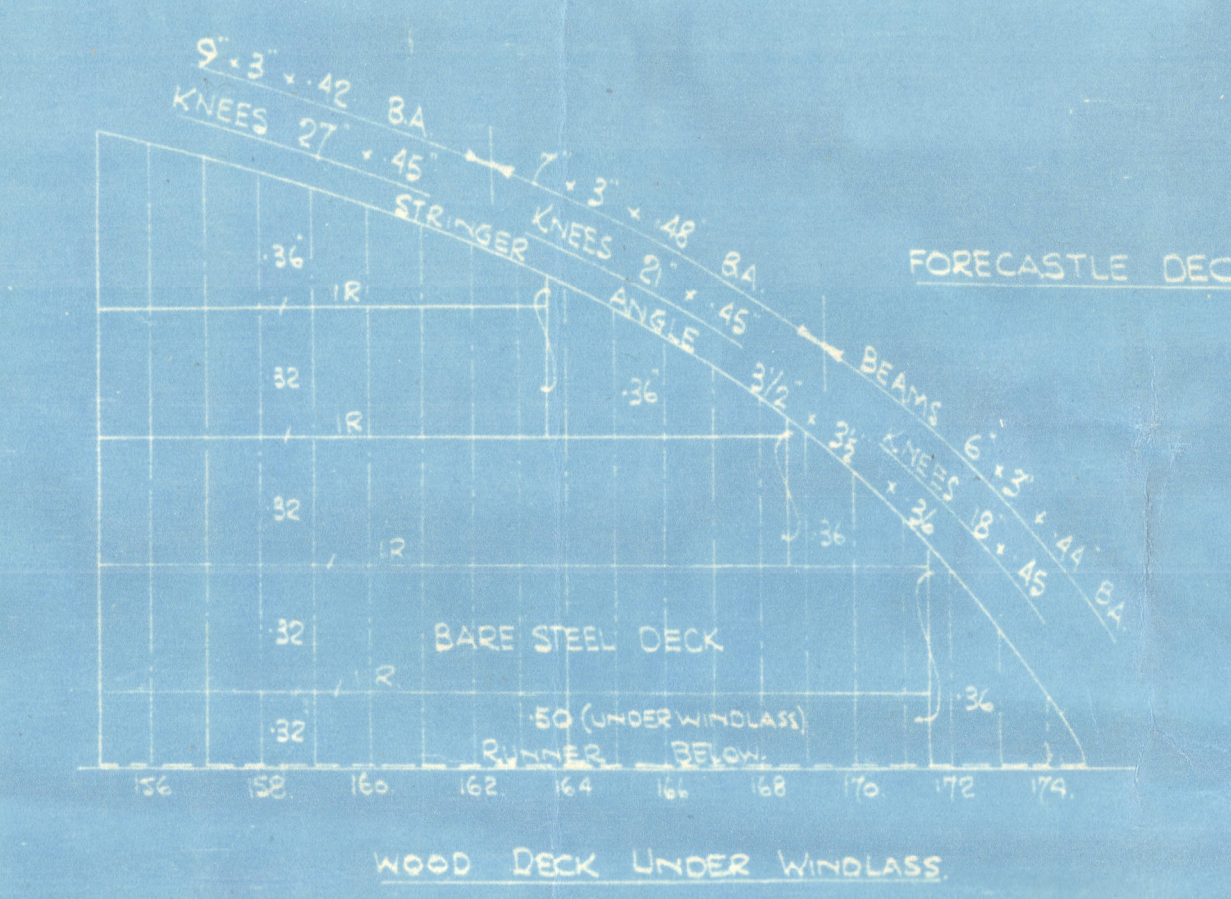 

(11)

Gusness Shipbuilding Co. Ltd.

Yard Nos. 345-6.

Profile and Decks (as built).

S.S. Empire Beaumont  
MDR. RPT. No. 17278/x

© 2020

W 1173-0073

Lloyd's Register  
Foundation