


COCHRAN PATENT VERTICAL MULTITUBULAR BOILER.

HORIZONTAL FLUE TUBES.

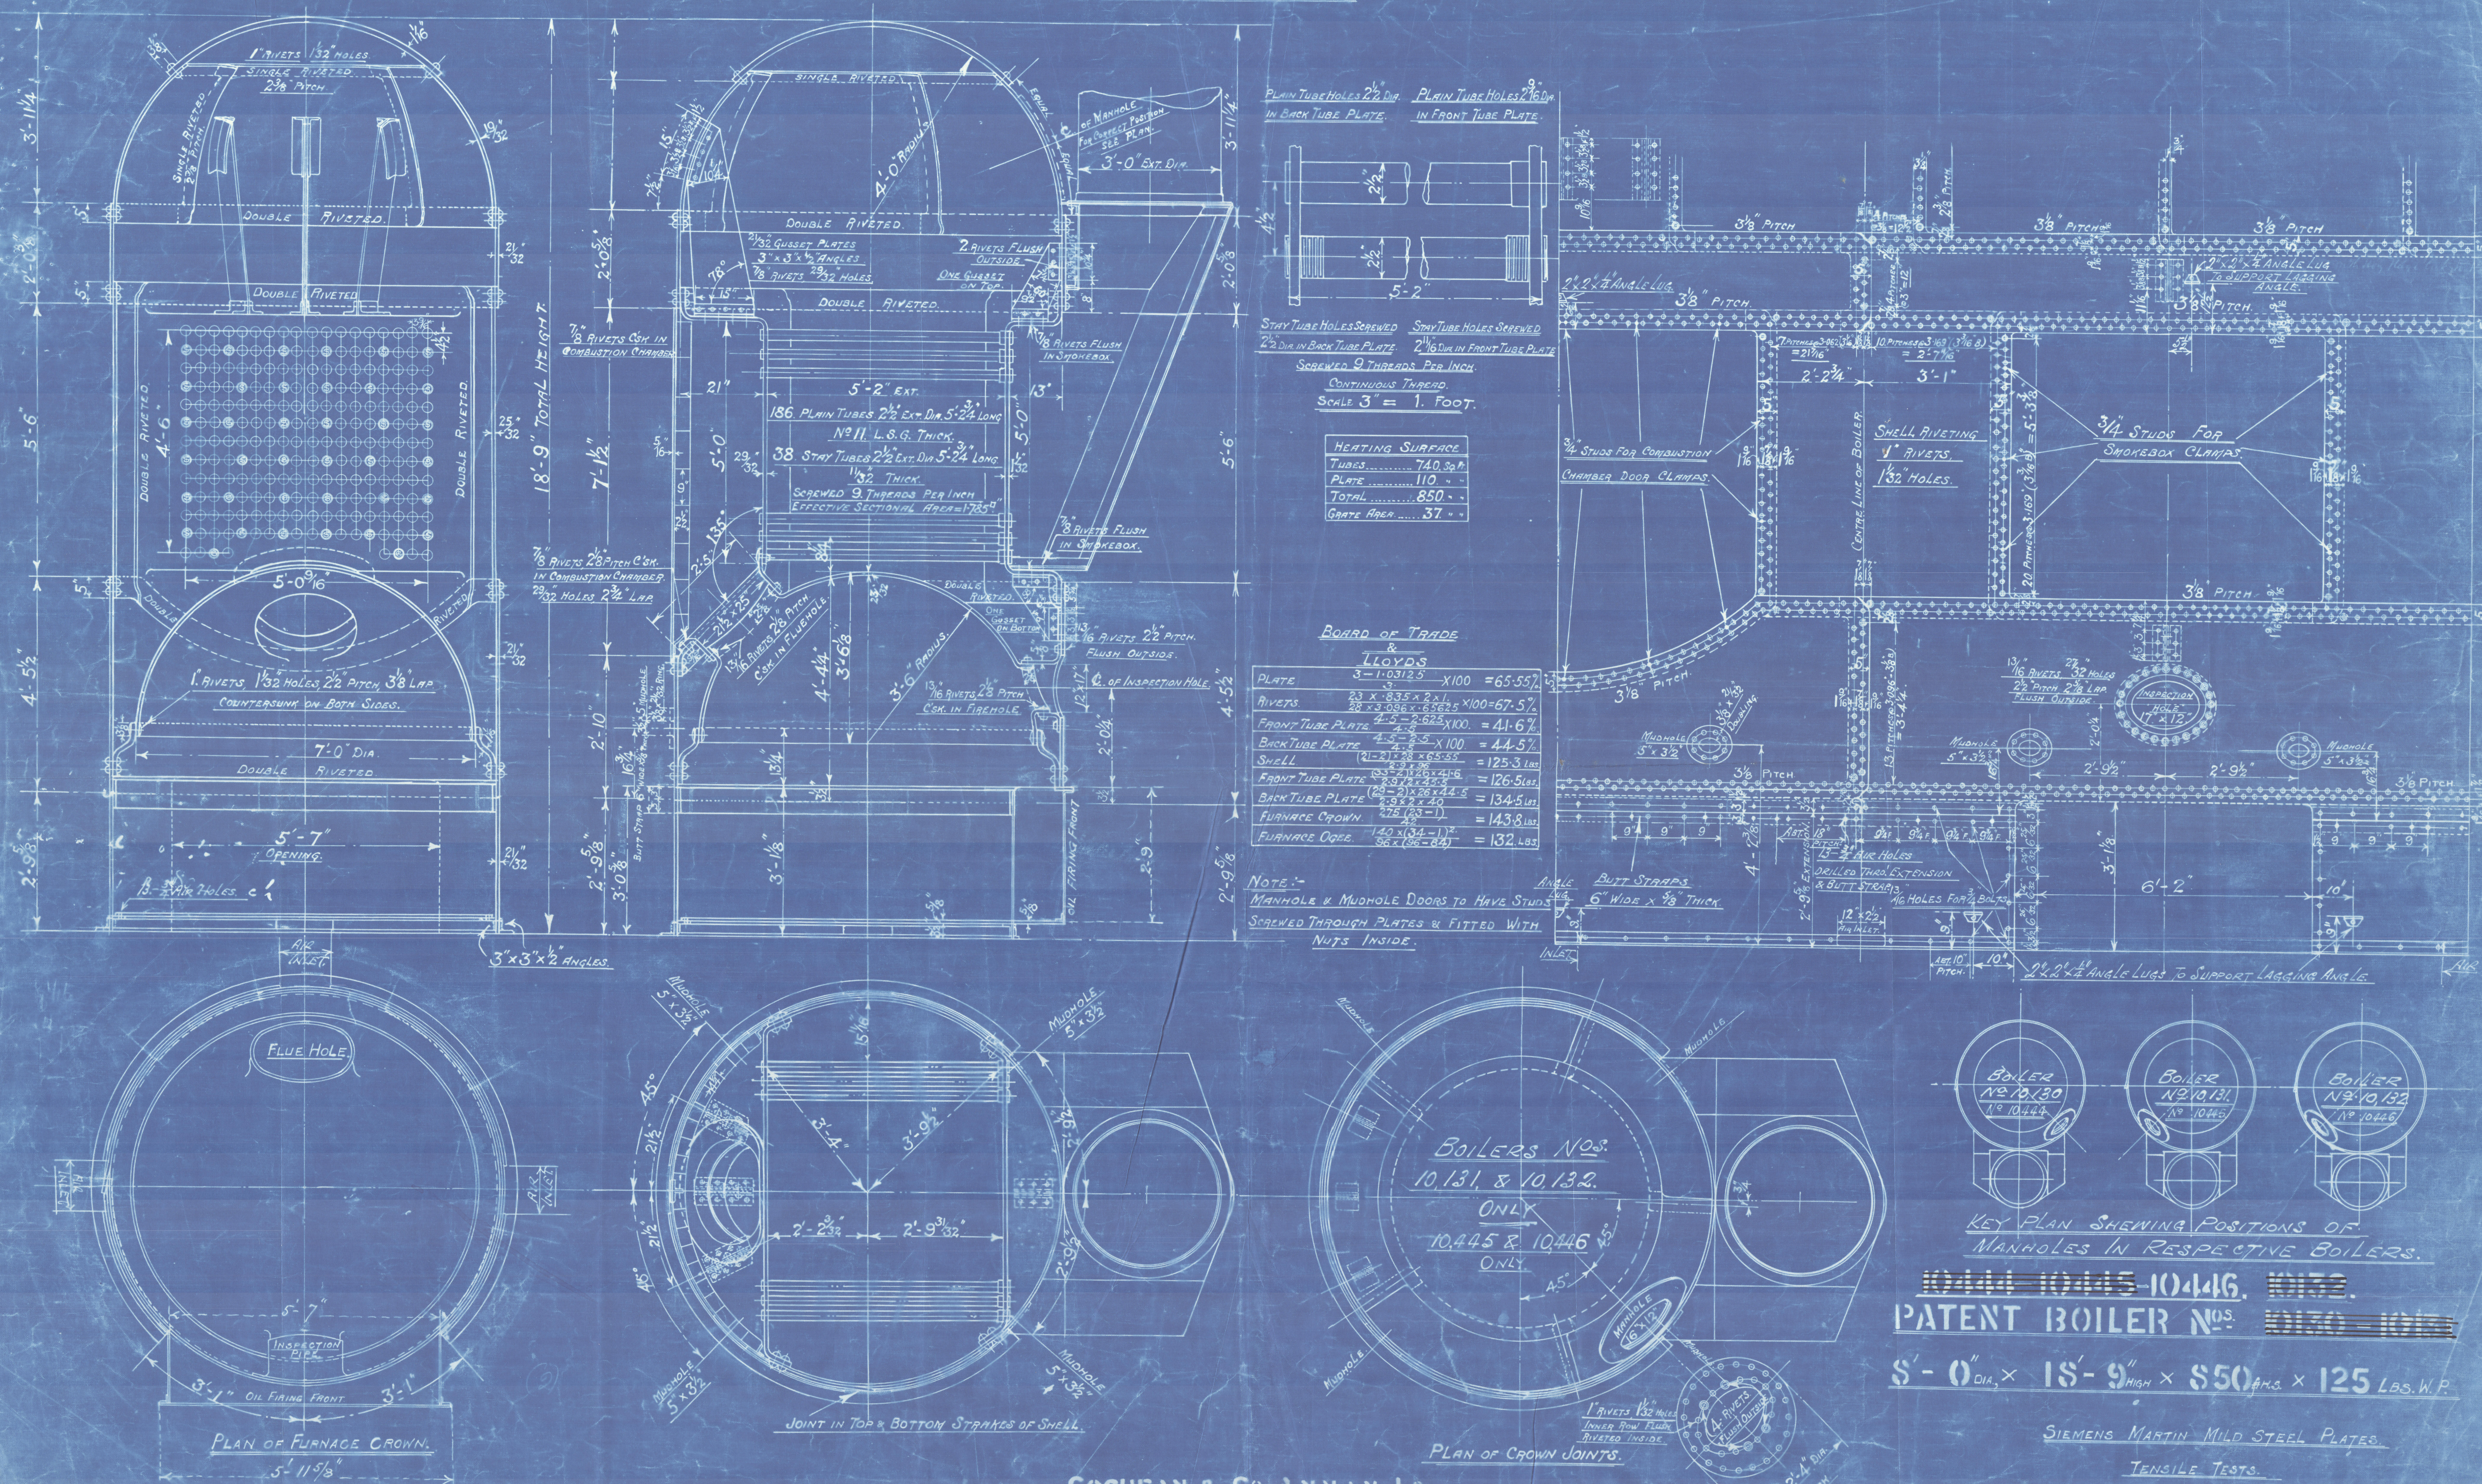

COCHRAN & CO ANNAN L^D
ENGINEERS & BOILERMAKERS
ANNAN SCOTLAND.

SURVEY- LLOYDS & BOARD OF TRADE.

Approved 15th/12/10
By 10,131-10,132-10,132

© 2020 Lloyd's Register Foundation

WHT3-0226

COCHRAN & CO., ANNAN, LD.

Boiler No. 10446.

Drawing No. 15544


WP. 125 lbs

GLASGOW REPORT No. 47491

GLASGOW REPORT No. 47851

El Argentino

RETAIN

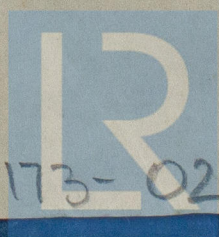

© 2020

Lloyd's Register
Foundation

W1173-0226