



M.V. ATHELMONARCH

COLOURED PARTS TO BE RENEWED

PORT CRANKSHAFT

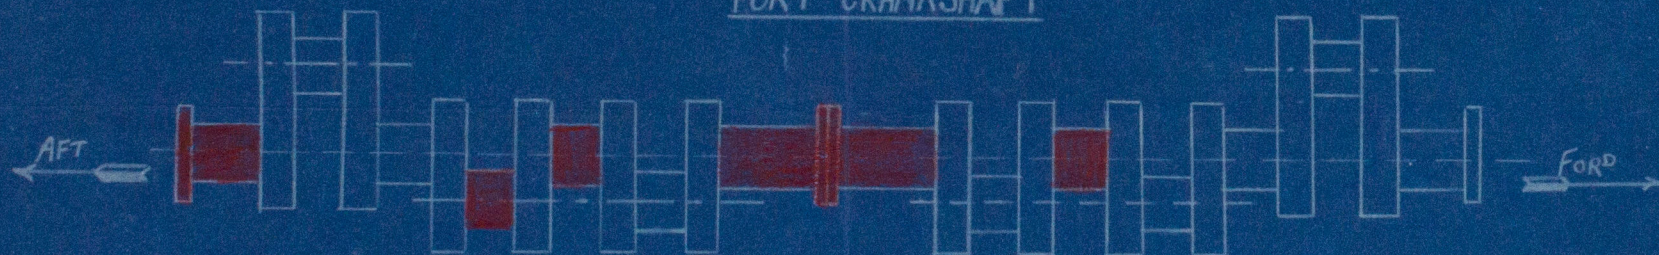

STAR^{BD} CRANKSHAFT

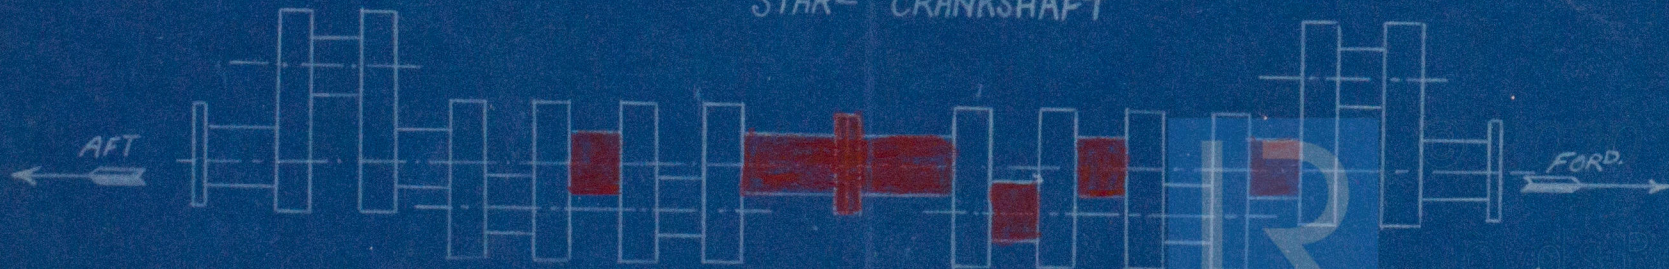

11176 - 0079

ATHEL MONARCH

Mr Reed
Surveyor
Abbey St Office



© 2020

Lloyd's Register
Foundation