


BOILERS N<sup>o</sup> 2612

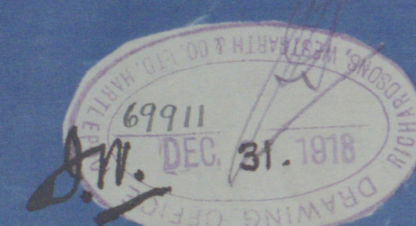

Chas Hill & Sons 5/135

Richardson Newgate No. 2612

2 main Boilers F.P.

No 3540  
Lloyds Test.  
360 th  
WP=180  
29-7-1919 L.C.D.

LLOYD'S REGISTER  
RECEIVED  
2 - JAN. 1919  
WEST HARTLEPOOL

West Hartlepool  
Report No. 15698.

BRISTOL CITY.

LLOYD'S REGISTER OF SHIPING  
RECEIVED  
11Z MAR. 1920  
LONDON

Bristol City



© 2020  
Bros. 10464.

Lloyd's Register  
W1177-0043