

W1179-0224


MIDSHIP SECTION (AS BUILT)

"
M.S. THERMOPYLÆ"

CPN. 8271.

YARD N^o 569

MESSRS BURMEISTER & WAIN

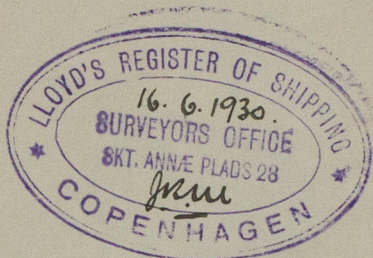

PLANS TRANSFERRED
TO SISTER VESSEL

[Handwritten signature]

RETAIN



© 2020

Lloyd's Register
Foundation