

SCALE $\frac{1}{8}" - \frac{1}{4}" = 1' - 0"$

$$\underline{a_2 = 51.58 - 2.85 = 27.73}$$

WATERTIGHT BULKHEAD 138
SHELL & BOTTOM ANGLES: 3°: 3½: 4° SINGLE
DECK ANGLES: 3°: 3°: 4°: 3° SINGLE
STIFFENERS BELOW 3° DECK: 3° SPACING
12' 3½'. 54" BRACKETED TO PL. BOTTOM
STIFFENERS ABOVE 3° DECK: 3° SPACING
3°: 2½: 3½ LUGGED TOP & BOTTOM.

WATERTIGHT BULKHEAD 39.
SHELL BOTTOM ANGLES: 3"x3"x 42" SINGLE
DECK ANGLES: 3"x3"x36" SINGLE
STIFFENERS: 10.5"x 4.4" SPACED 30" APART
BRACKETED TOP & BOTTOM

W1179-0225


PROFILE & DECKS (AS BUILT)

M.S. 'THERMOPYLÆ'

C.P.N. 8271.

YARD N^o 569

MESSRS BURMEISTER & WAIN.

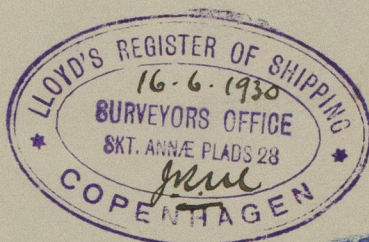

~~PLANS TRANSFERRED
TO SISTER VESSEL~~

Loja

RETAIN



© 2020

Lloyd's Register
Foundation