

23.7.23.

Nº 1235 SHIP.


PROFILE AND DECKS.

SCALE 1/8" = ONE FOOT.

237'-0" B.P. x 35'-0" MLD x 17'-9" MLD TO UPPER DECK.

TO CLASS LLOYDS (100A). FULL SCANTLING VESSEL.

Handlines, winches, hoists
stern gear & supported to
satisfactory satisfaction.

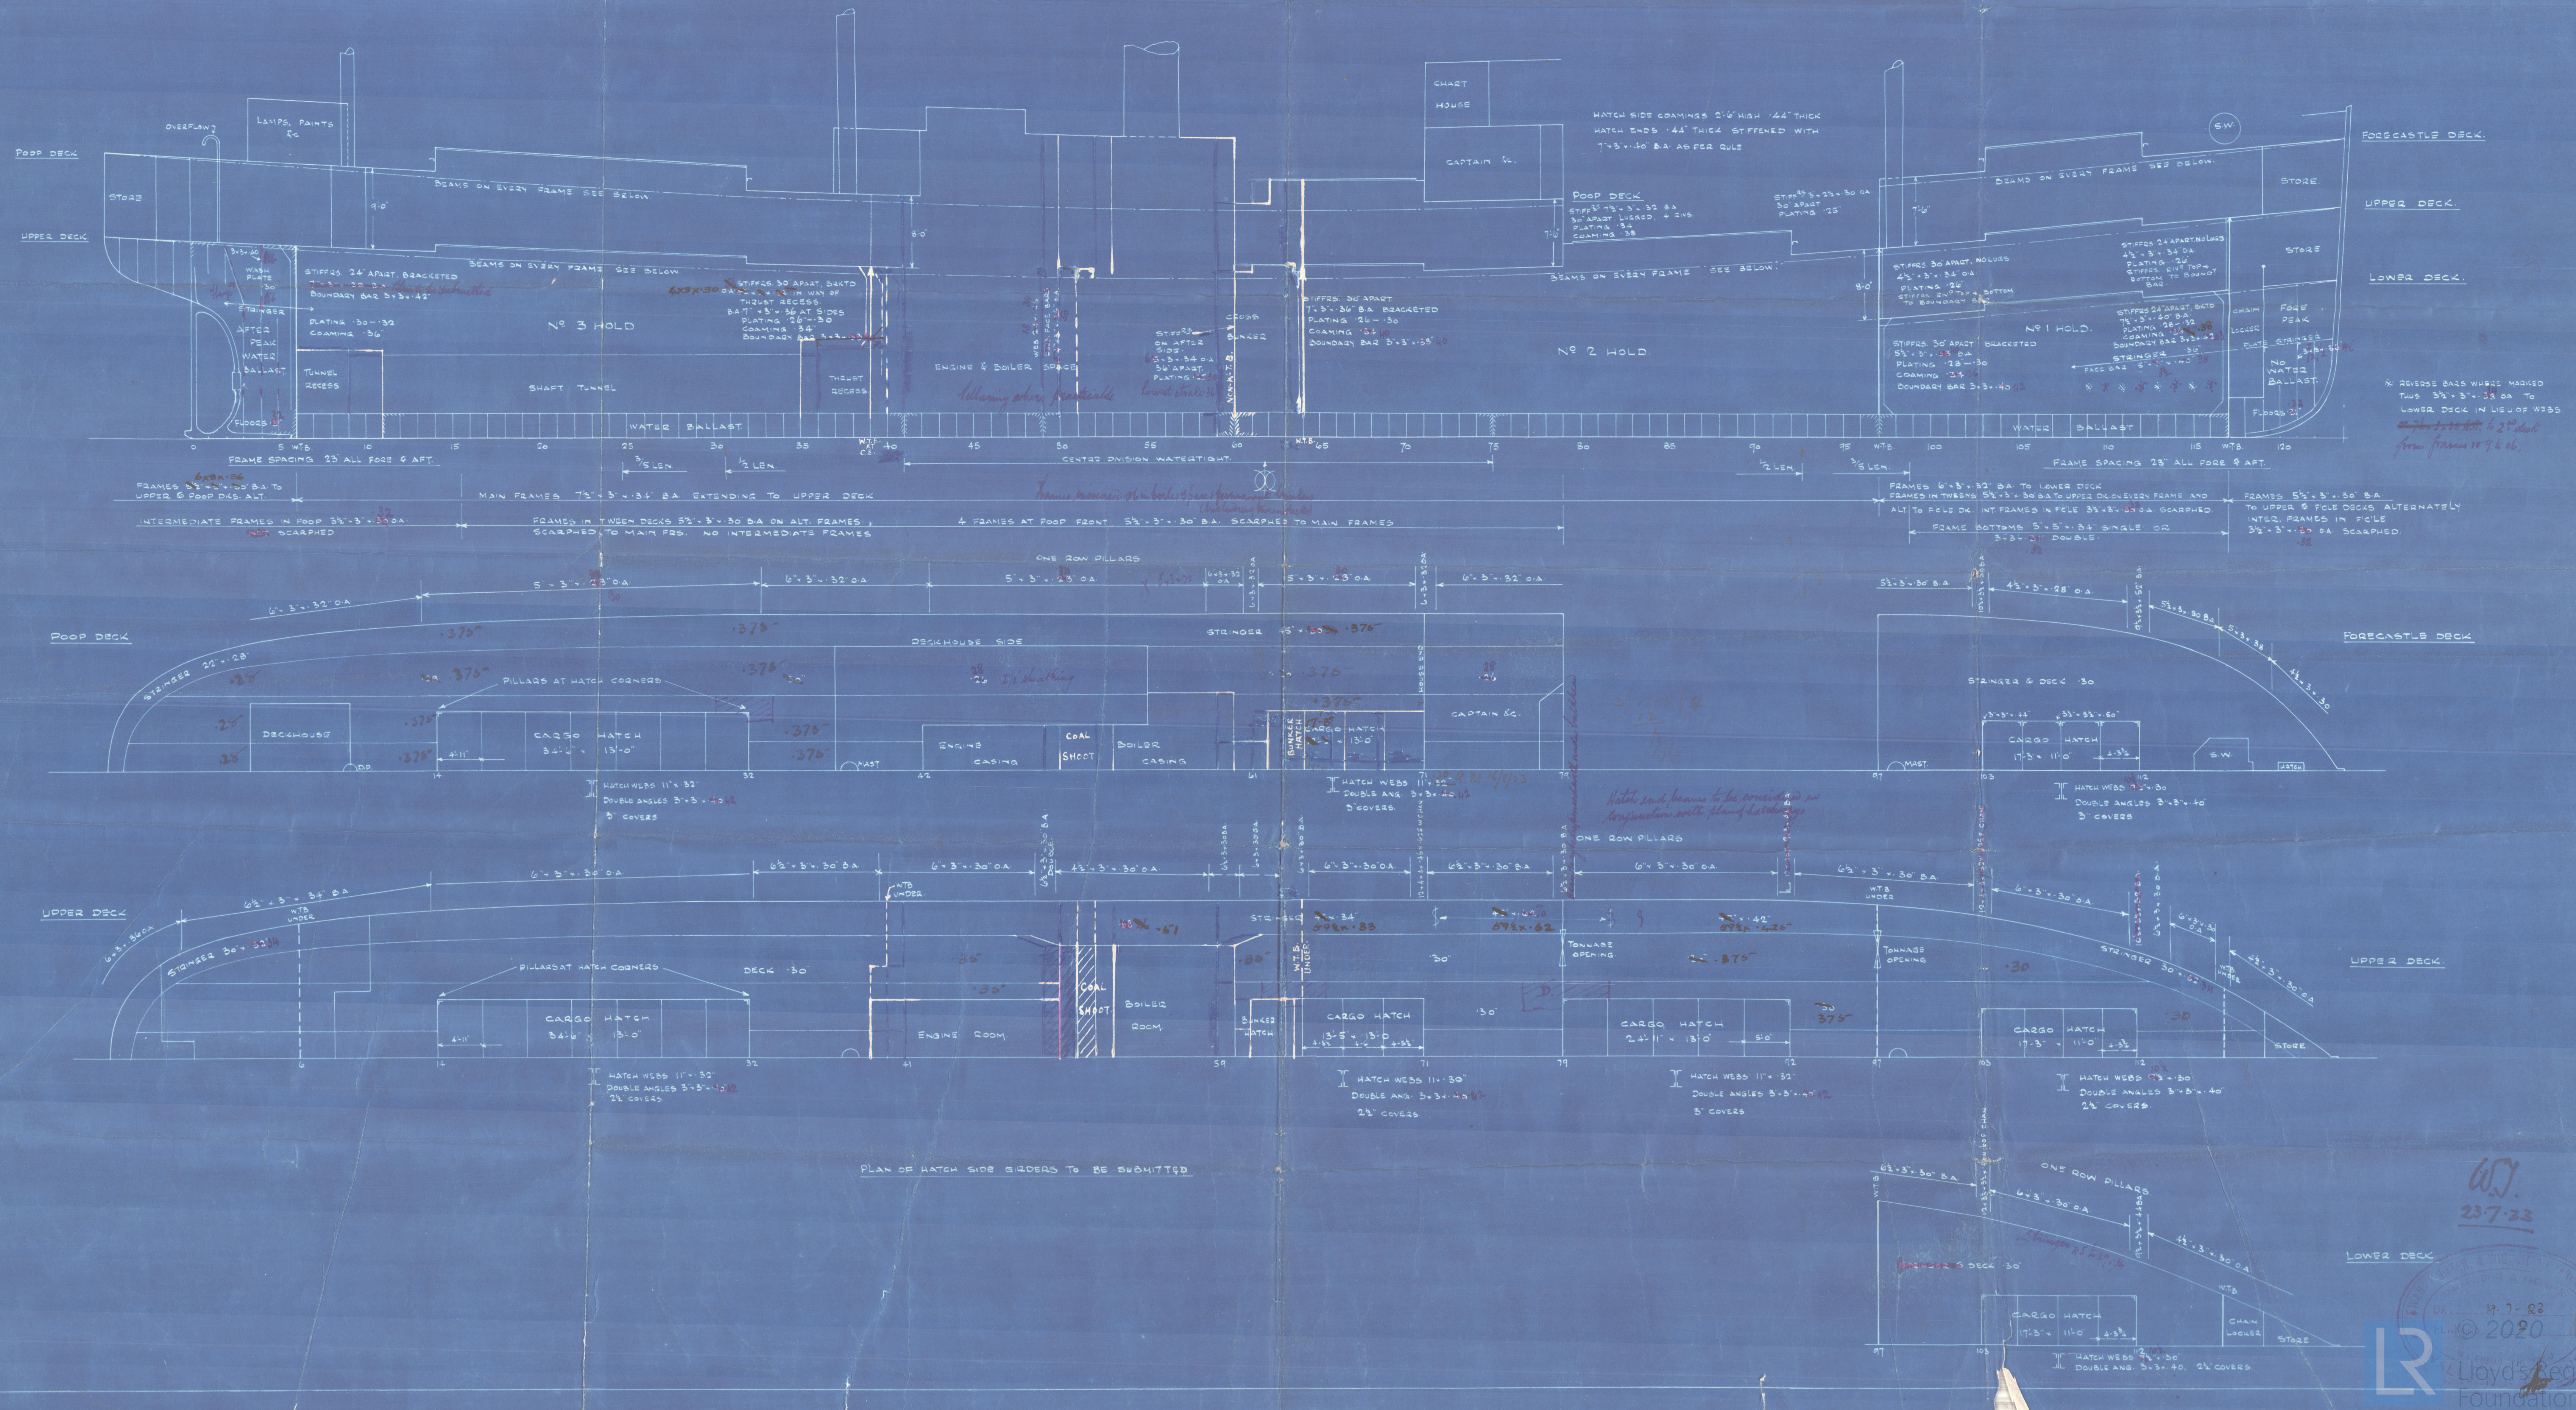

RECEIVED
JUL 24 1928
WALLSEND.

S/S No 1235.

(2)

Profile & Pk. Plans
~~in minimum~~

Recd from Loyals
24th July. /23.

Swan & Hunter.



See plan as "built."

S.S. SALMO.
NEWCASTLE ON TYNE.

Report No. 77784.

W118-0015



© 2020

Lloyd's Register
Foundation