

N^o 1235 SHIP.



PROFILE AND DECKS.

SCALE 1/8" = ONE FOOT.

237'-0" BP x 35'-0" MLD x 17'-9" MLD TO UPPER DECK.

TO CLASS LLOYDS 100A1. FULL SCANTLING VESSEL.

WINDLASS, WINCHES MASTS, STEERING GEAR, ETC.,
SUPPORTED TO SURVEYORS SATISFACTION

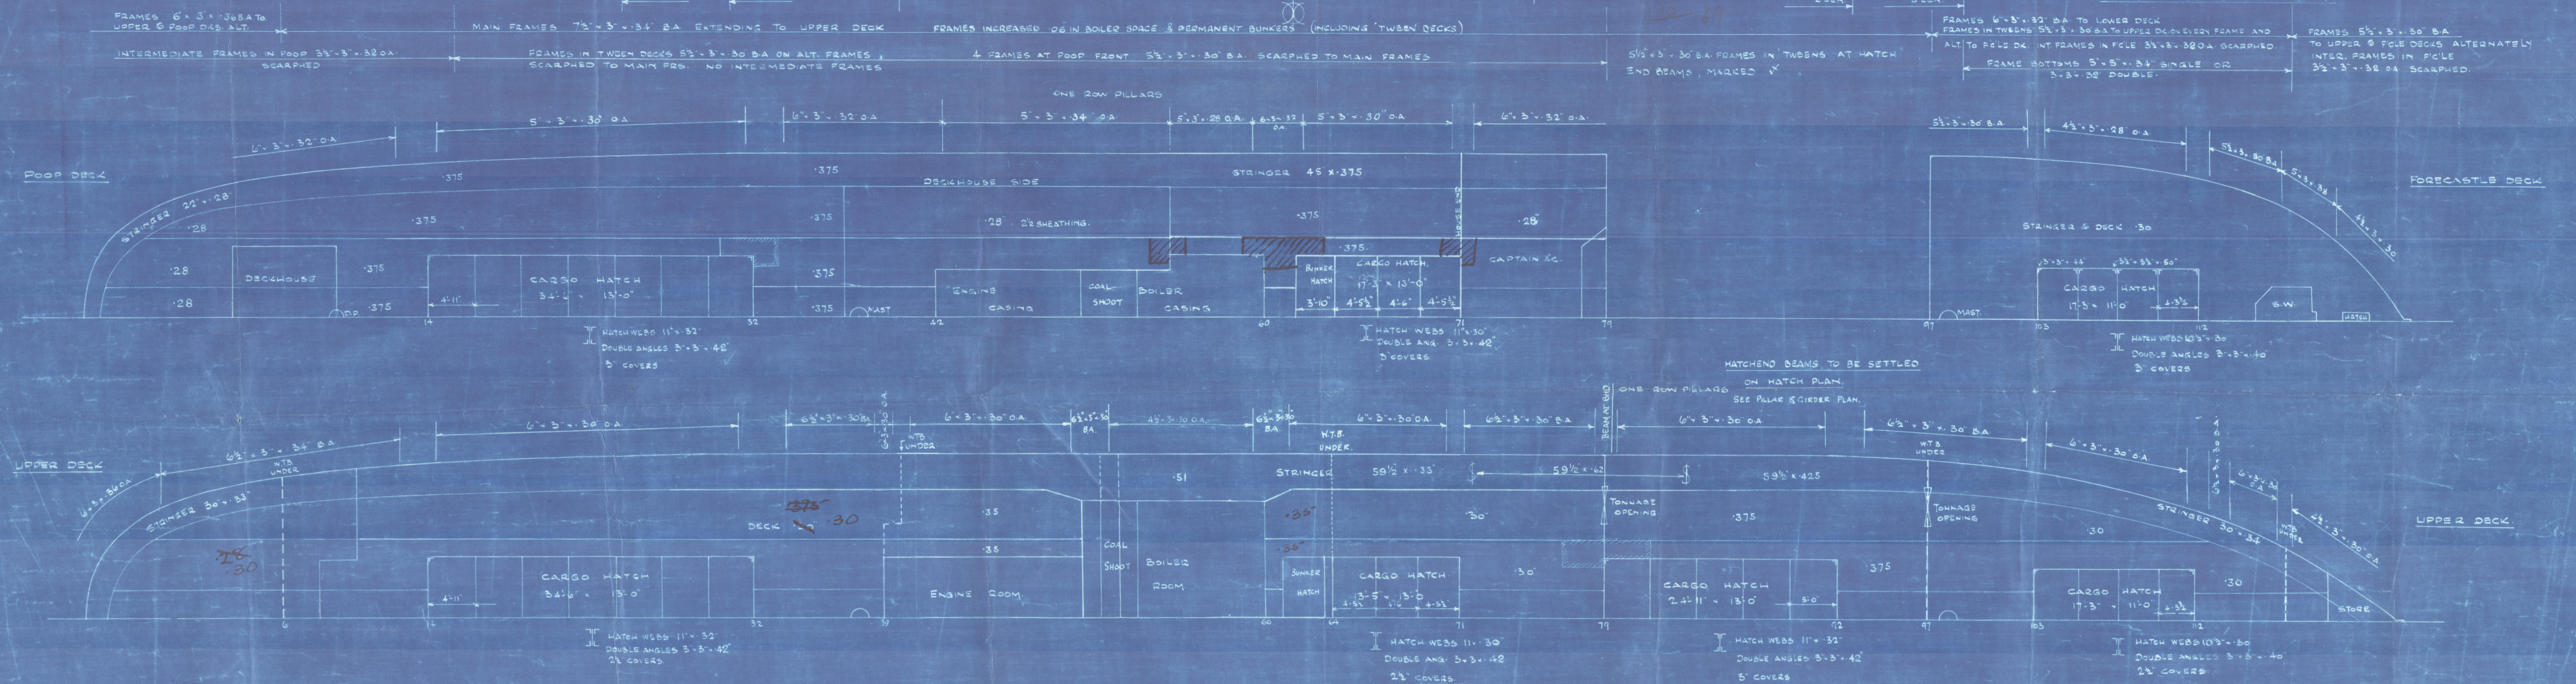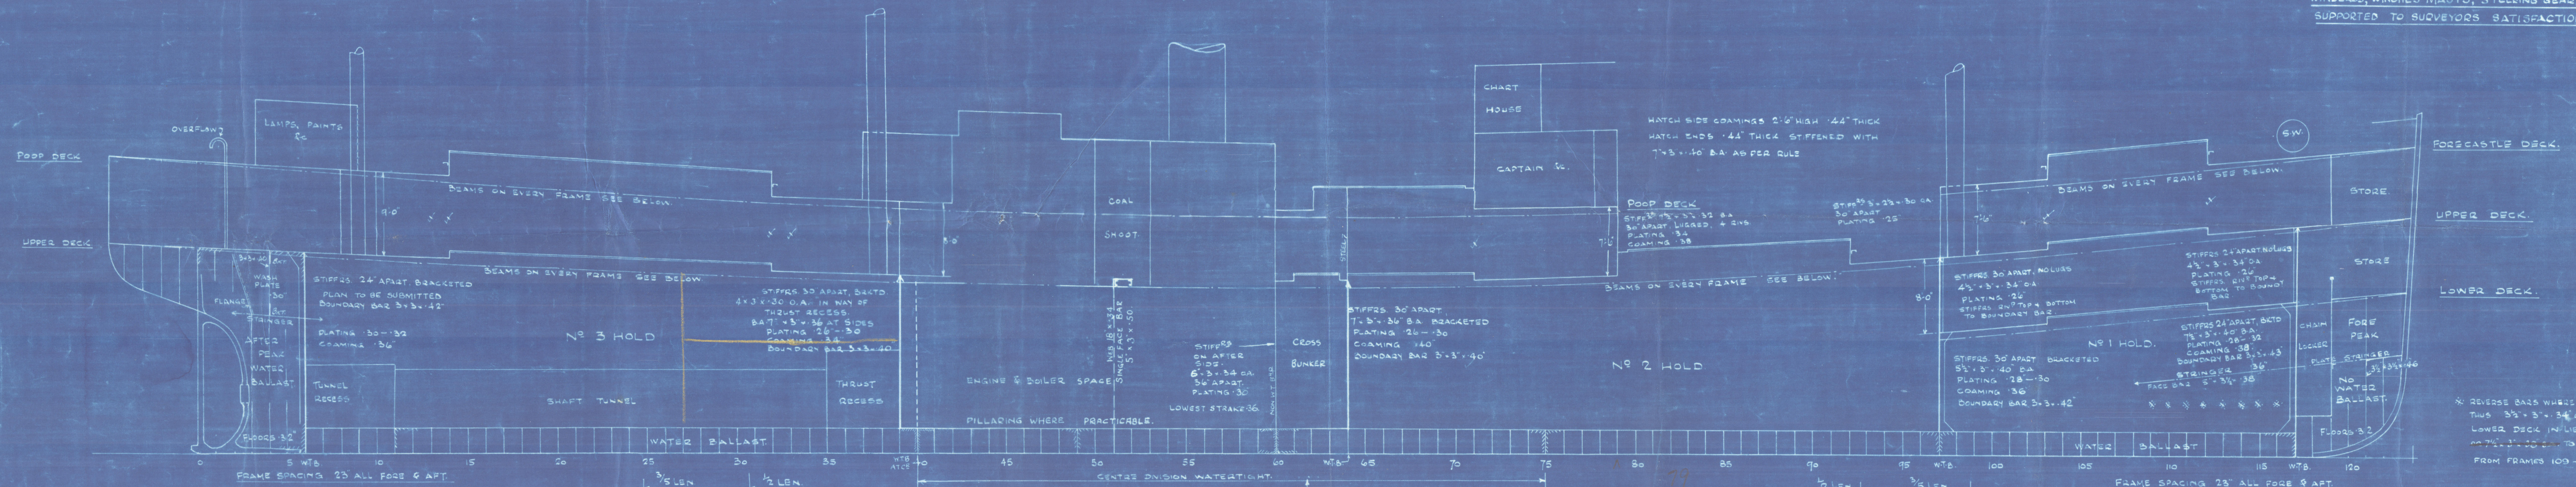

PLAN OF HATCH SIDE ORDERS TO BE SUBMITTED



DATE 15-4-24
PLAN NO. 97-1-23
LLOYD'S REGISTER
15-4-24
OWNERS 24-25
LONDON 1-25

Swan & Hunter.

No. 1235

S/S. "Salmo"

Profile & decks (as built)

S. S. SALMO.

NEWCASTLE ON TYNE.

Report No. 77784.

W118-0016



© 2020

Lloyd's Register
Foundation