

HEATING SURFACE IN TUBES	2259 SQ. FT.
HEATING SURFACE - COMB. CHAMBERS	213 SQ. FT.
HEATING SURFACE - FURNACES	174 SQ. FT.
HEATING SURFACE - TOTAL	2706 SQ. FT.
GRATE AREA - 9.6" BARS	60.5 SQ. FT.
RATIO - H.S. + G.A.	4.47
WORKING PRESSURE	170 LBS.
HYDROSTATIC PRESSURE (LLOYDS)	380 LBS.
SAFETY VALVE	3 1/2" TWIN

MATERIAL	REQ.	QTY.	QTY.
OPEN HEARTH STEEL	SPRUE PLATES	62720 LBS.	71500 LBS.
OPEN HEARTH STEEL	BUTT STRAPS	58240 LBS.	67000 LBS.

LONGITUDINAL SEAMS

SHELL - 1 1/2" - 1 1/2" BUTTSTRAPS - 1 1/2" - O.S. BUTTSTRAPS - 1 1/2"

RIVETS - 1 1/2" HOLES - 1 1/2"

1 1/2" - 1 1/2" x 100 = 82% STRENGTH OF PLATE.

1 1/2" x 100 = 82% STRENGTH OF RIVET.



























































SHELL PLATES.	PRESSURE -	62720 LBS.	= 196 *
HEADS IN STEAMSPACE.	PRESSURE -	1750 LBS.	= 196 *
GIRDERS.	PRESSURE -	975 LBS.	= 230 *
TOP OF COMB. CHAMBERS.	PRESSURE -	487 LBS.	= 210 *
BACK OF COMB. CHAMBERS.	PRESSURE -	243 LBS.	= 228 *
BOTTOM OF COMB. CHAMBERS.	PRESSURE -	121 LBS.	= 225 *
TUBE SHEET.	PRESSURE -	62720 LBS.	= 267 *
MAIN STAYS (3/4" DIA.)	PRESSURE -	975 LBS.	= 209 *
SCREW STAYS (1/2" DIA.)	PRESSURE -	487 LBS.	= 256 *
SCREW STAYS (3/4" DIA.)	PRESSURE -	975 LBS.	= 260 *
STAYS AT TOP OF COMB. CHAMBER.	PRESSURE -	487 LBS.	= 253 *
FURNACES.	PRESSURE -	1750 LBS.	= 211 *
SAFETY VALVE	AREA -	2074 x 255	= 15.3 sq"
SIDE OF COMB. CHAMBERS	PRESSURE -	120 x 255	= 221 *

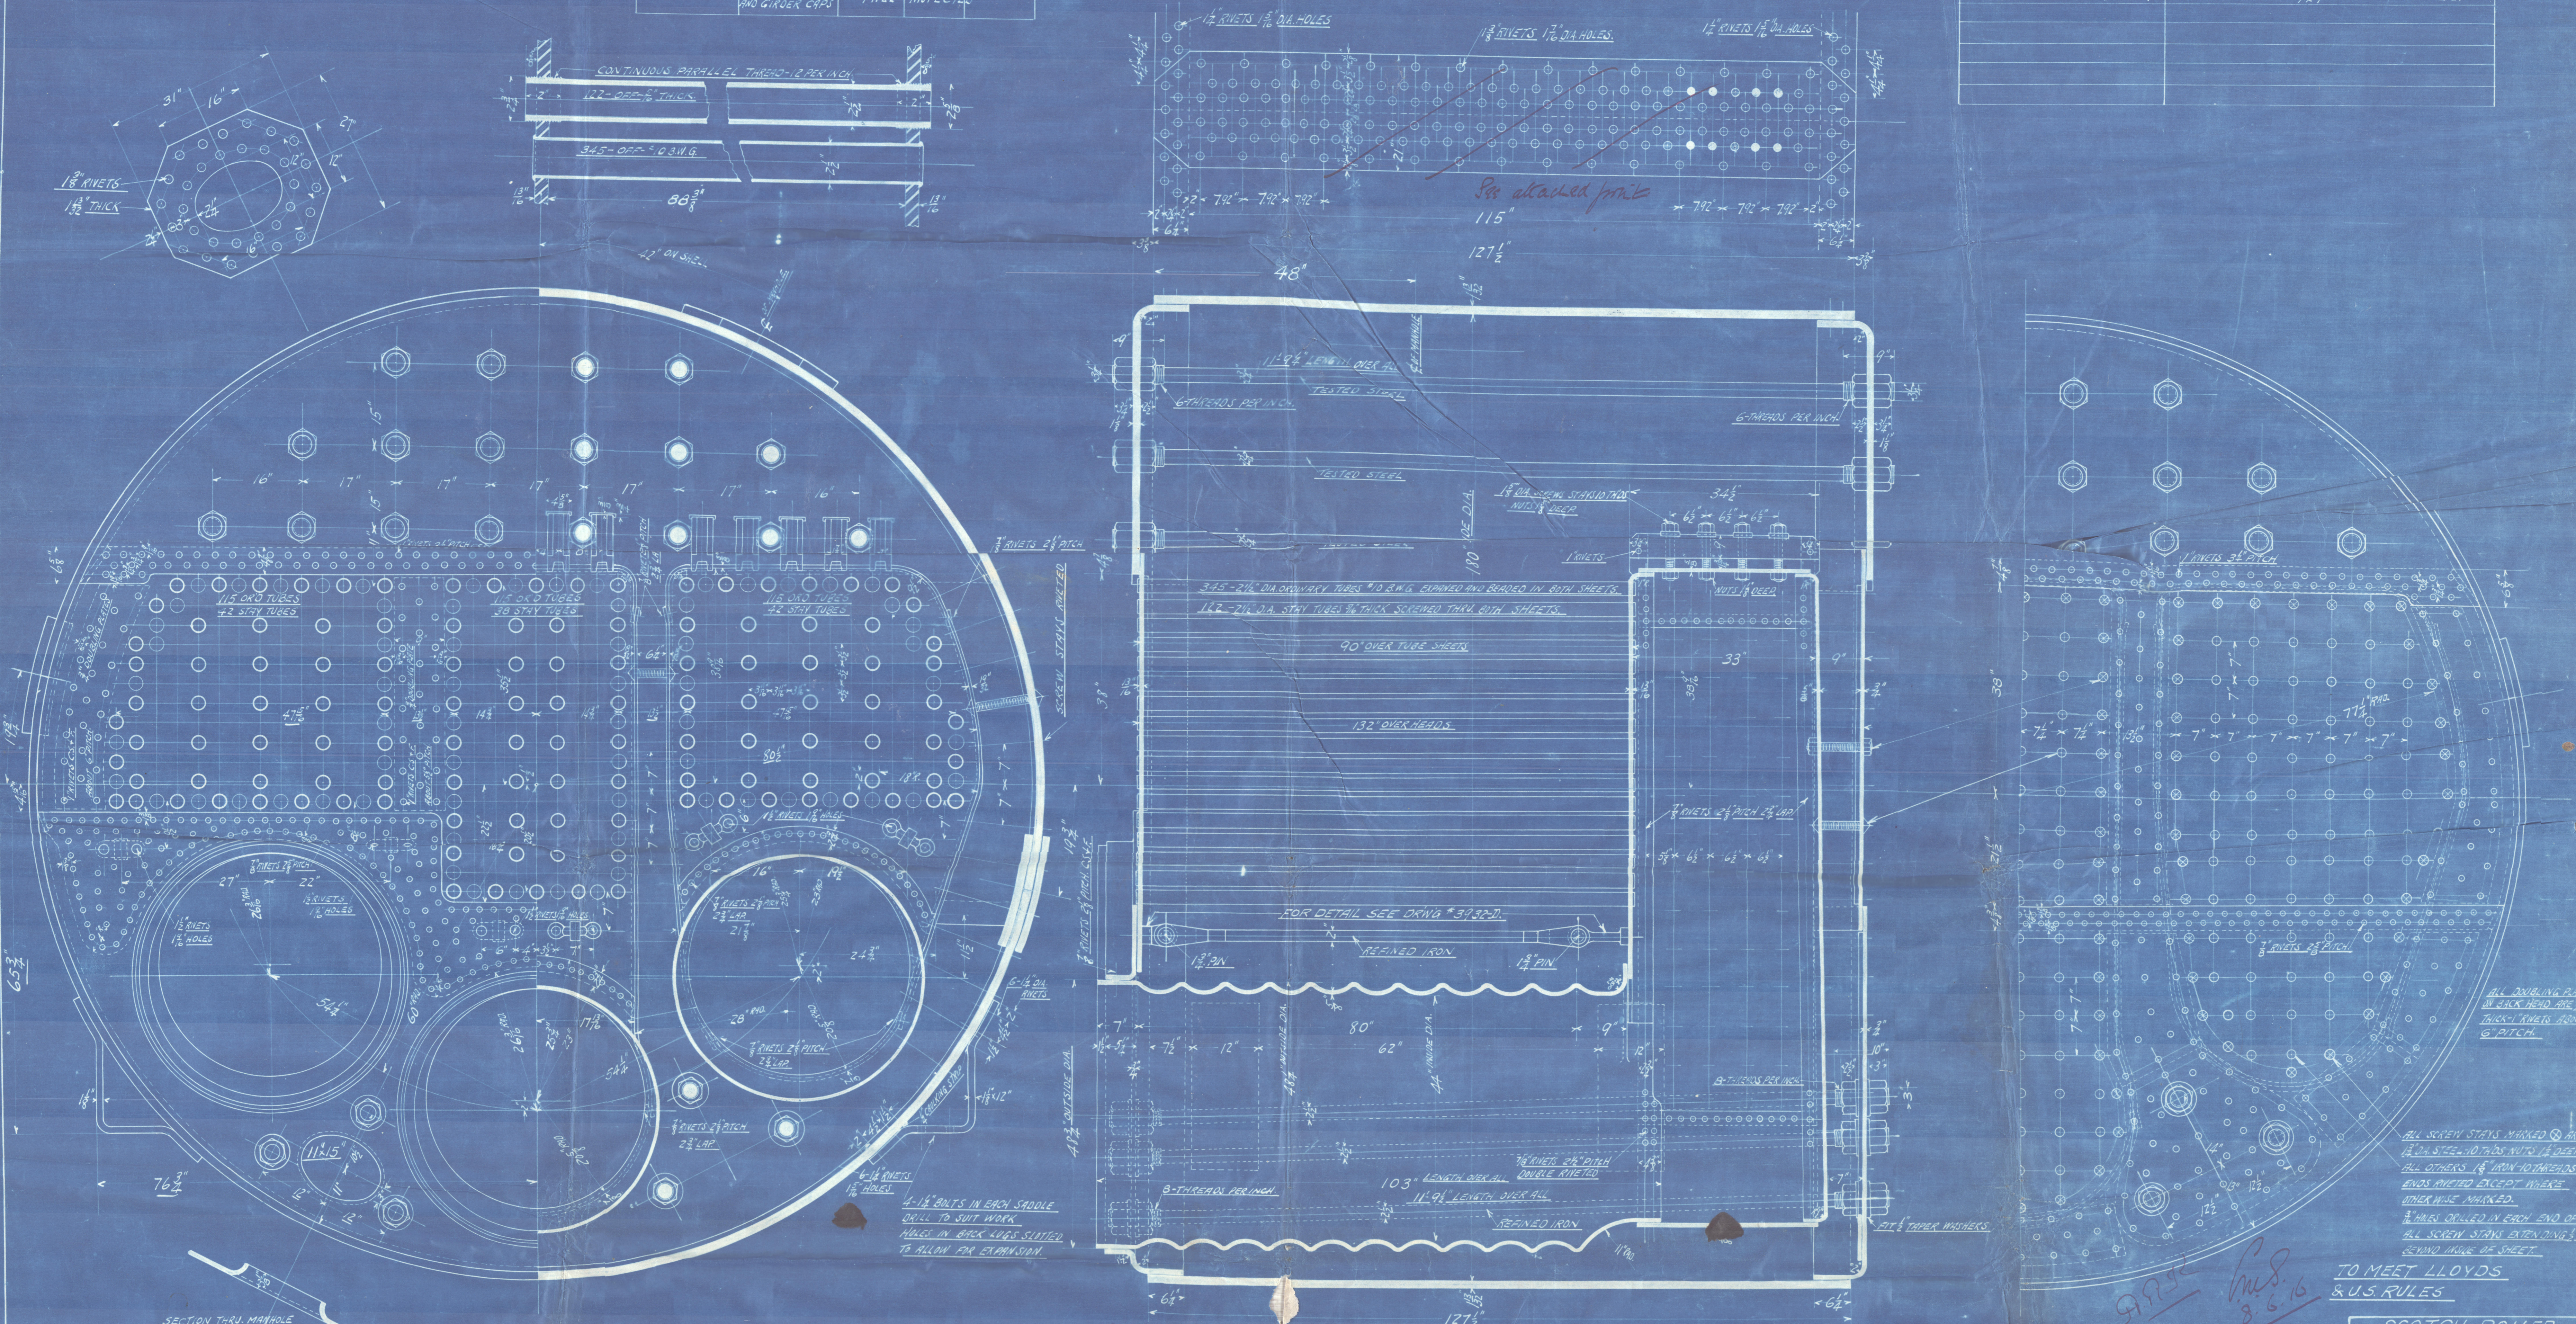

ALL DOUBLING PLATE IN JACK HEAD SHEET 3" THICK - RIVETS ABOUT 6" PITCH.

ALL SCREW STAYS MARKED @ ARE 1/2" DIA STEEL NO TUBE NUTS 1/2" DEEP ALL OTHERS 1/2" DIA TUBES ENDOS RIVETS EXCEPT WHERE OTHERWISE MARKED.

ALL RIVETS IN EACH END OF ALL SCREW STAYS EXTENDING 3" BEYOND INSIDE OF SHEET.

TO MEET LLOYDS & U.S. RULES

SCOTCH BOILER 15'0" DIA. - 11'0" LONG

		15°0'DIA. - 11°0'LONG	
		1916	
		1916	
Texas Steamship Co. *Sagadahoc*

Platen Island Ship Co.
Boilers.

(Vessels no 3 & 4.
Texas oil.)

24 May /16

Platen Island S.B. Co.
Boilers 299-304.



302 Bl.

MARK ON BOILER

No. 32
LLOYD'S TEST
285-
11/1/16 C.T.H.

Bl. 304

MARK ON BOILER

No. 34
LLOYD'S TEST
286-
28/2/16 O.T.J.

303 Bl.

MARK ON BOILER

No. 33
LLOYD'S TEST
286-
11/1/16 C.T.H.

Bl. 299-300 & 301.

MARK ON BOILER

No. 36-
LLOYD'S TEST
286-
28/2/16 O.T.J.

S.S. SAGADAHOC

W118-0034



© 2020

Lloyd's Register
Foundation