


13/3/22

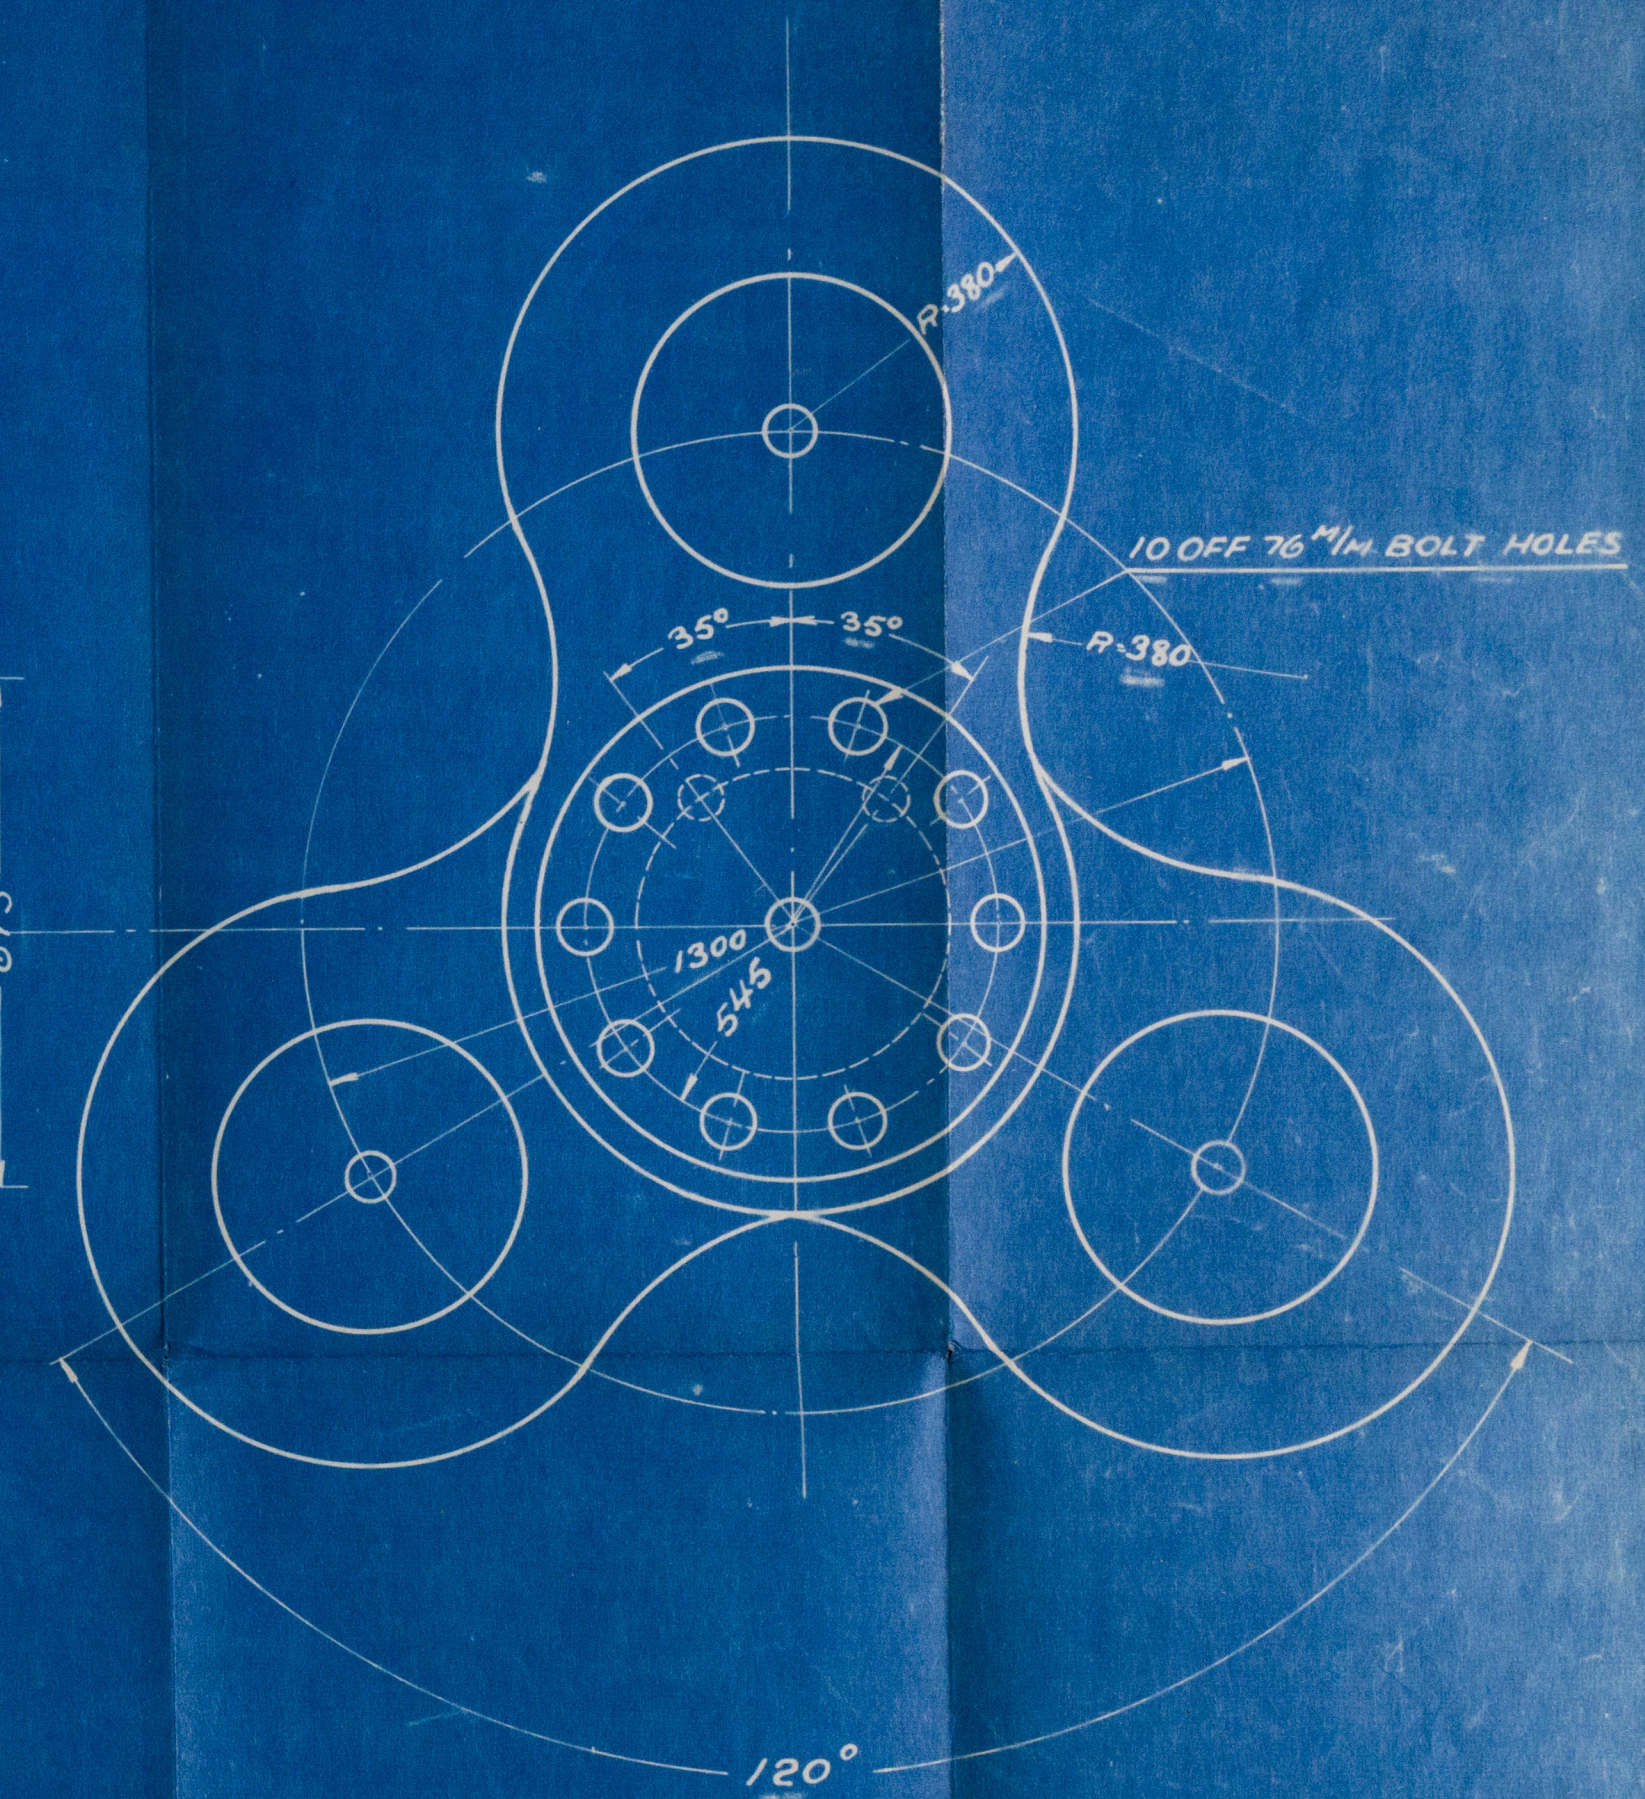

ODENSE VÆRFT 10

CYL. DIAM. 630 <sup>M</sup>/<sub>M</sub> - STROKE 1300 <sup>M</sup>/<sub>M</sub>

6-3-1922 © 2020

Lloyd's Register



Plan of

CRANK SHAFT FOR THE

MAIN DIESEL OIL ENGINE

to be constructed by

~~ANTHONY CRAMPTON~~  
BURMEISTER & WAINES  
MASKIN- OG SKIBSBYGGERI

*Copenhagen*

for the


Single Screw Motor Vessel.

Yard No 10

to be built by

Messrs Odense Staalskibsvarft  
(ved A. E. Möller.)

*Odense.*

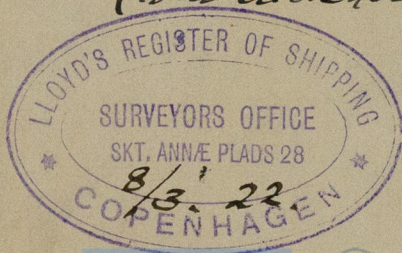

N<sup>o</sup> 14 SALLY MÆRSK. Cpn. Rpt. No 6574.

© 2020

Lloyd's Register  
Foundation

W118-0106