


AKTIESELSKABET
BURMEISTER & WAIN
MASKIN & SKIBSBYGGERI
28 - 2 - 1922 N° 28865

PLAN OF
THRUST, INTERMEDIATE
AND PROPELLER SHAFTS
 FOR THE DIESEL OIL ENGINE
 to be constructed by

ARTIFERISKABET
 BURMEISTER & WAIN
 MASKIN- OG SKIBSBYGGERI
 Copenhagen

for the
 Single Screw Motor Vessel
Yard N^o 10
 to be constructed by
 Mess^{rs} Odense Haalskibsværft.
 (and A. F. Møller)
 Odense.

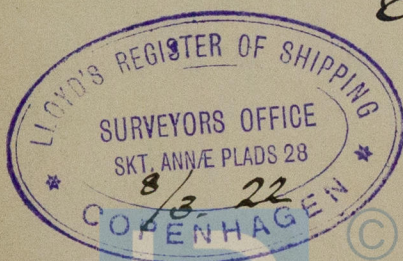

M^{rs} SALLY MERSK. Cpn. Rpt N^o 6574.