

16.1.32

HATCH CORNER IN SHELTER

HATCH CORNER IN DECK

PROFILE YAF No 10

CLASS: BRITISH LLOYDS.
MATERIAL: STEEL
TYPE: CLOSED SHELTER
DRAUGHTS DEEP AS POSSIBLE
SPEED: 10 KNOTS
ALL THICKNESSES 9 INCH

CLASS: BRITISH LLOYDS.


DIMENSIONS:

HEIGHT OUTSIDE STEM AND STERNPOST	33'-0"
INSIDE	32'-6"
BREADTH MOULDED	44'-0"
DEPTH TO MAINDECK	21'-11"
SHELTERDECK	28'-11"
HEIGHT OF FORECASTLEDECK	7'-0"
BOATDECK	7'-0"
CAPTAIN HOUSE	7'-0"
CHART HOUSE	7'-0"

SCALE 1/8"=1 FOOT

FOR PEAKDECK & STRINGERS SEE SPECIAL PLAN

WINCHES, WINDLASS, STEERING GEAR SUPPORTED TO SURVEYORS SATISFACTION

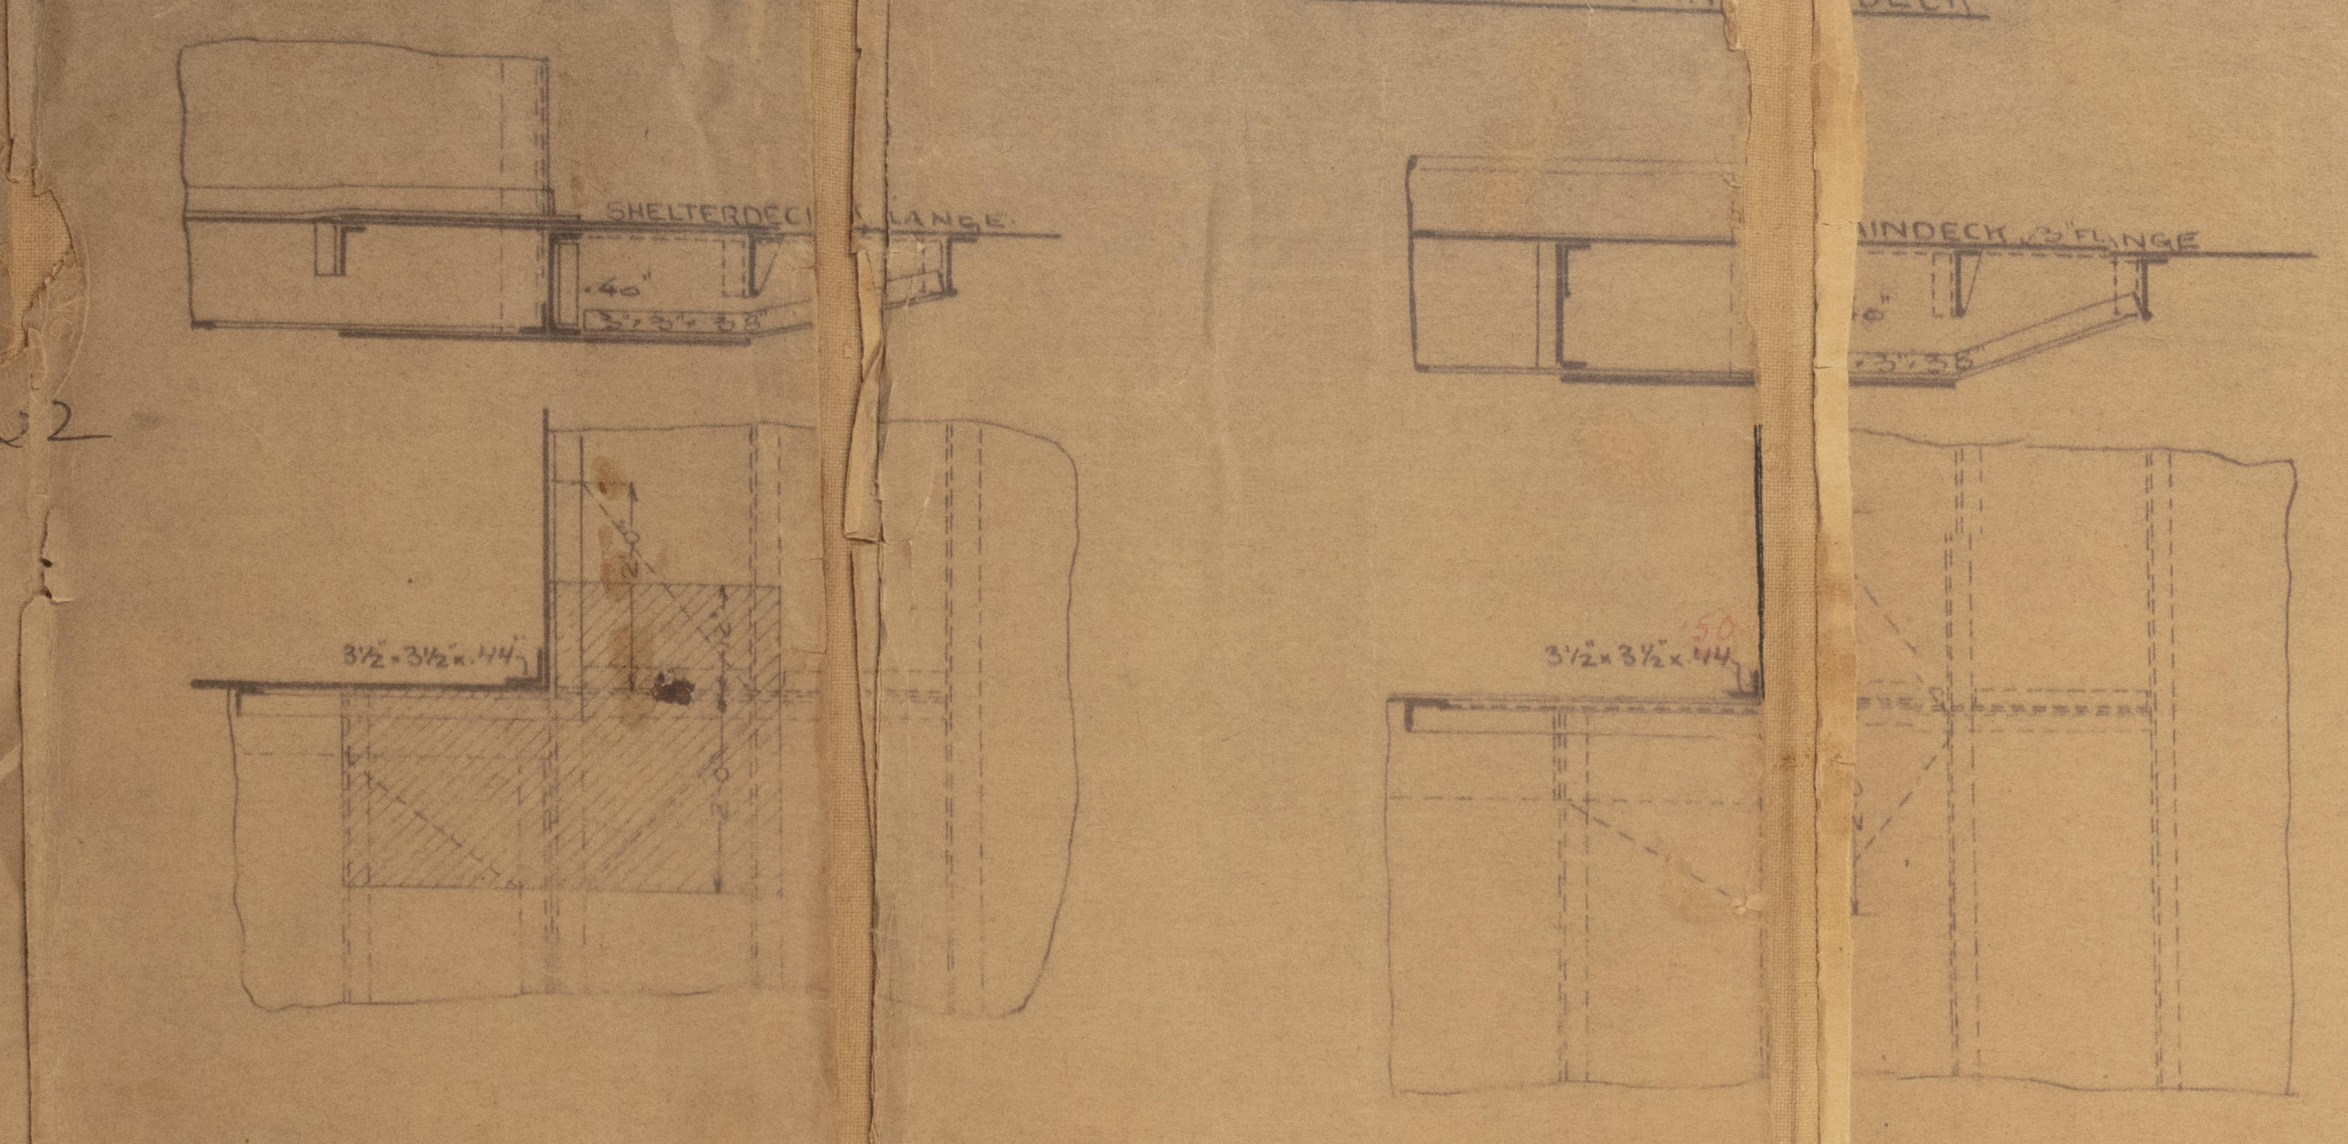

HATCH-END BEAMS

HATCH-SIDE COAMINGS






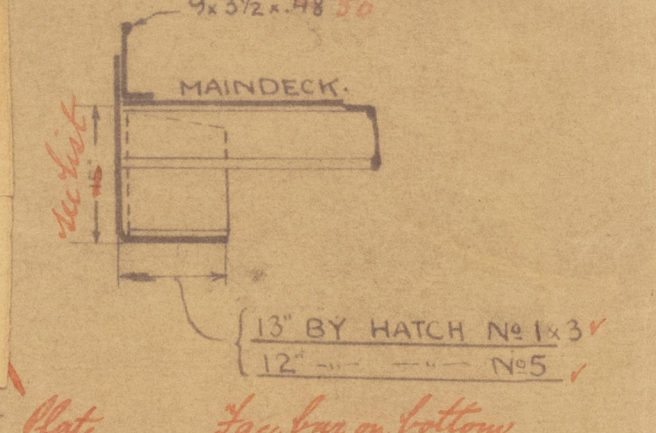











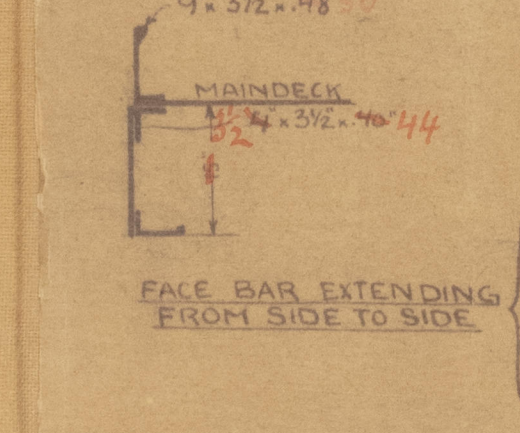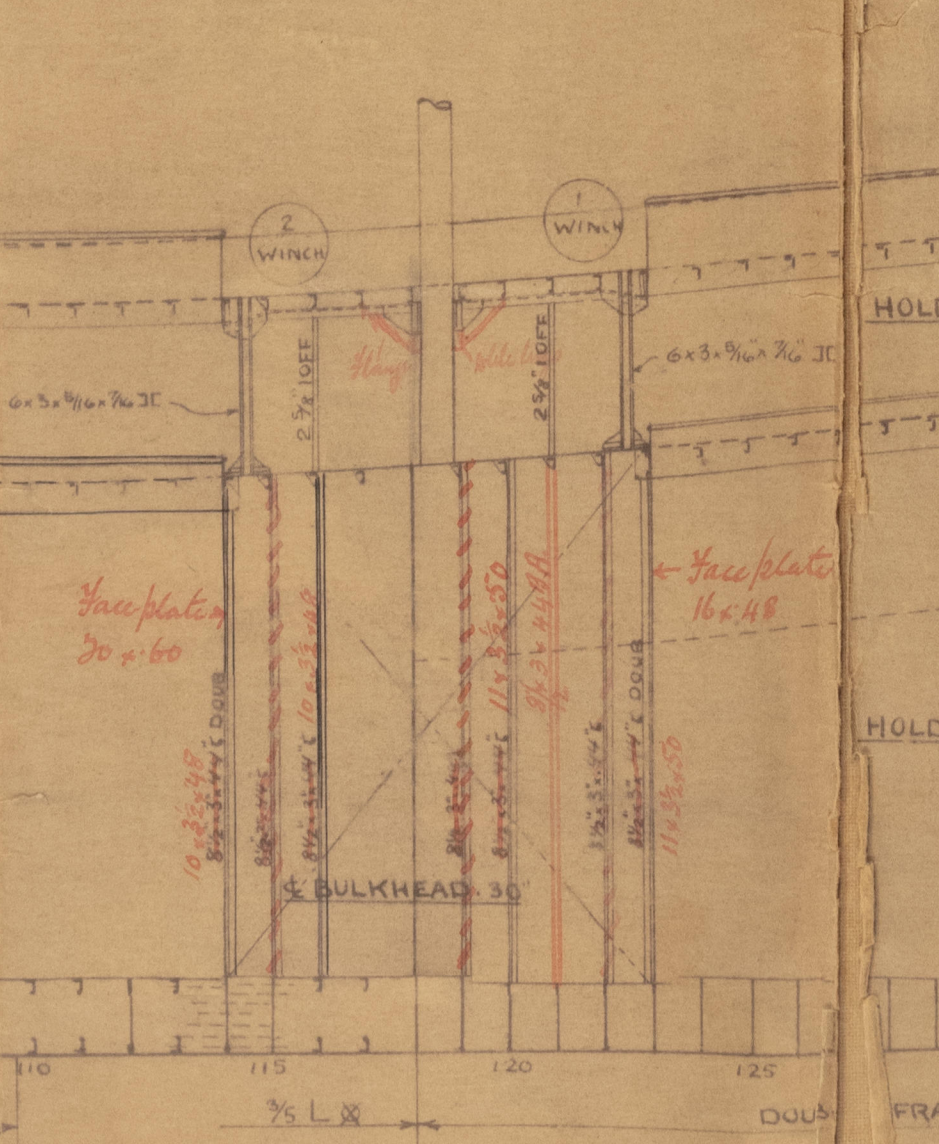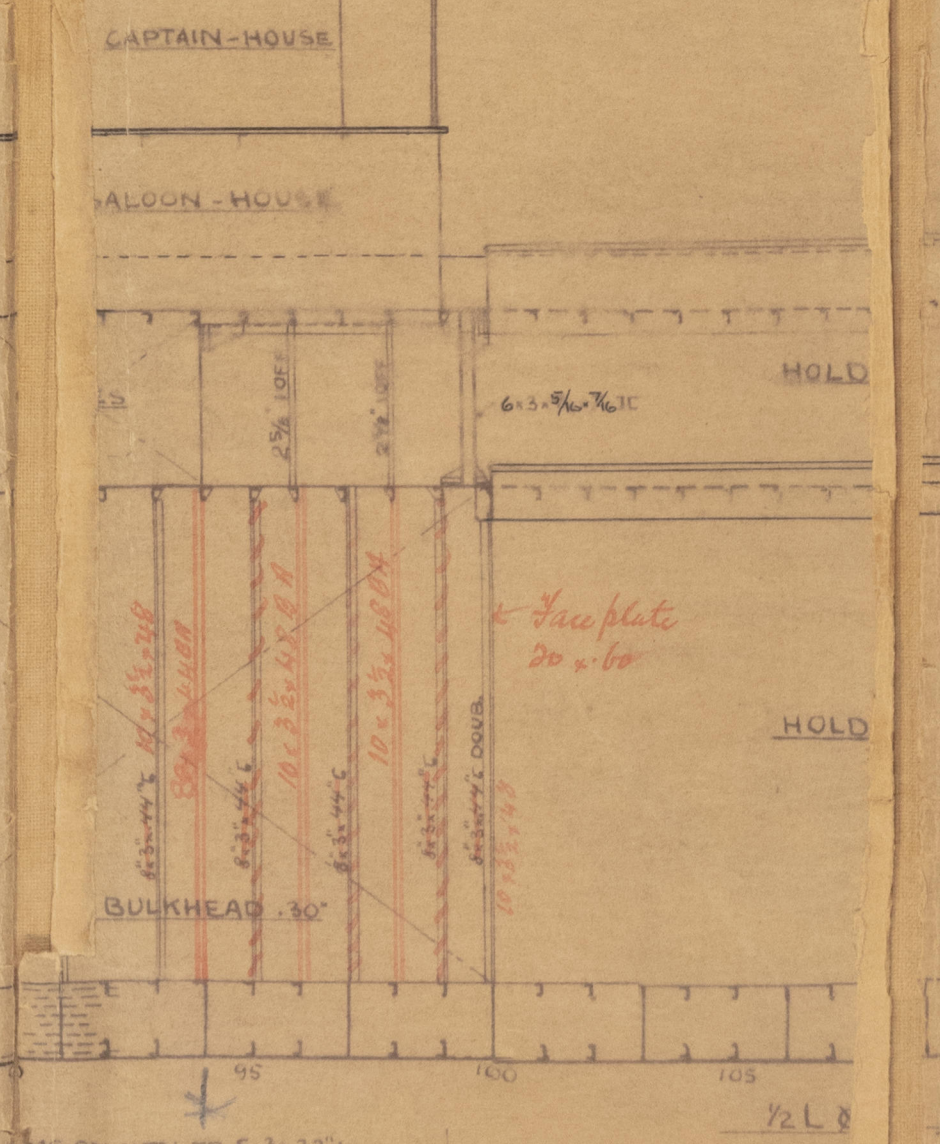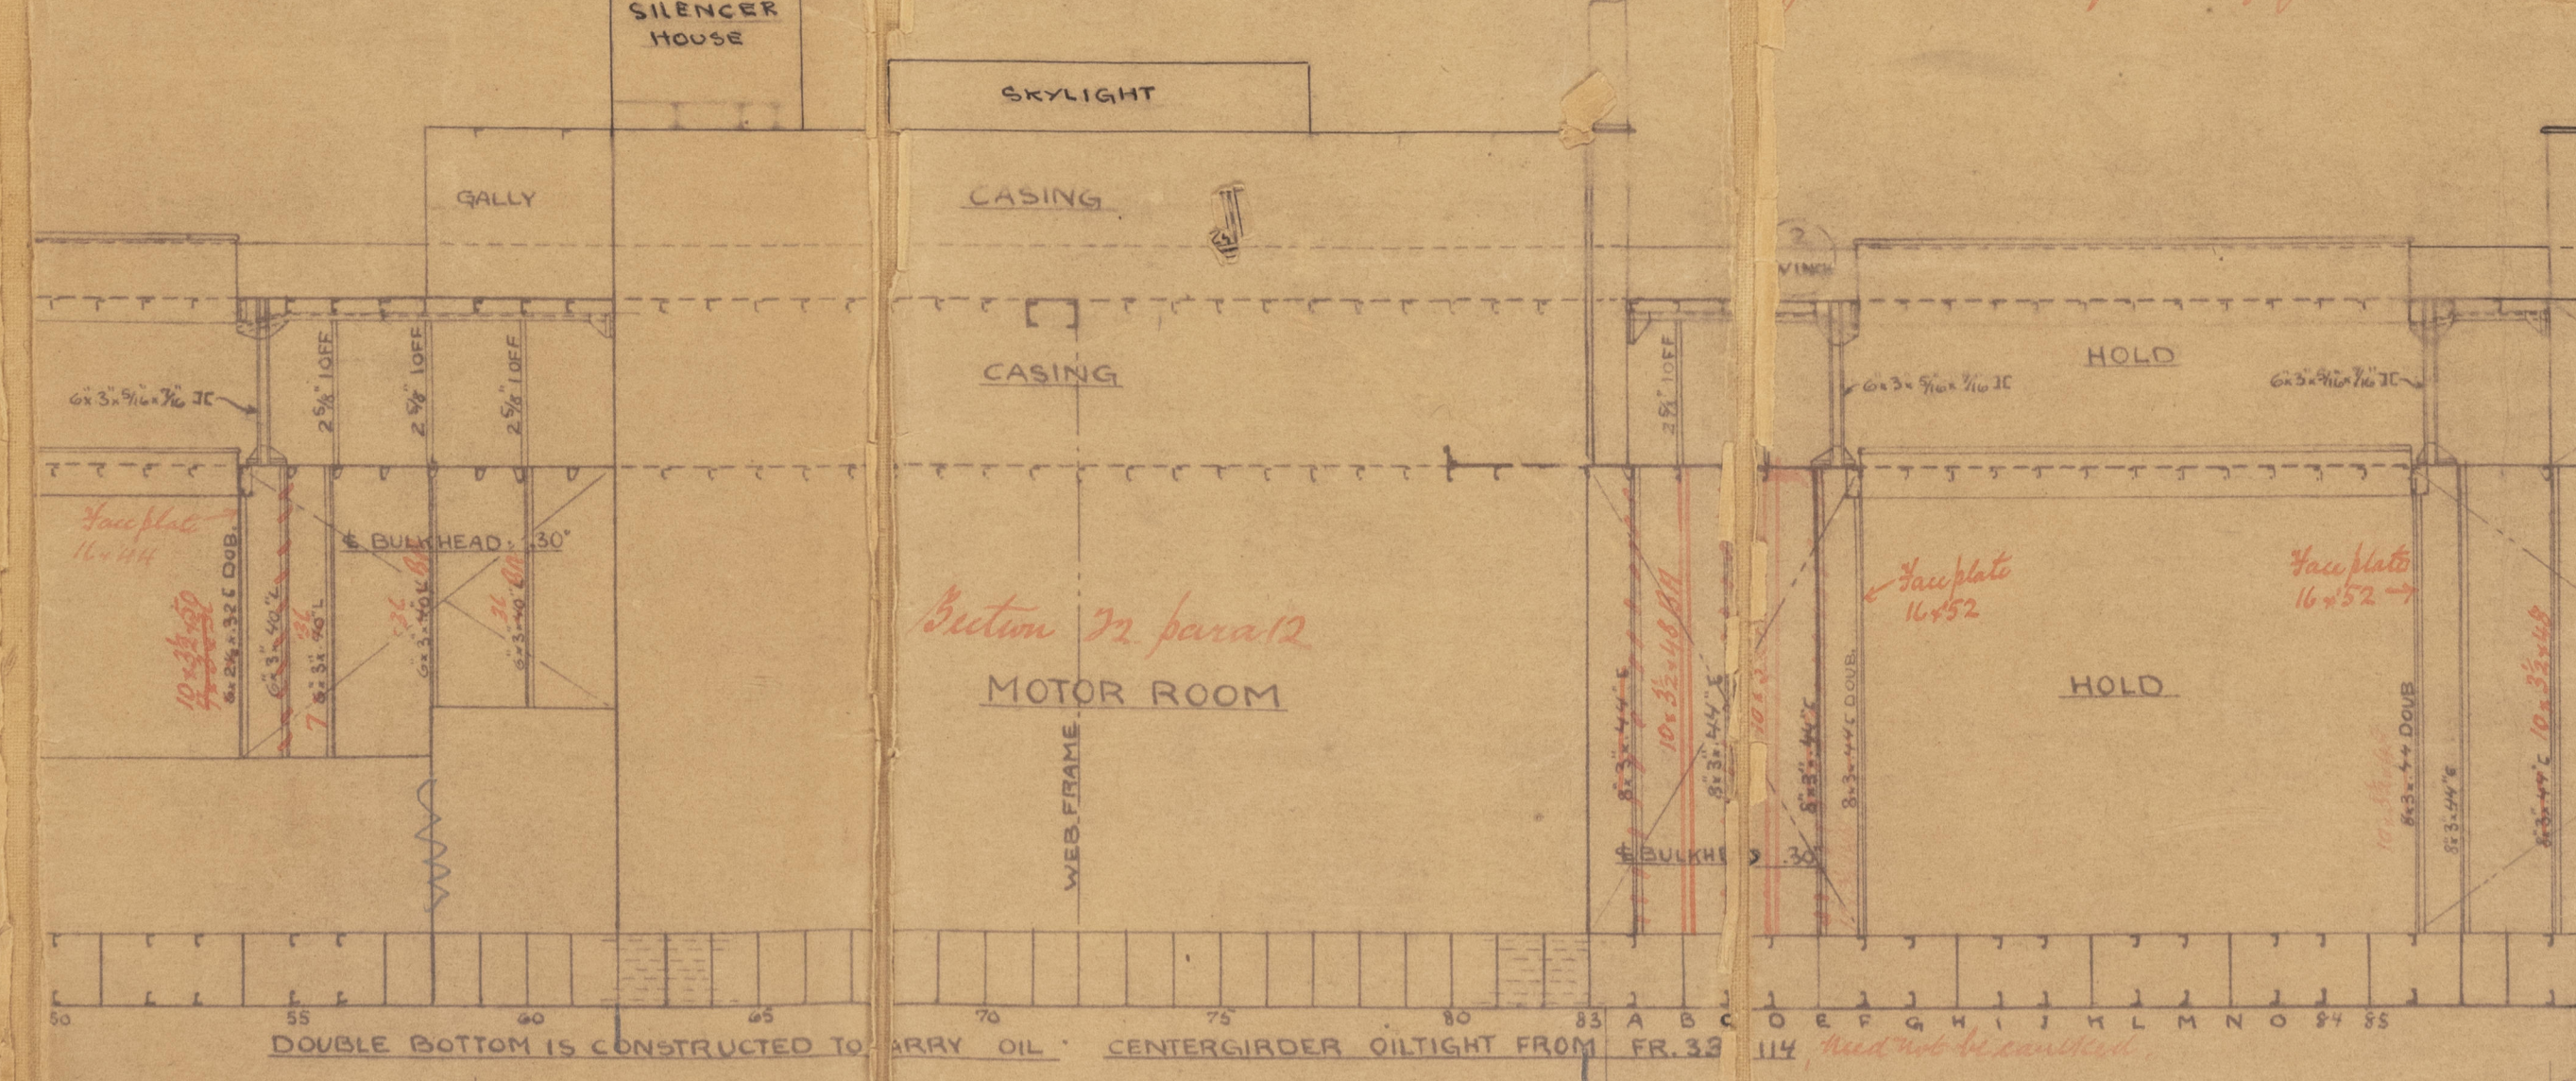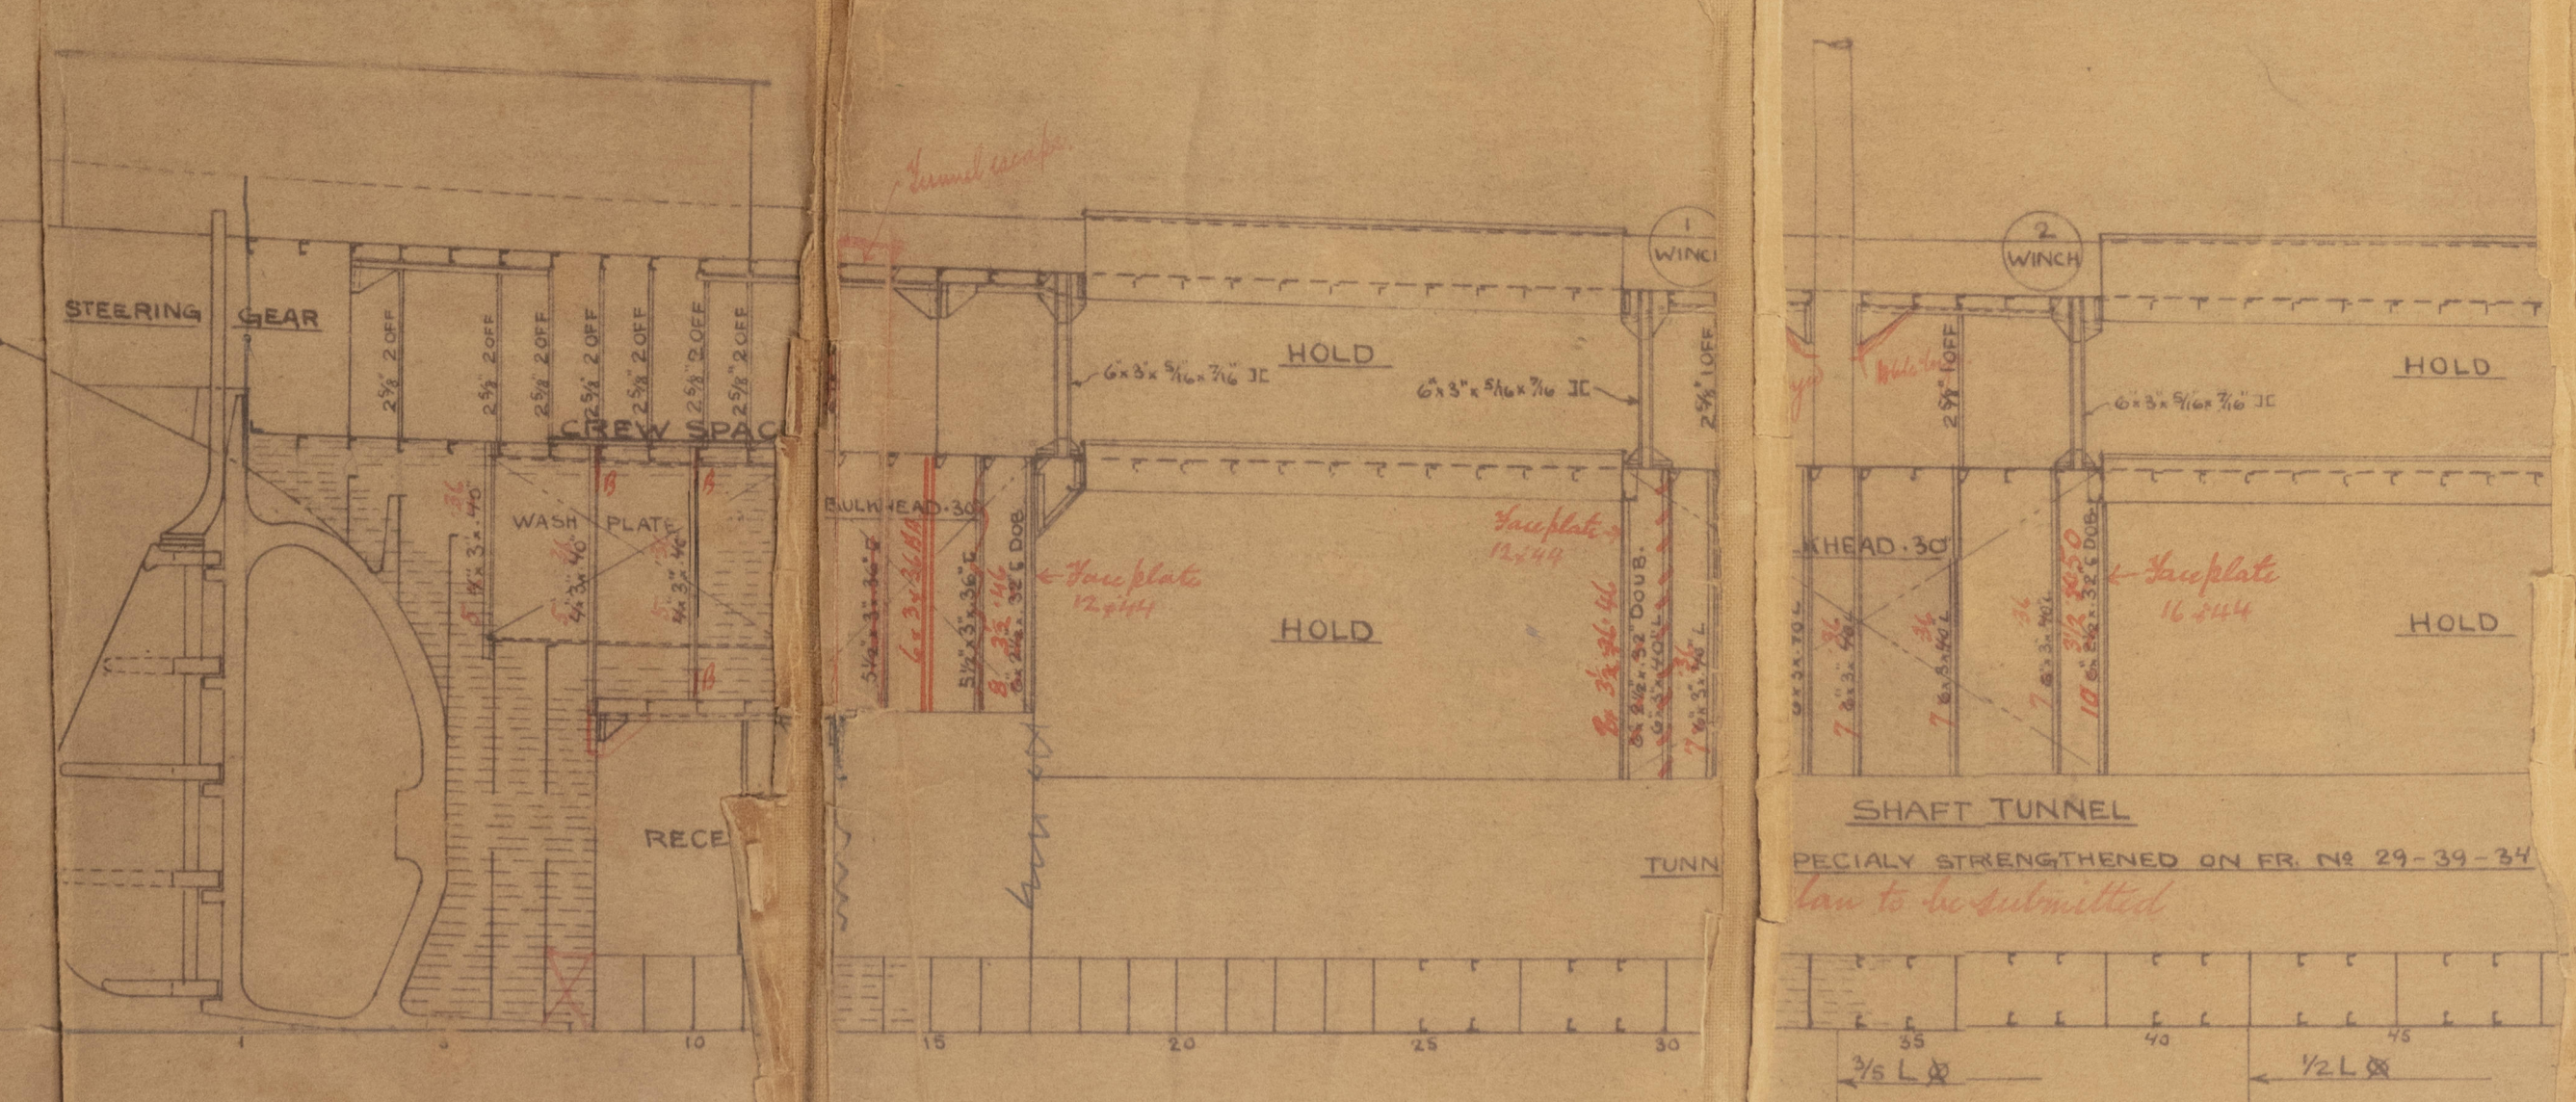





BEAMS NOT EXCEEDING

DECK

 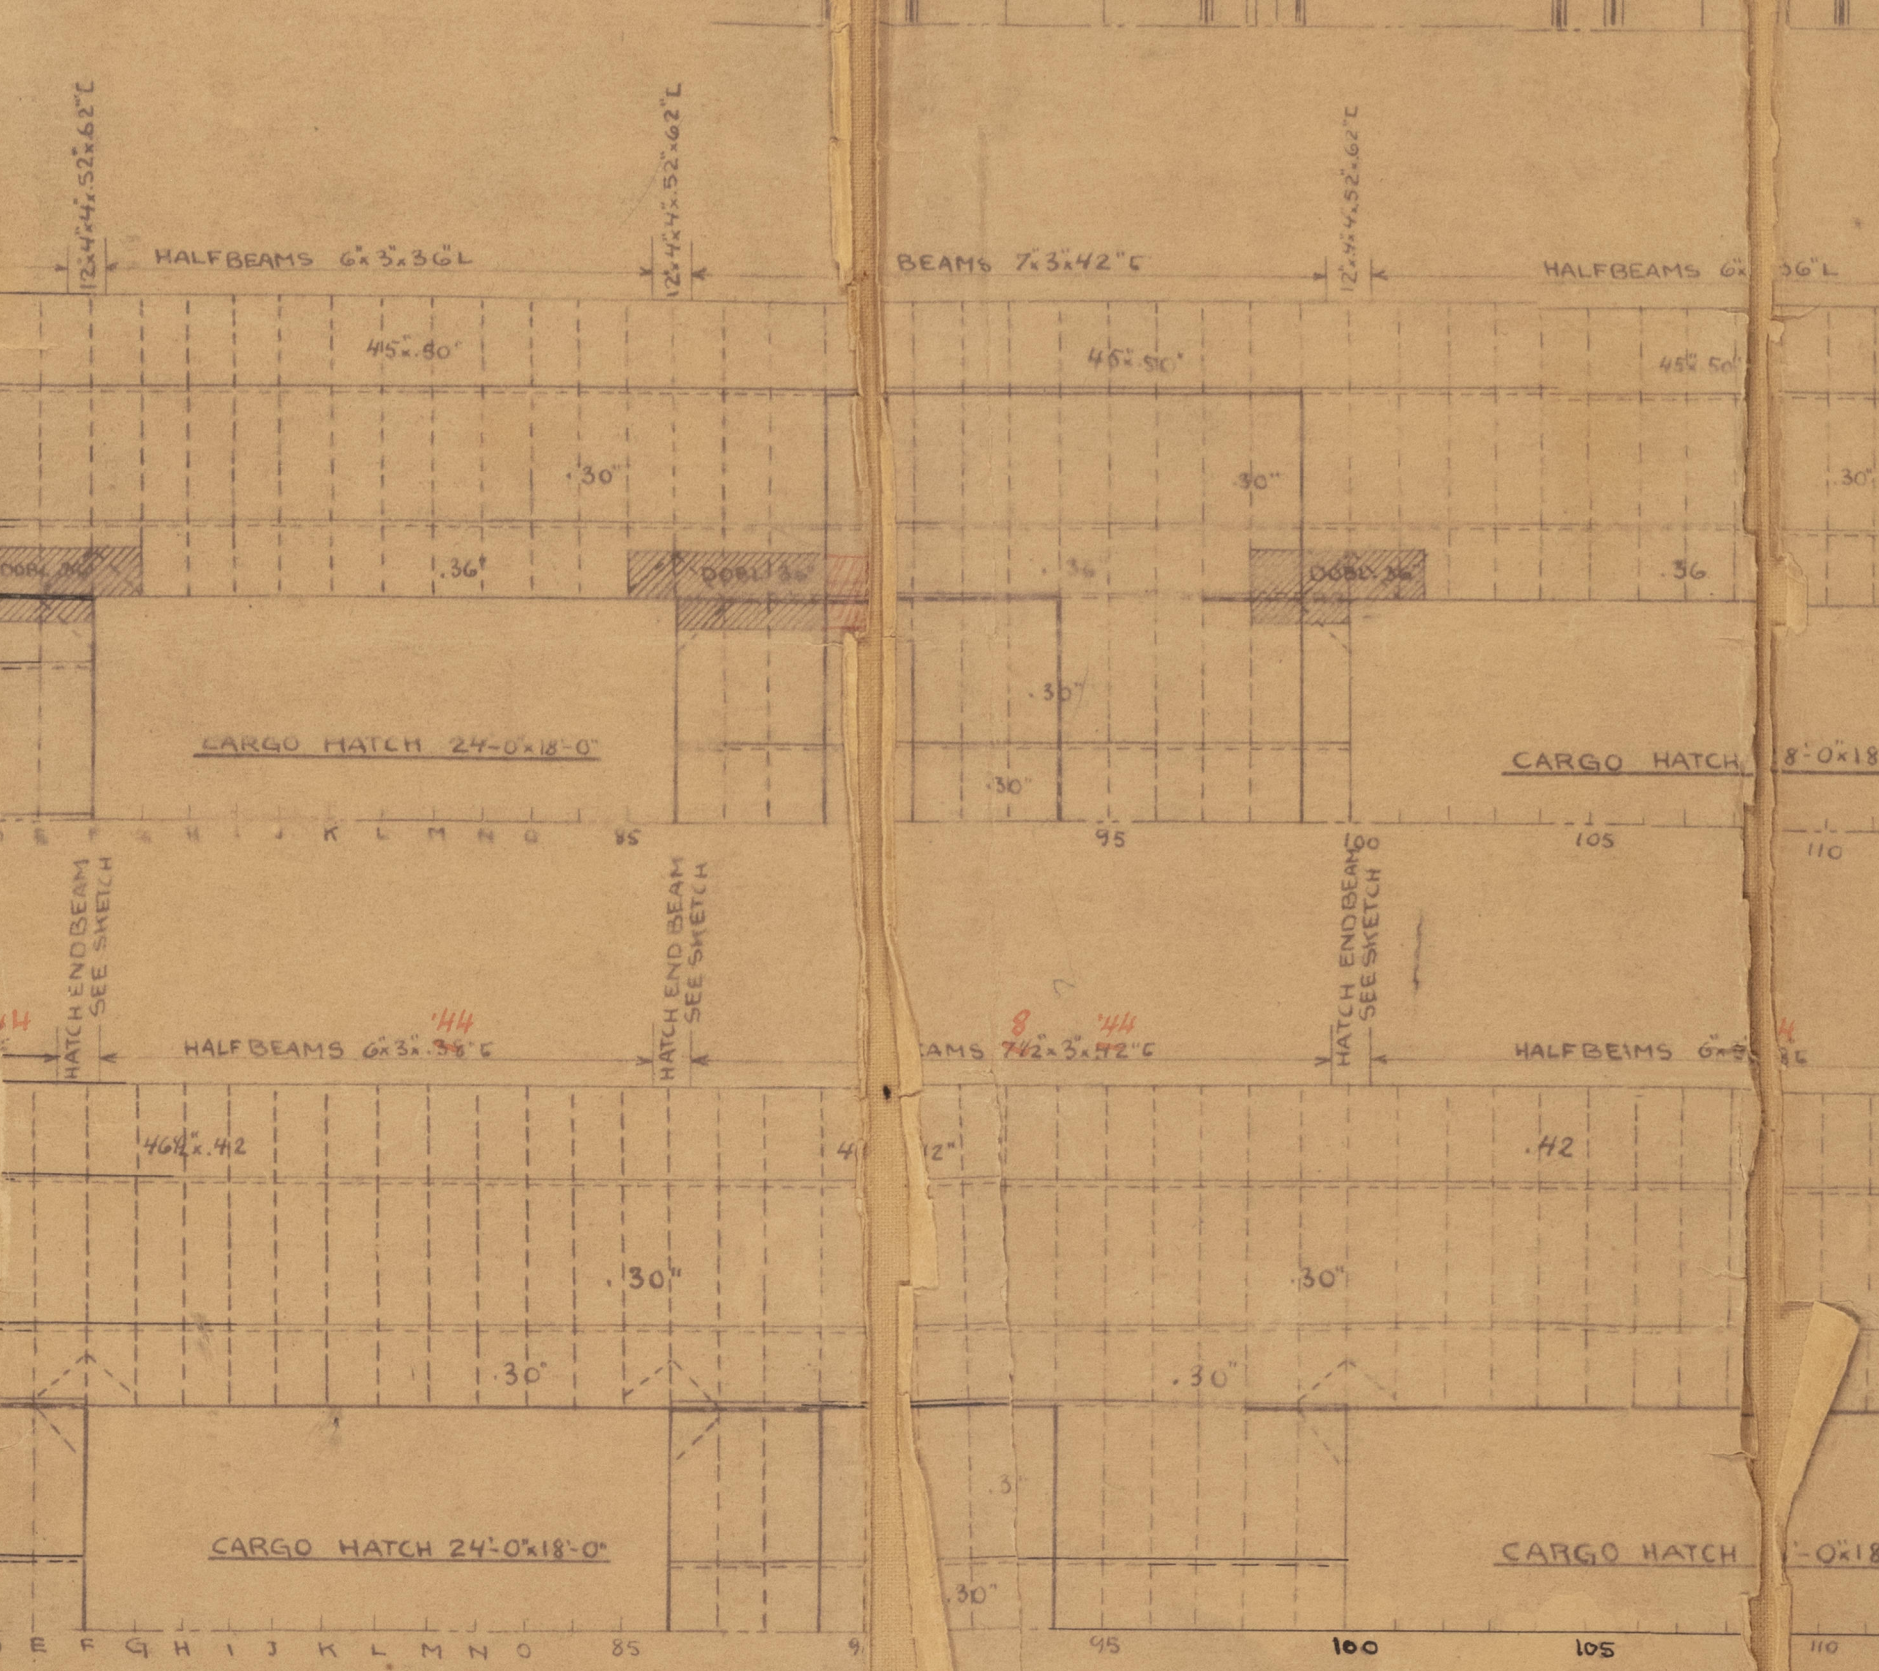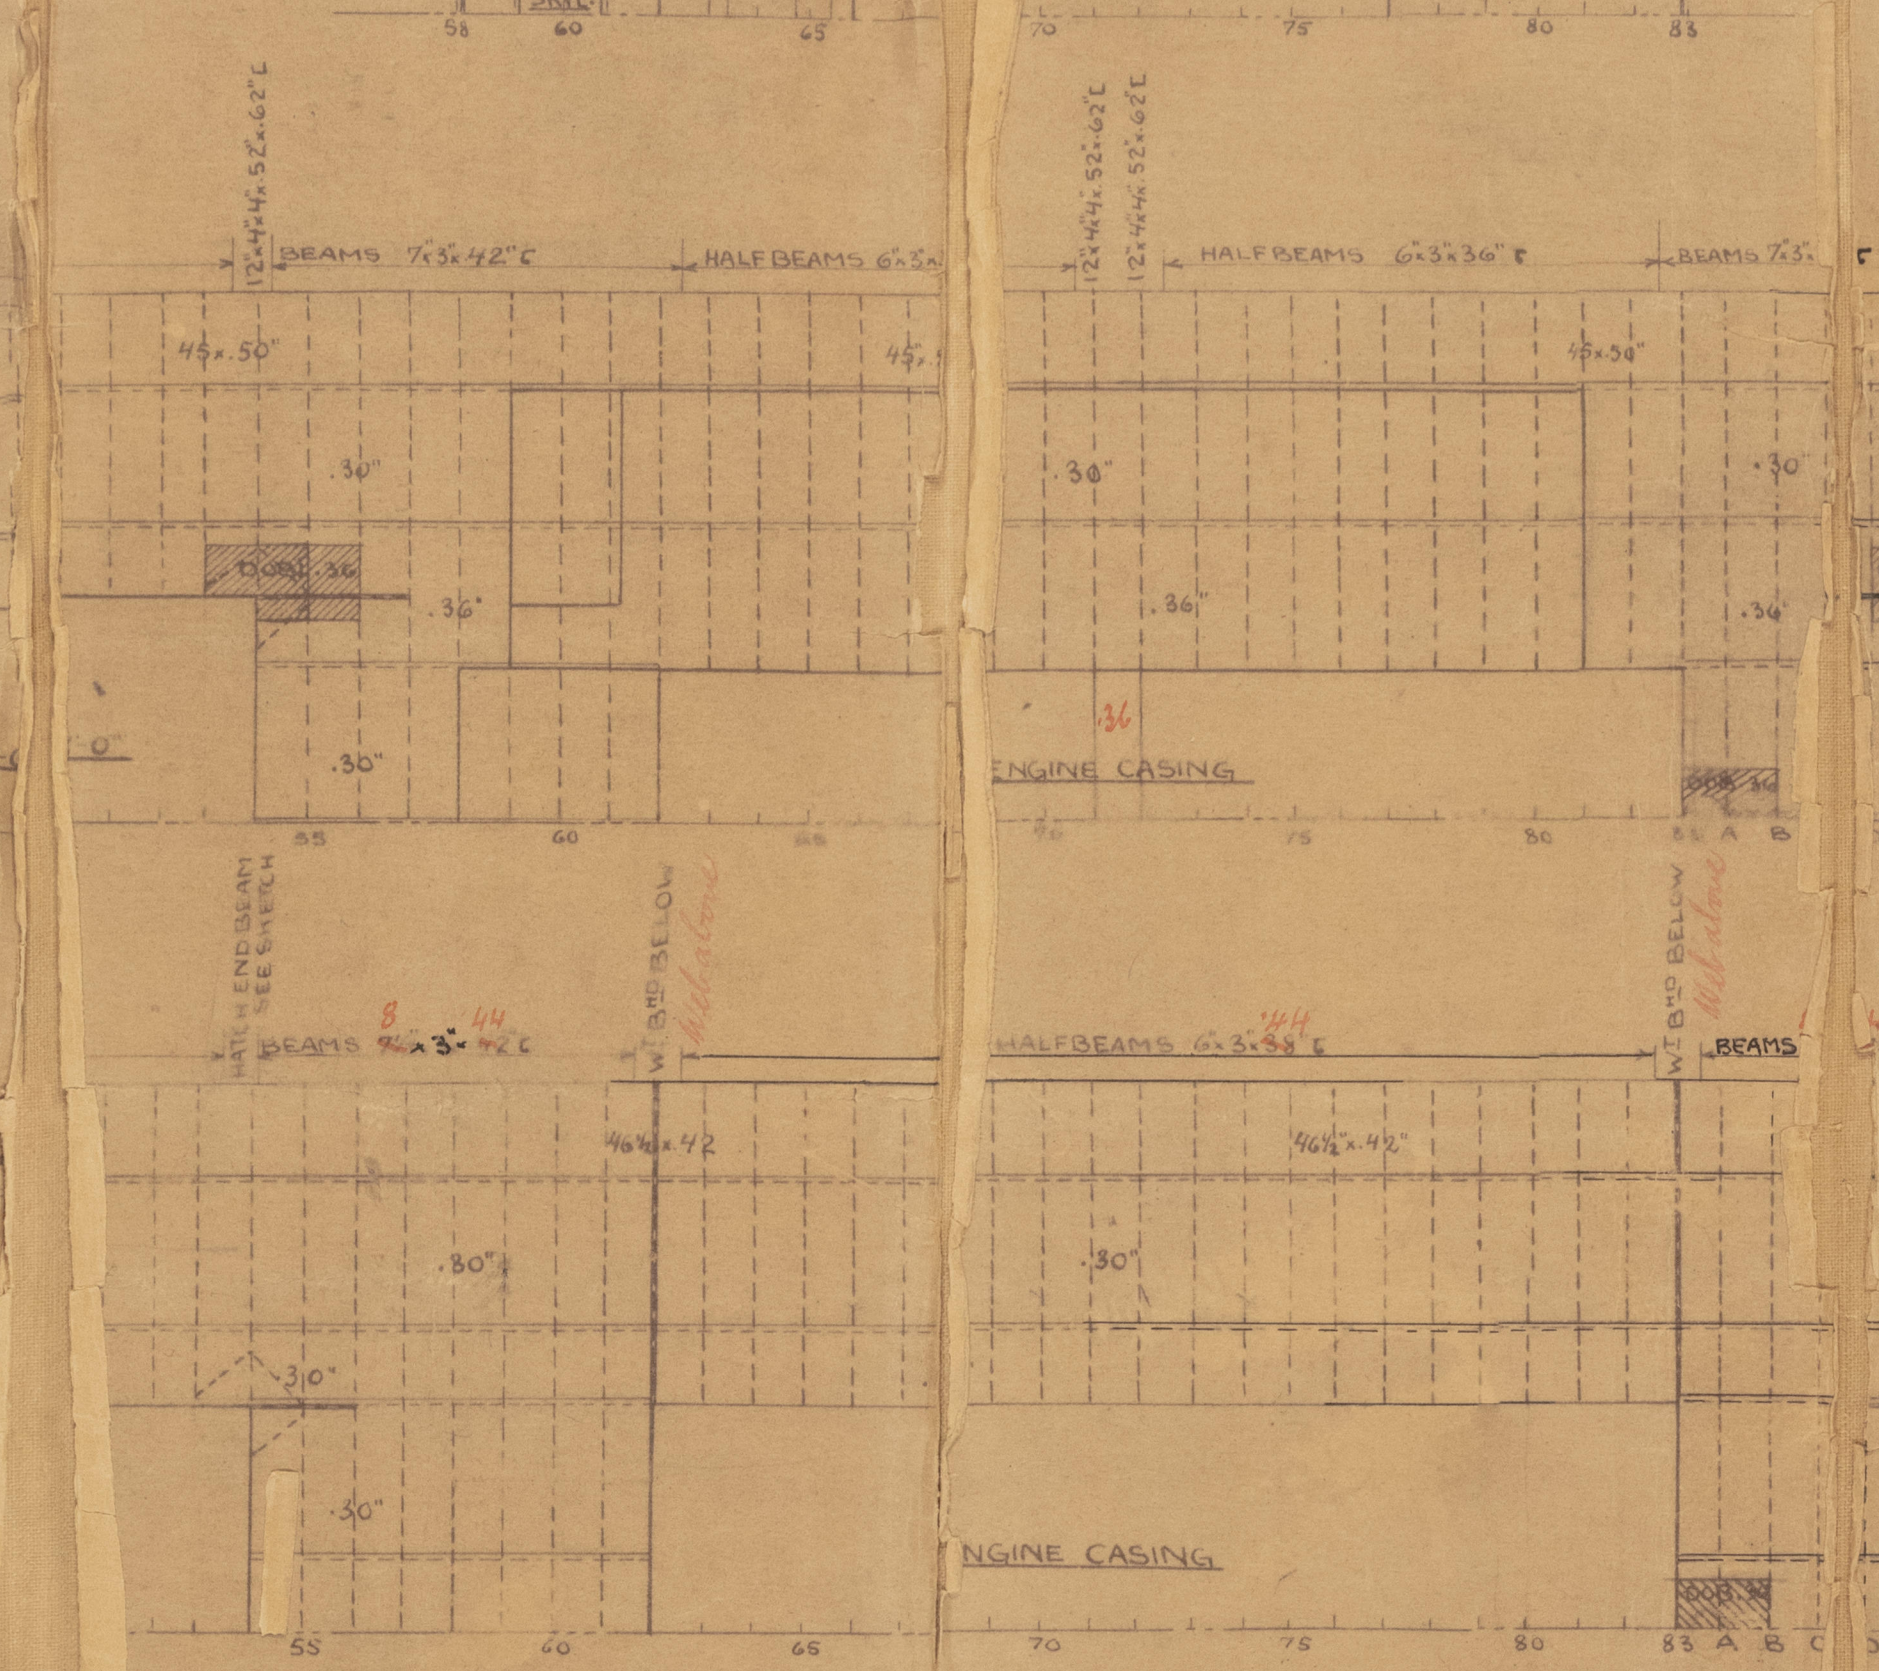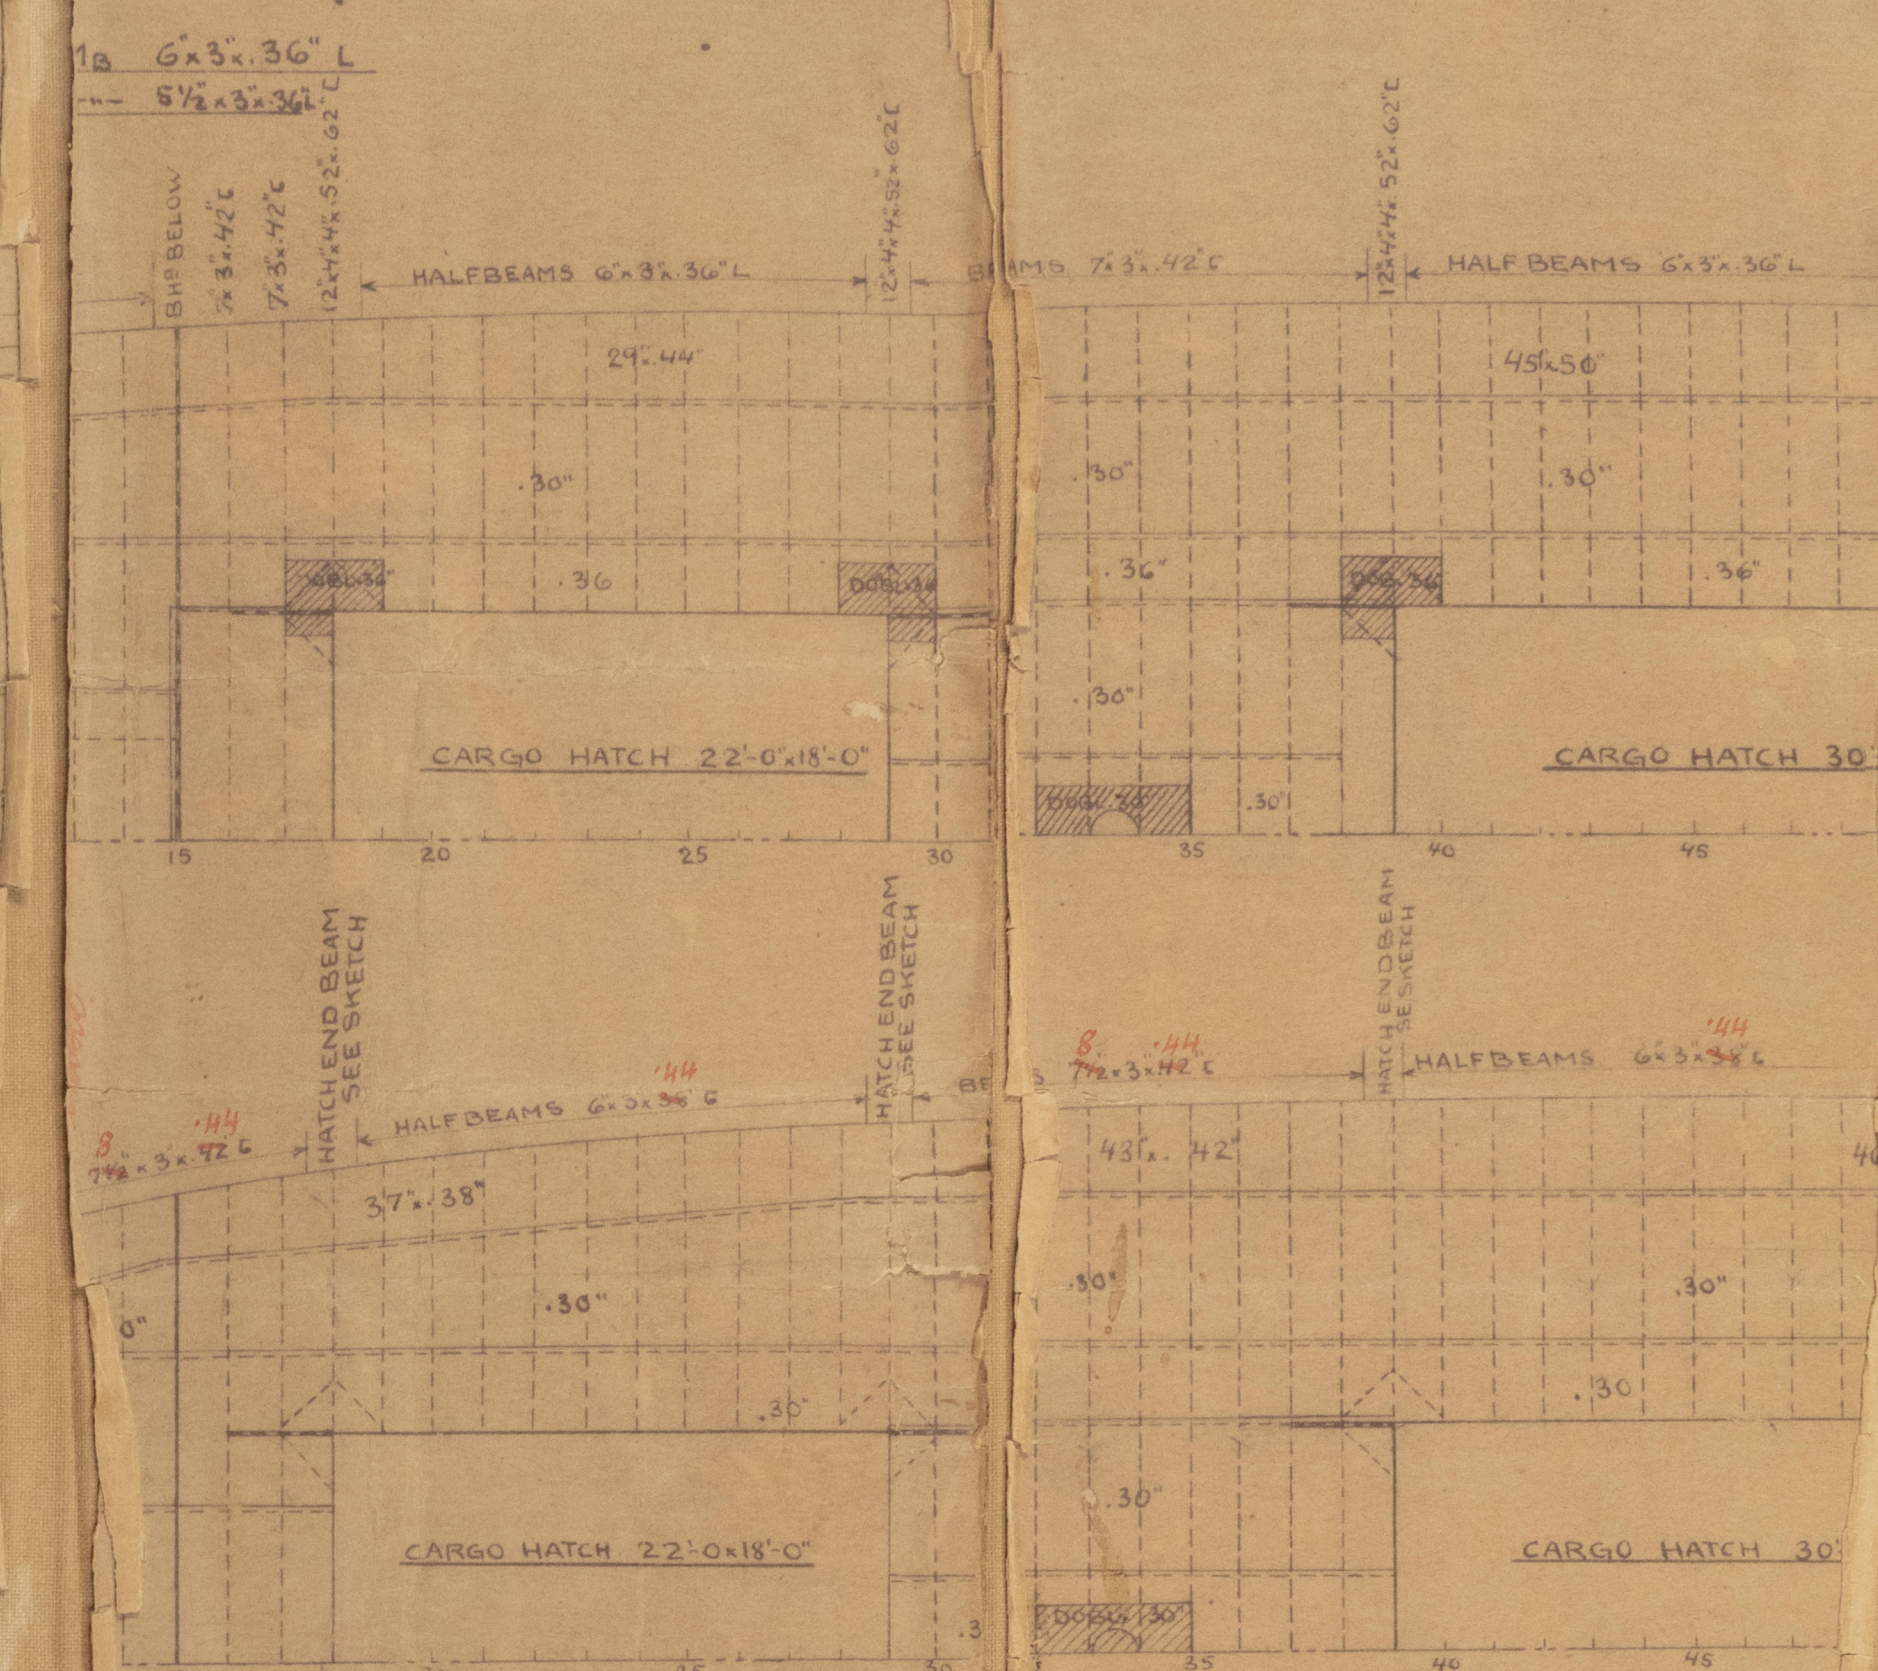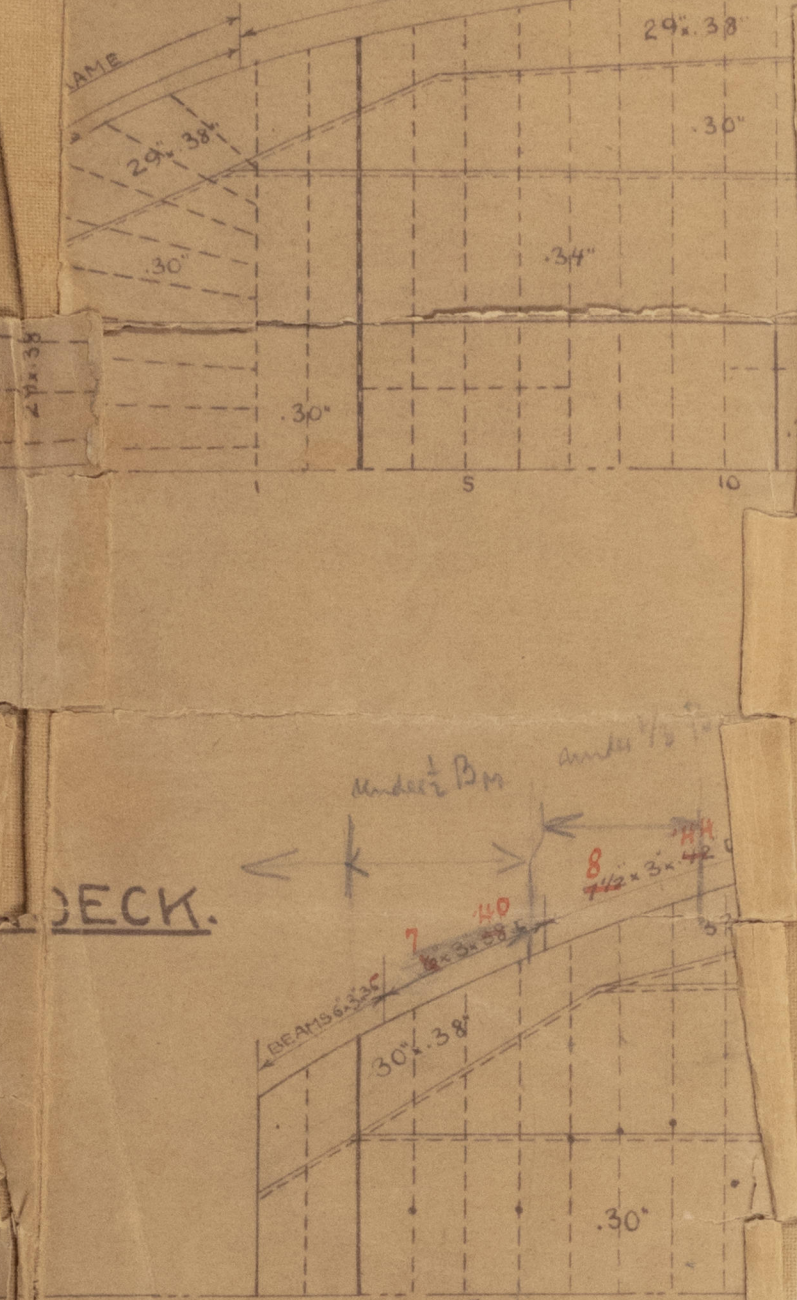

BEAMS NOT EXCEEDING

DECK

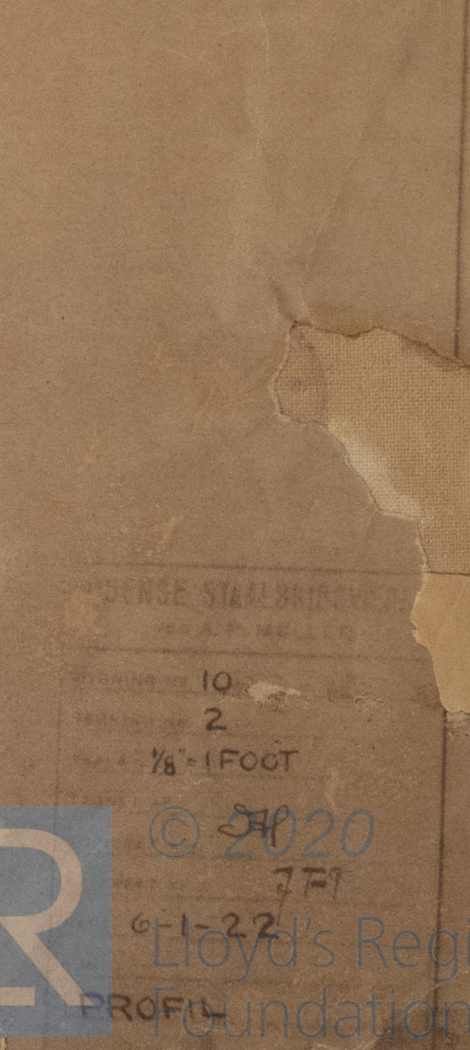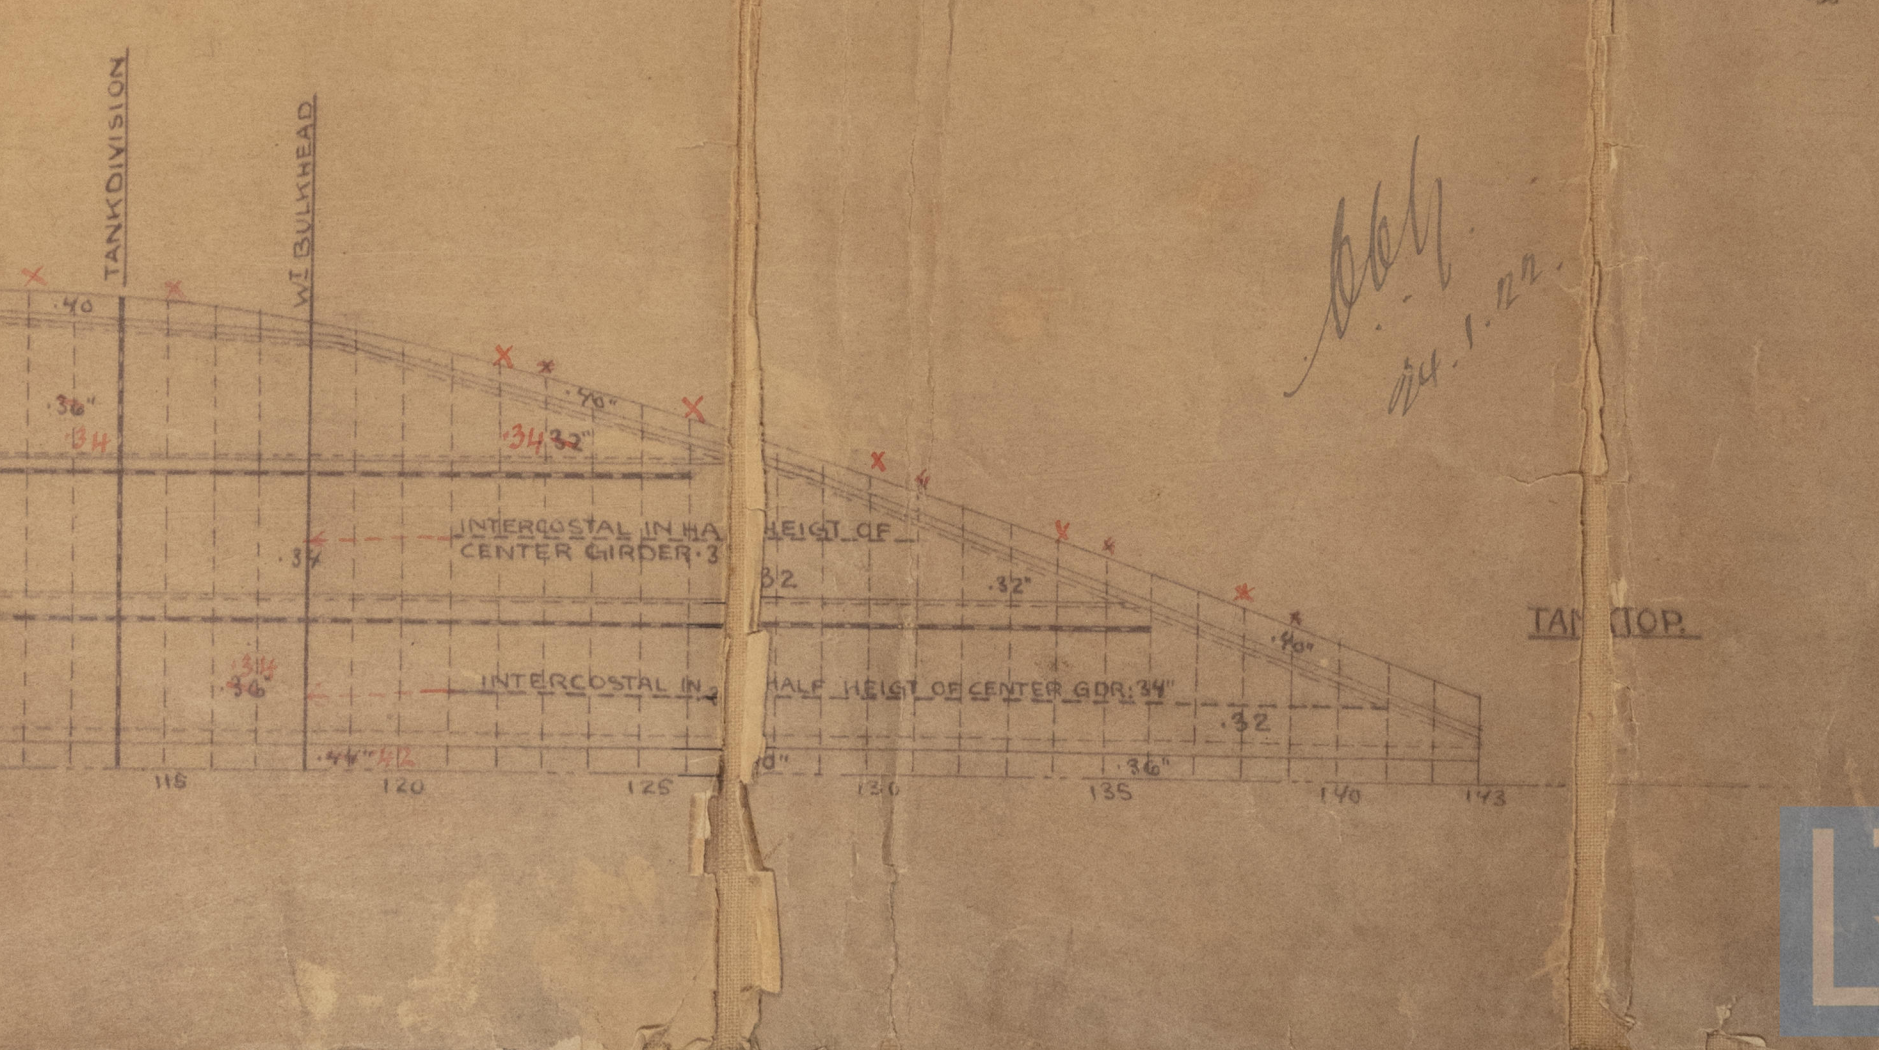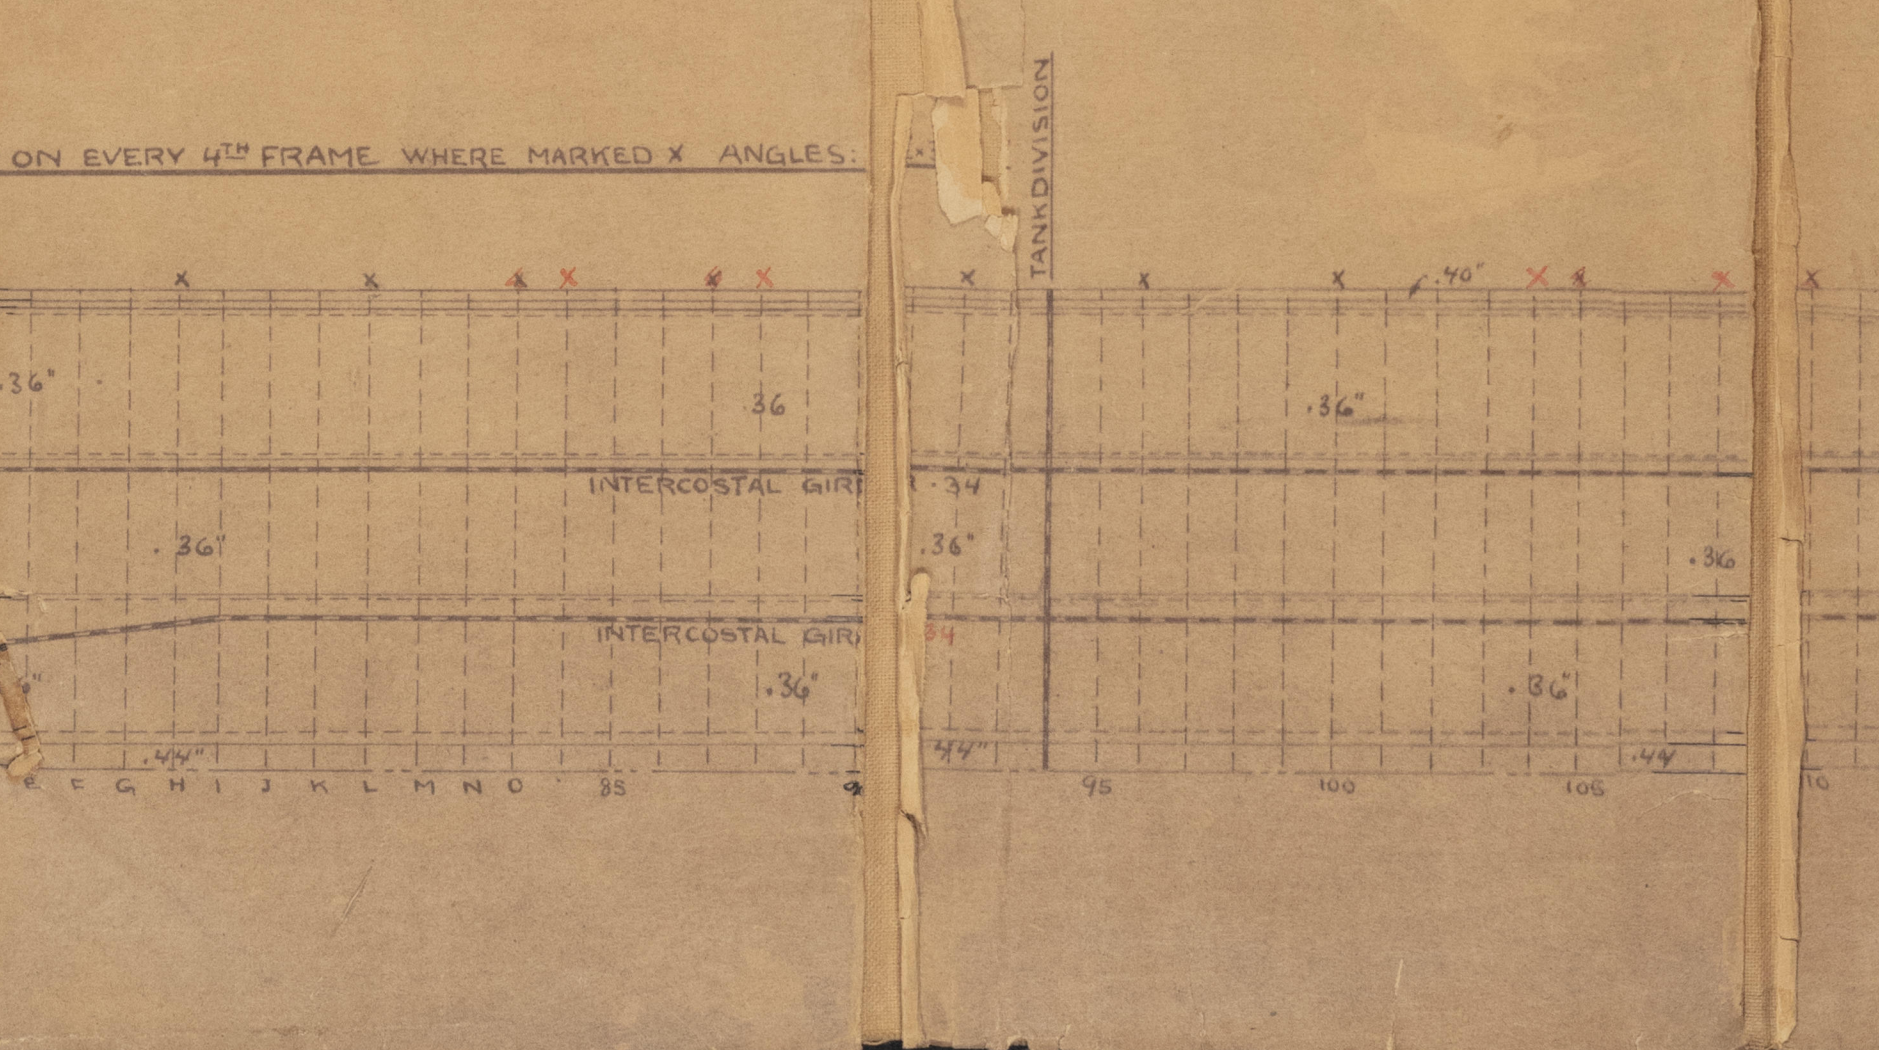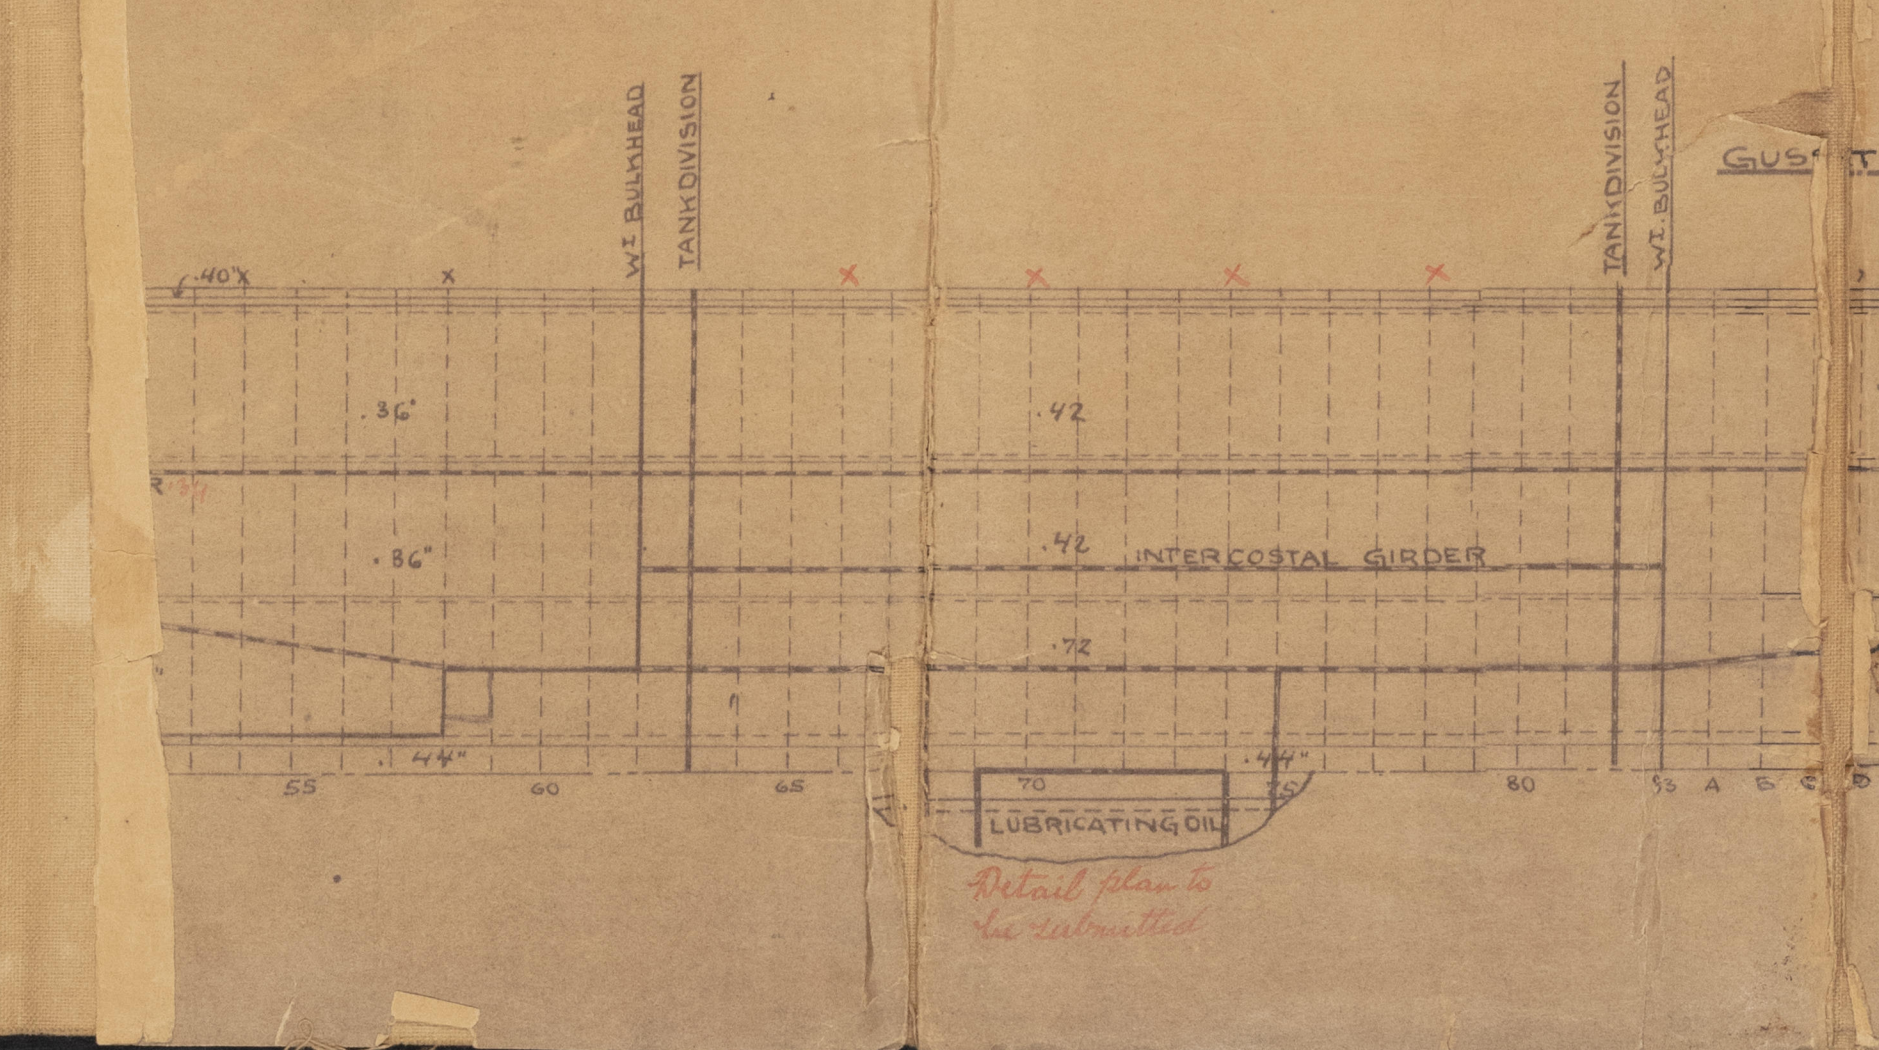

Odense

Starbøile-


Værft:

[W/118]

News, No 10.

Longitudinal
Section & Decks.

Approved plan.

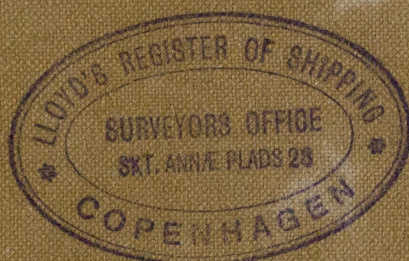

M/S. SALLY
MÆRSK,

3252 tons,

of COPENHAGEN.

Rpt. No. 6574

W118-0109



© 2020

Lloyd's Register
Foundation