


TO CLASS 100 A.I. AT LLOYDS.

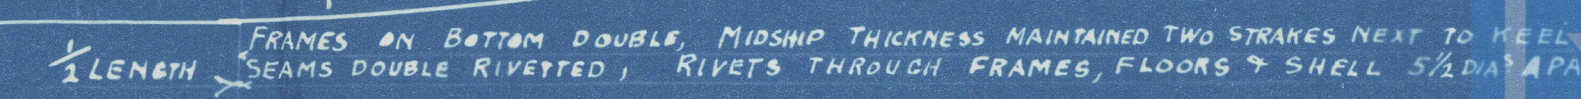

PROFILE & DECK PLAN. (AS BUILT)

GEORGE BROWN & Co's N° 183.

M. V. "ACTUOSITY"

GREENOCK FIRST ENTRY REPORT N° 19516.

RETAIN



© 2020

Lloyd's Register
Foundation

W1180-0021