


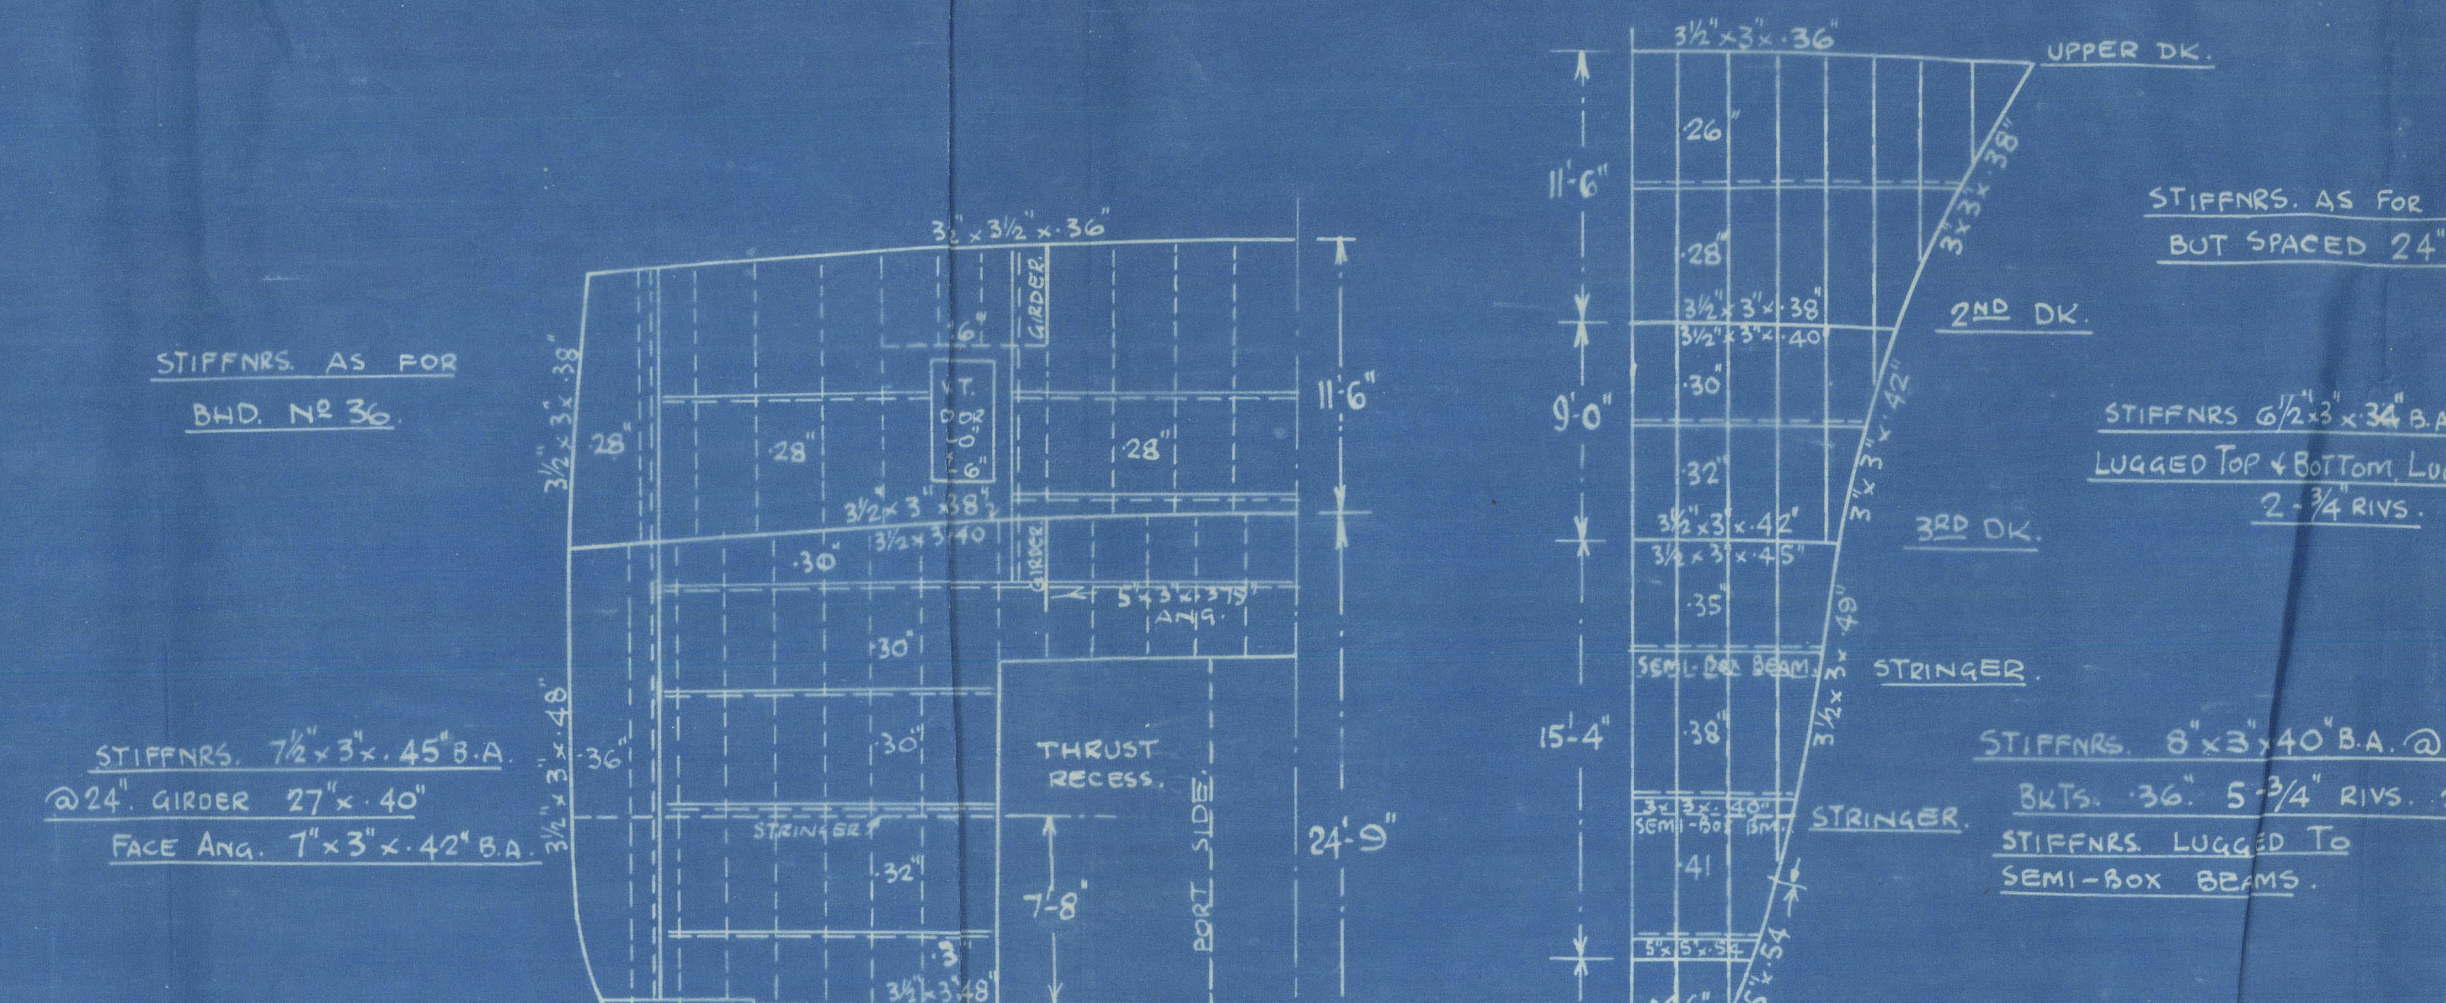
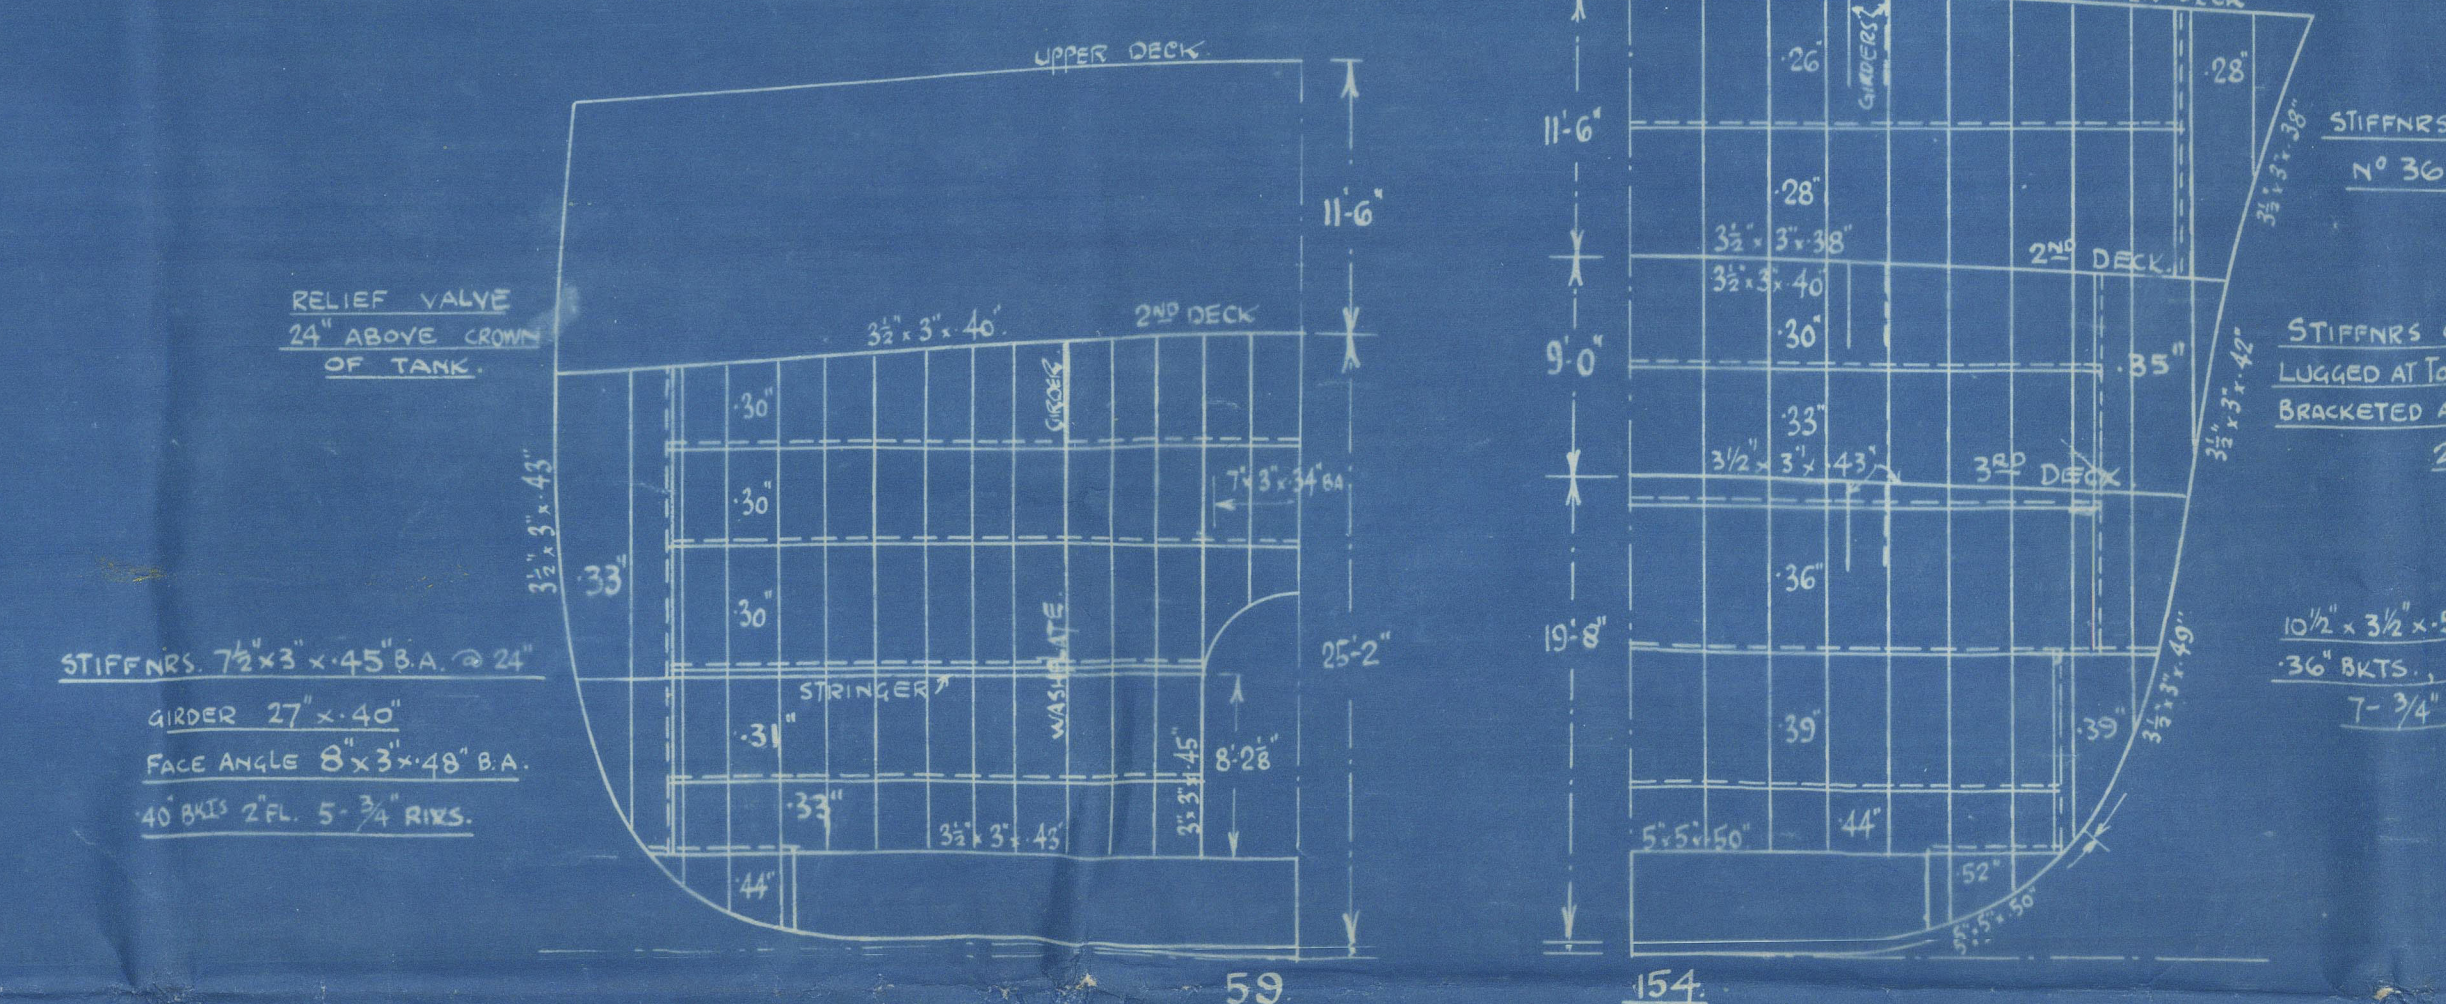
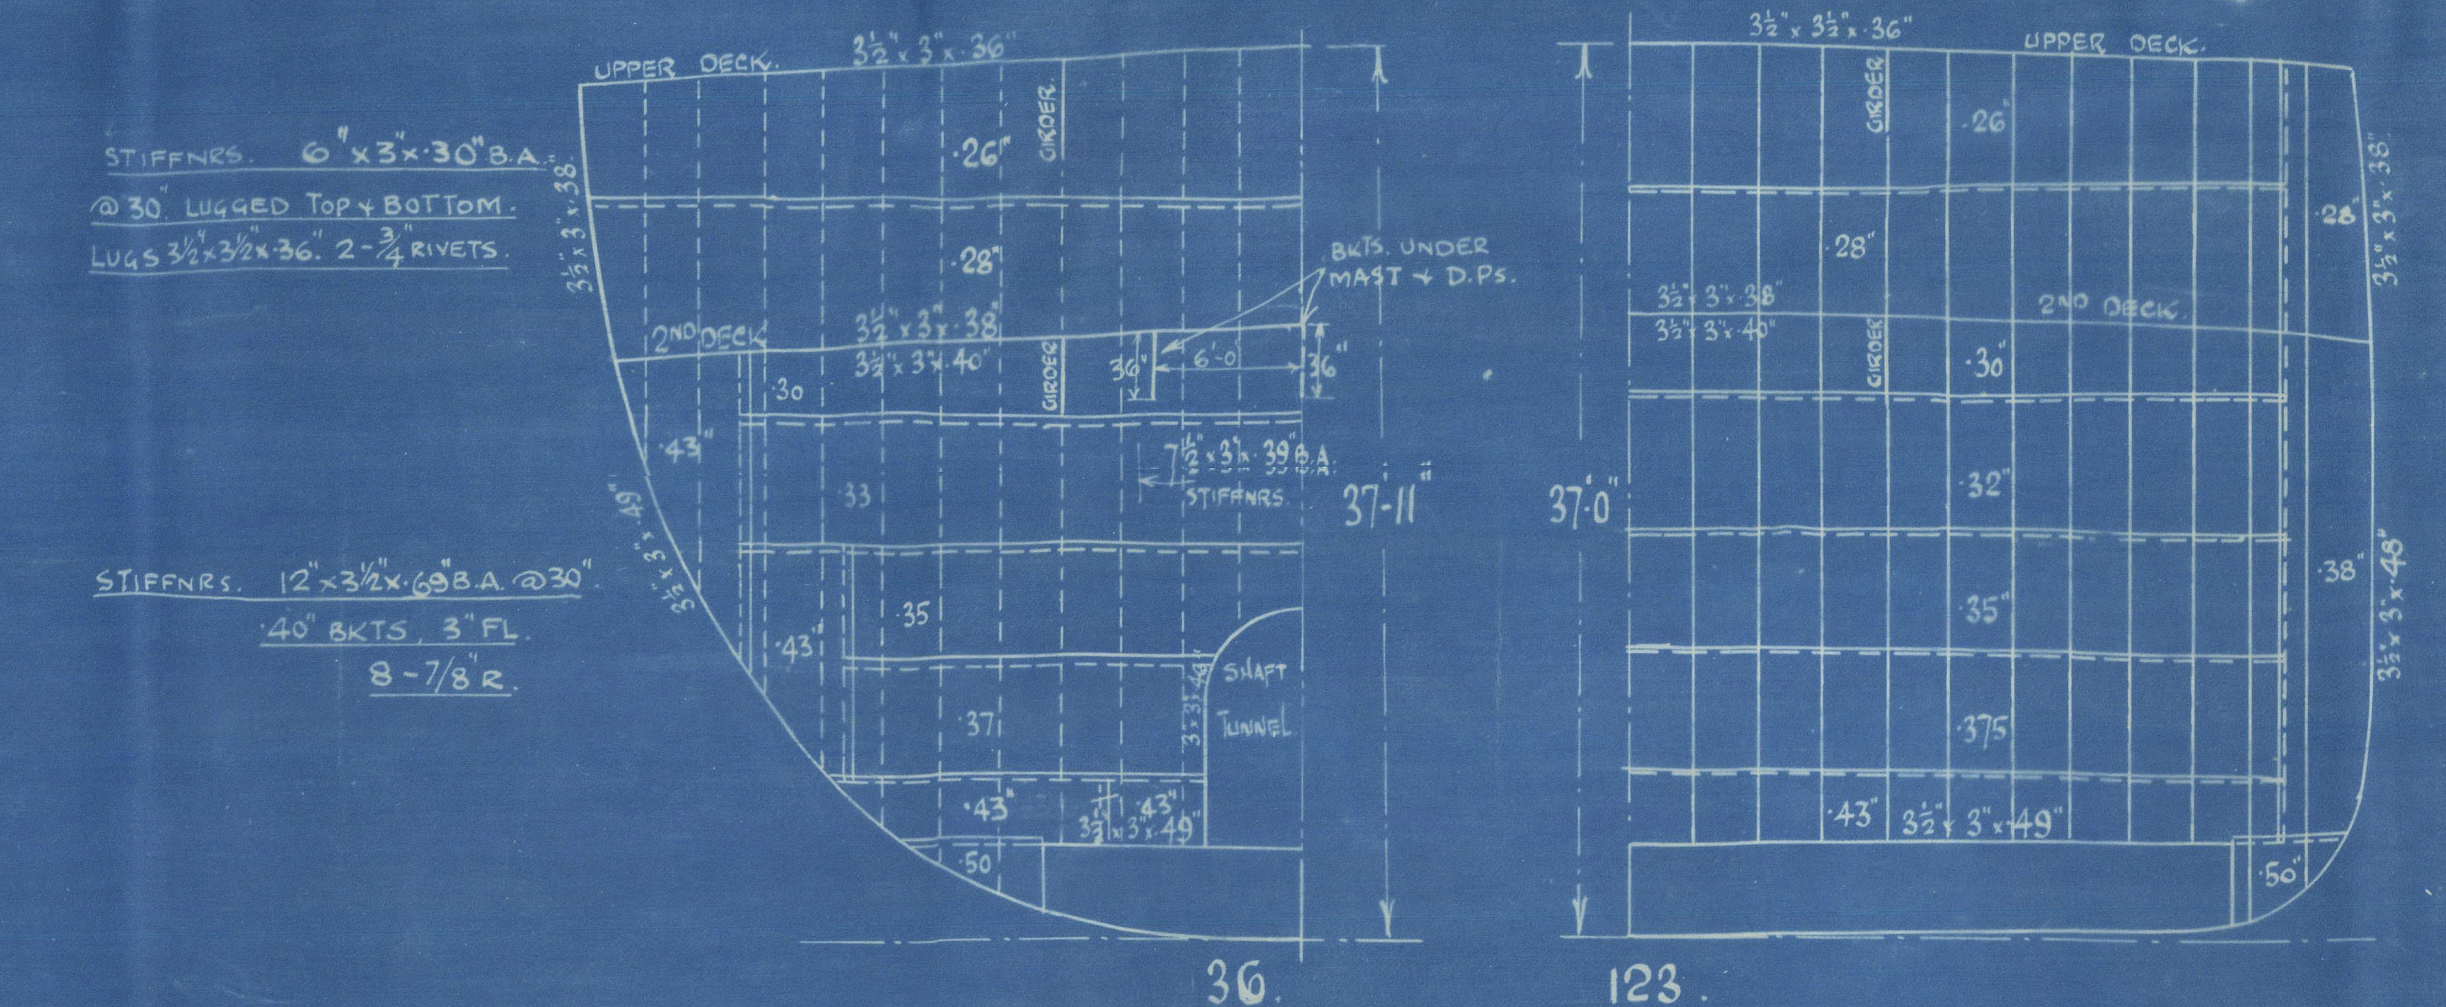


**PROFILE & DECKS**  
**"MATRA" S.S. No 396 (LENGTH 470'-0")**  
Scale 1/8" = 1 Foot  
RULE DIMENSIONS - LENGTH 468'-0" BREADTH 62'-0"  
DEPTH MID. TO UPPER DECK 34'-10"  
(Full Scantling)

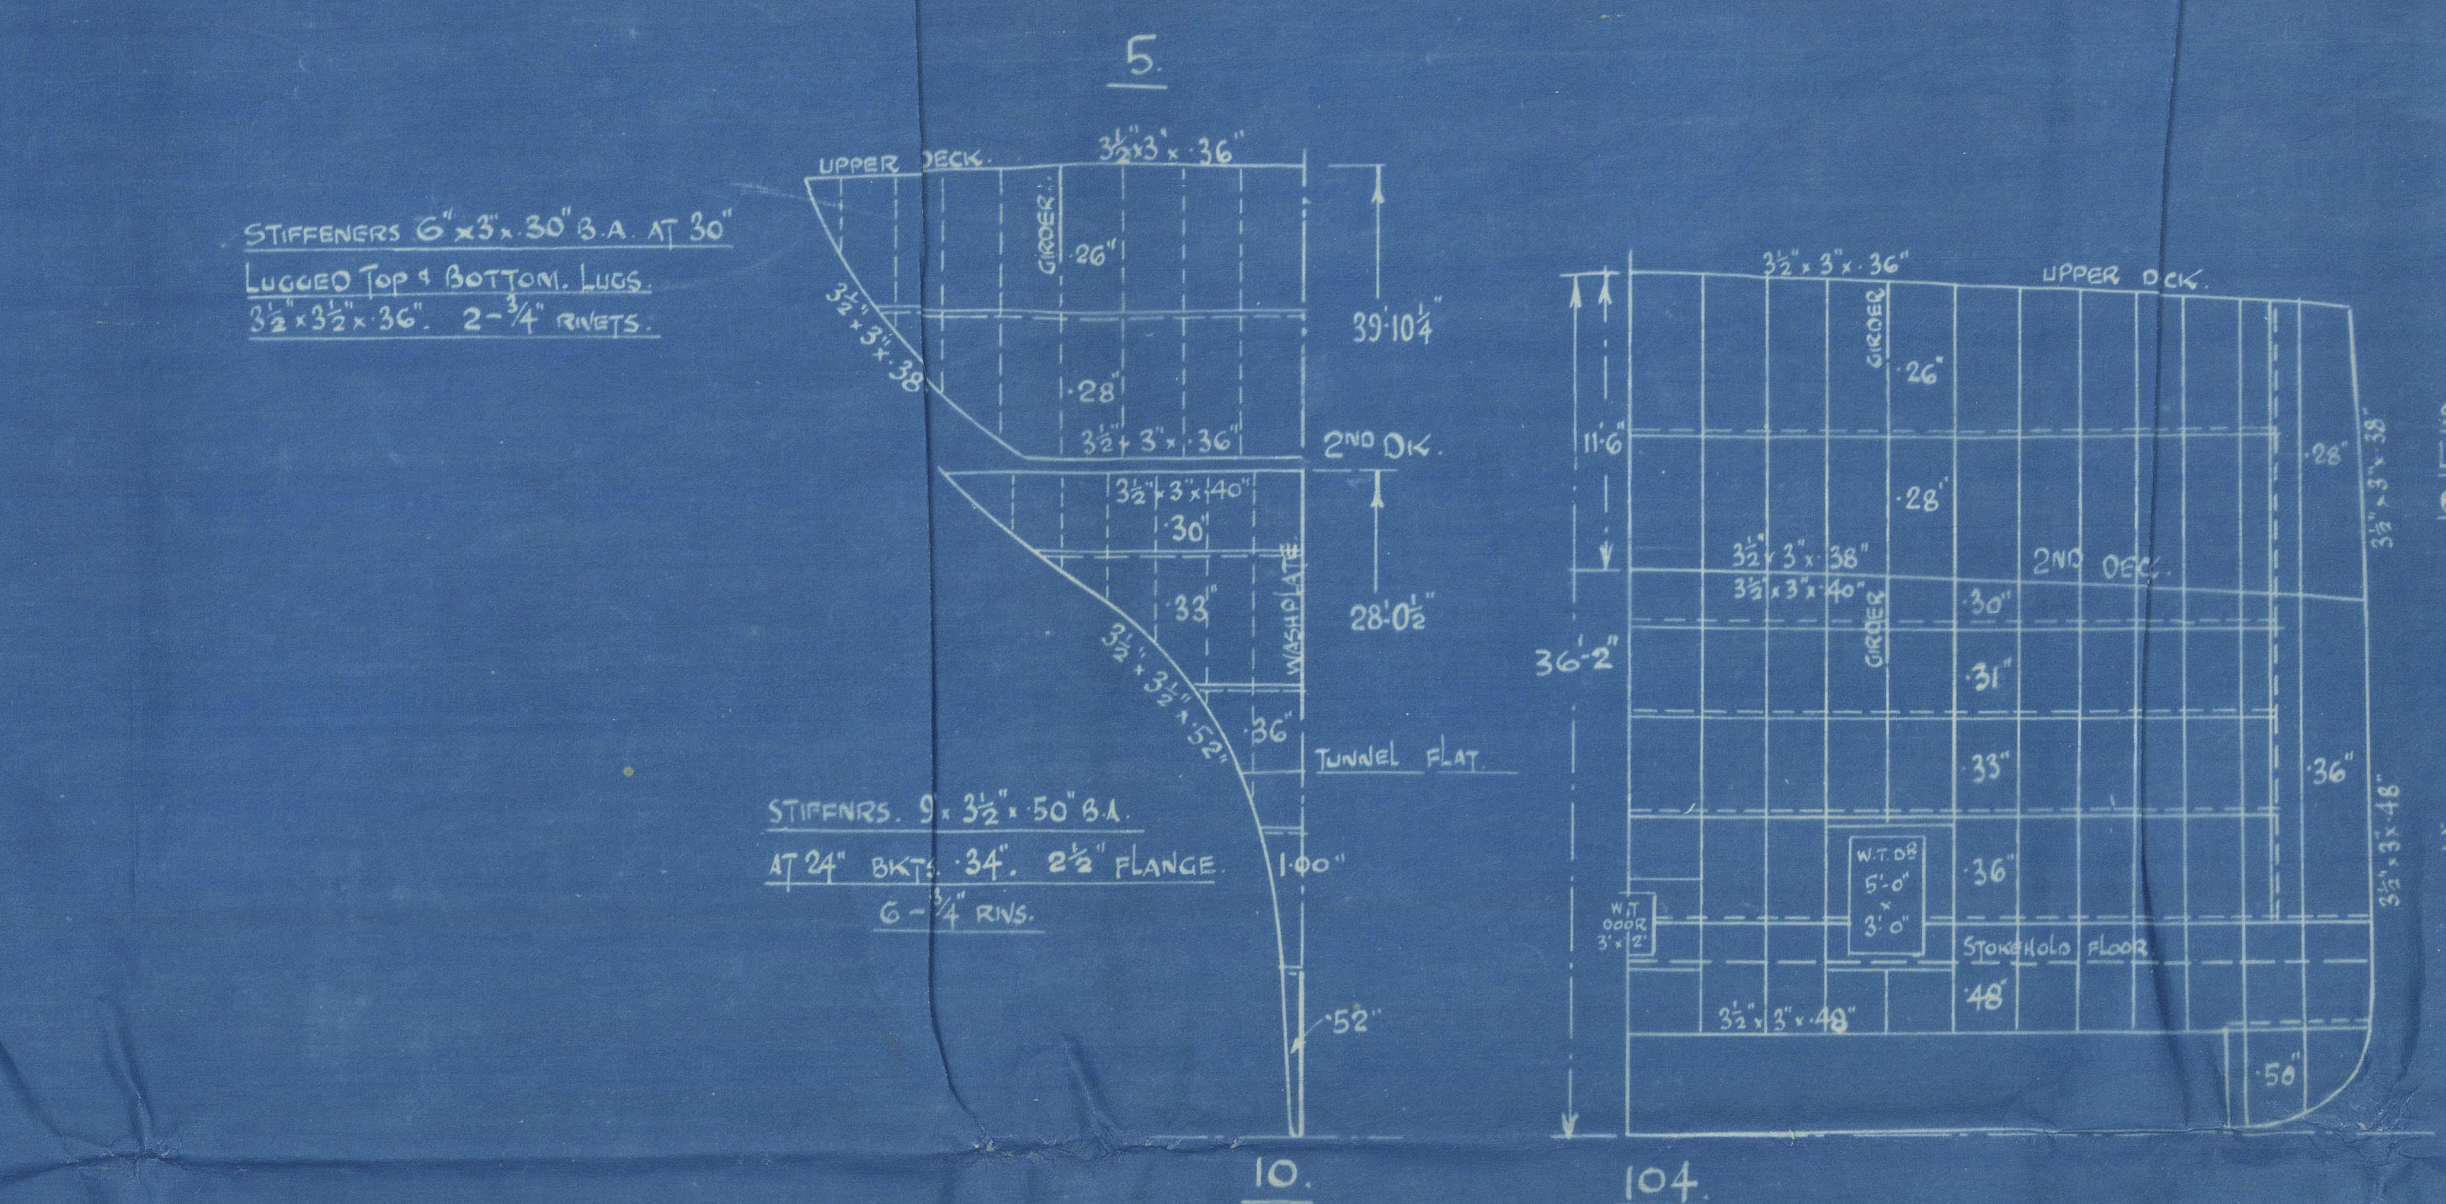

**FORE END STRENGTHENING**

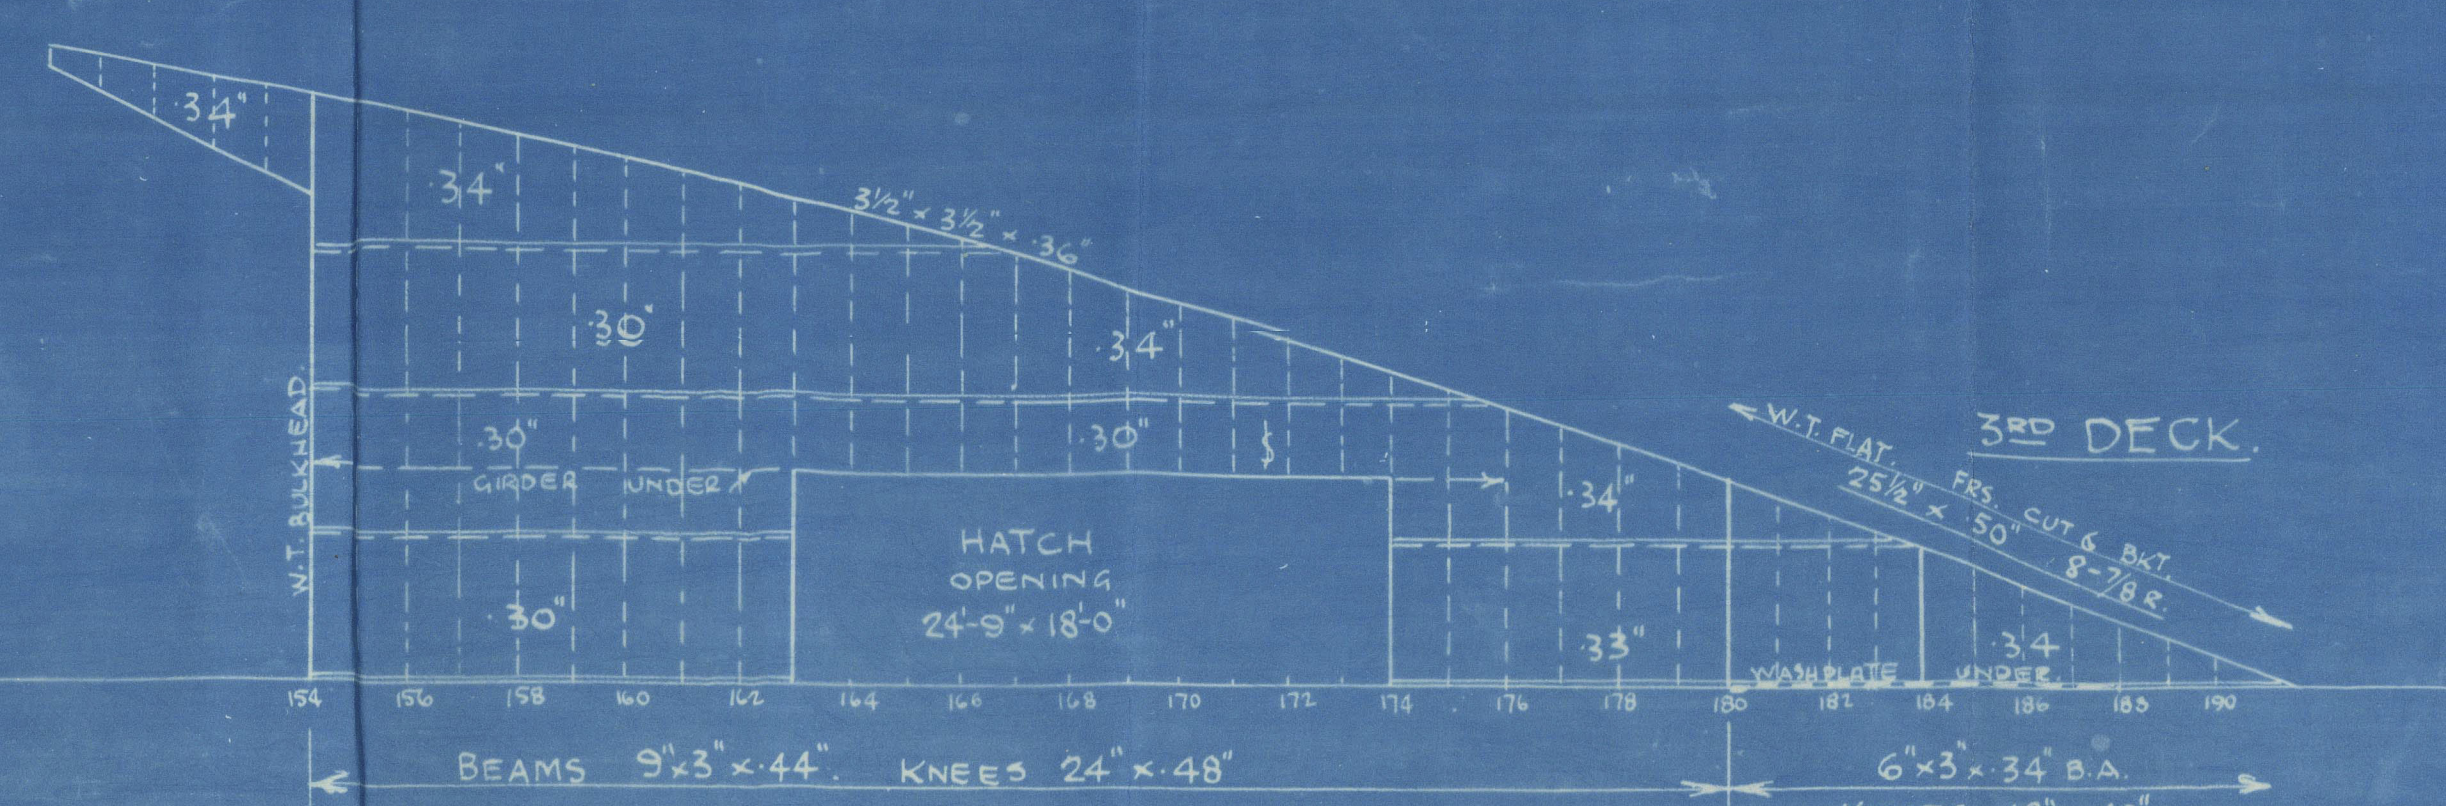

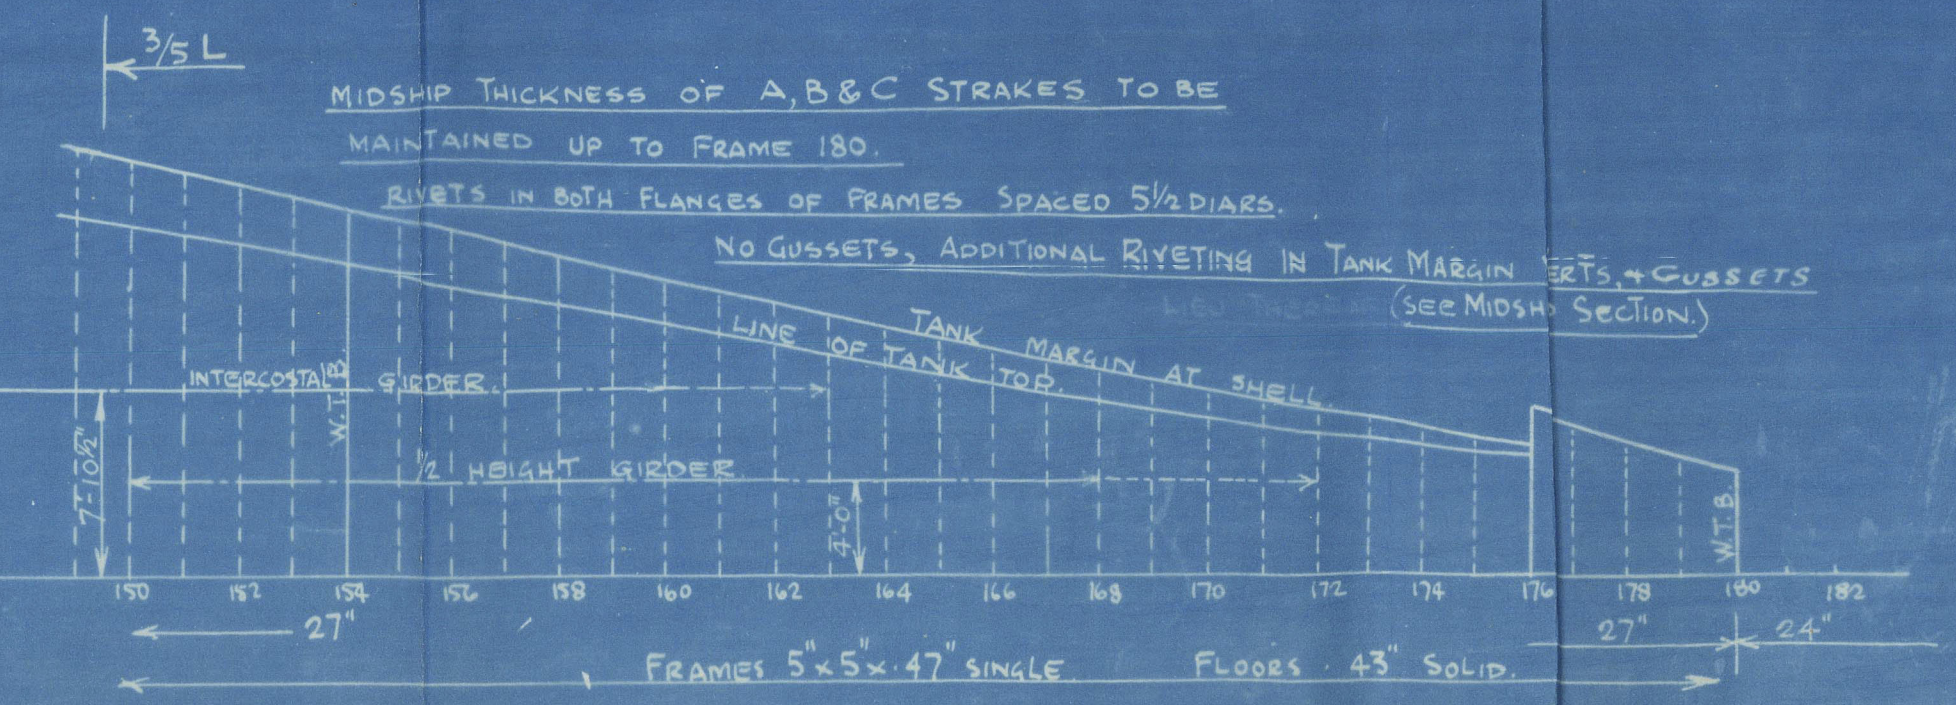

S. S. MATRA

PROFILE & DECK PLANS AS BUILT.

WM HAMILTON & CO N° 396

GREENOCK FIRST ENTRY REPORT N° 18624.

RETAIN



© 2021

Lloyd's Register  
Foundation