

Nº 696.

PROFILE & DECK PLAN.


DIMENSIONS:- 117'0" x 22'0" x 13'0".

SCALE - 1/4 IN = 1 FOOT.

RIVETING PARTICULARS	DIA	SPACING
RIVETS THRO BEAMS AND STRINGER PLATES	5/8	5 DIAS
" " DECK	"	7 "
" " STRINGER ANGLE & DECK	"	4 1/2 "
" " GROUND BARS & DECK	"	7 "
" " STRINGER BUTTS	"	3 1/2 "
" " GROUND BARS & CASINGS	"	5 "
" " 4 1/2 x 4 1/2 CASING GROUND BAR & CASINGS	5/8	AS PER SPEC.
" " DECK TIE PLATE BUTTS	5/8	4 DIAS
" " SEAMS OF DECK PLATING	"	6 - 4
" " STRINGER ANGLE TO SHELL	3/4	4 1/2 "

NOTE

ATHWARTSHIP PLANKS TO BE LAID AT THE FORE AND AFT ENDS OF ALL STEEL DECK HOUSES, HATCH COAMINGS, AND SKYLIGHTS.

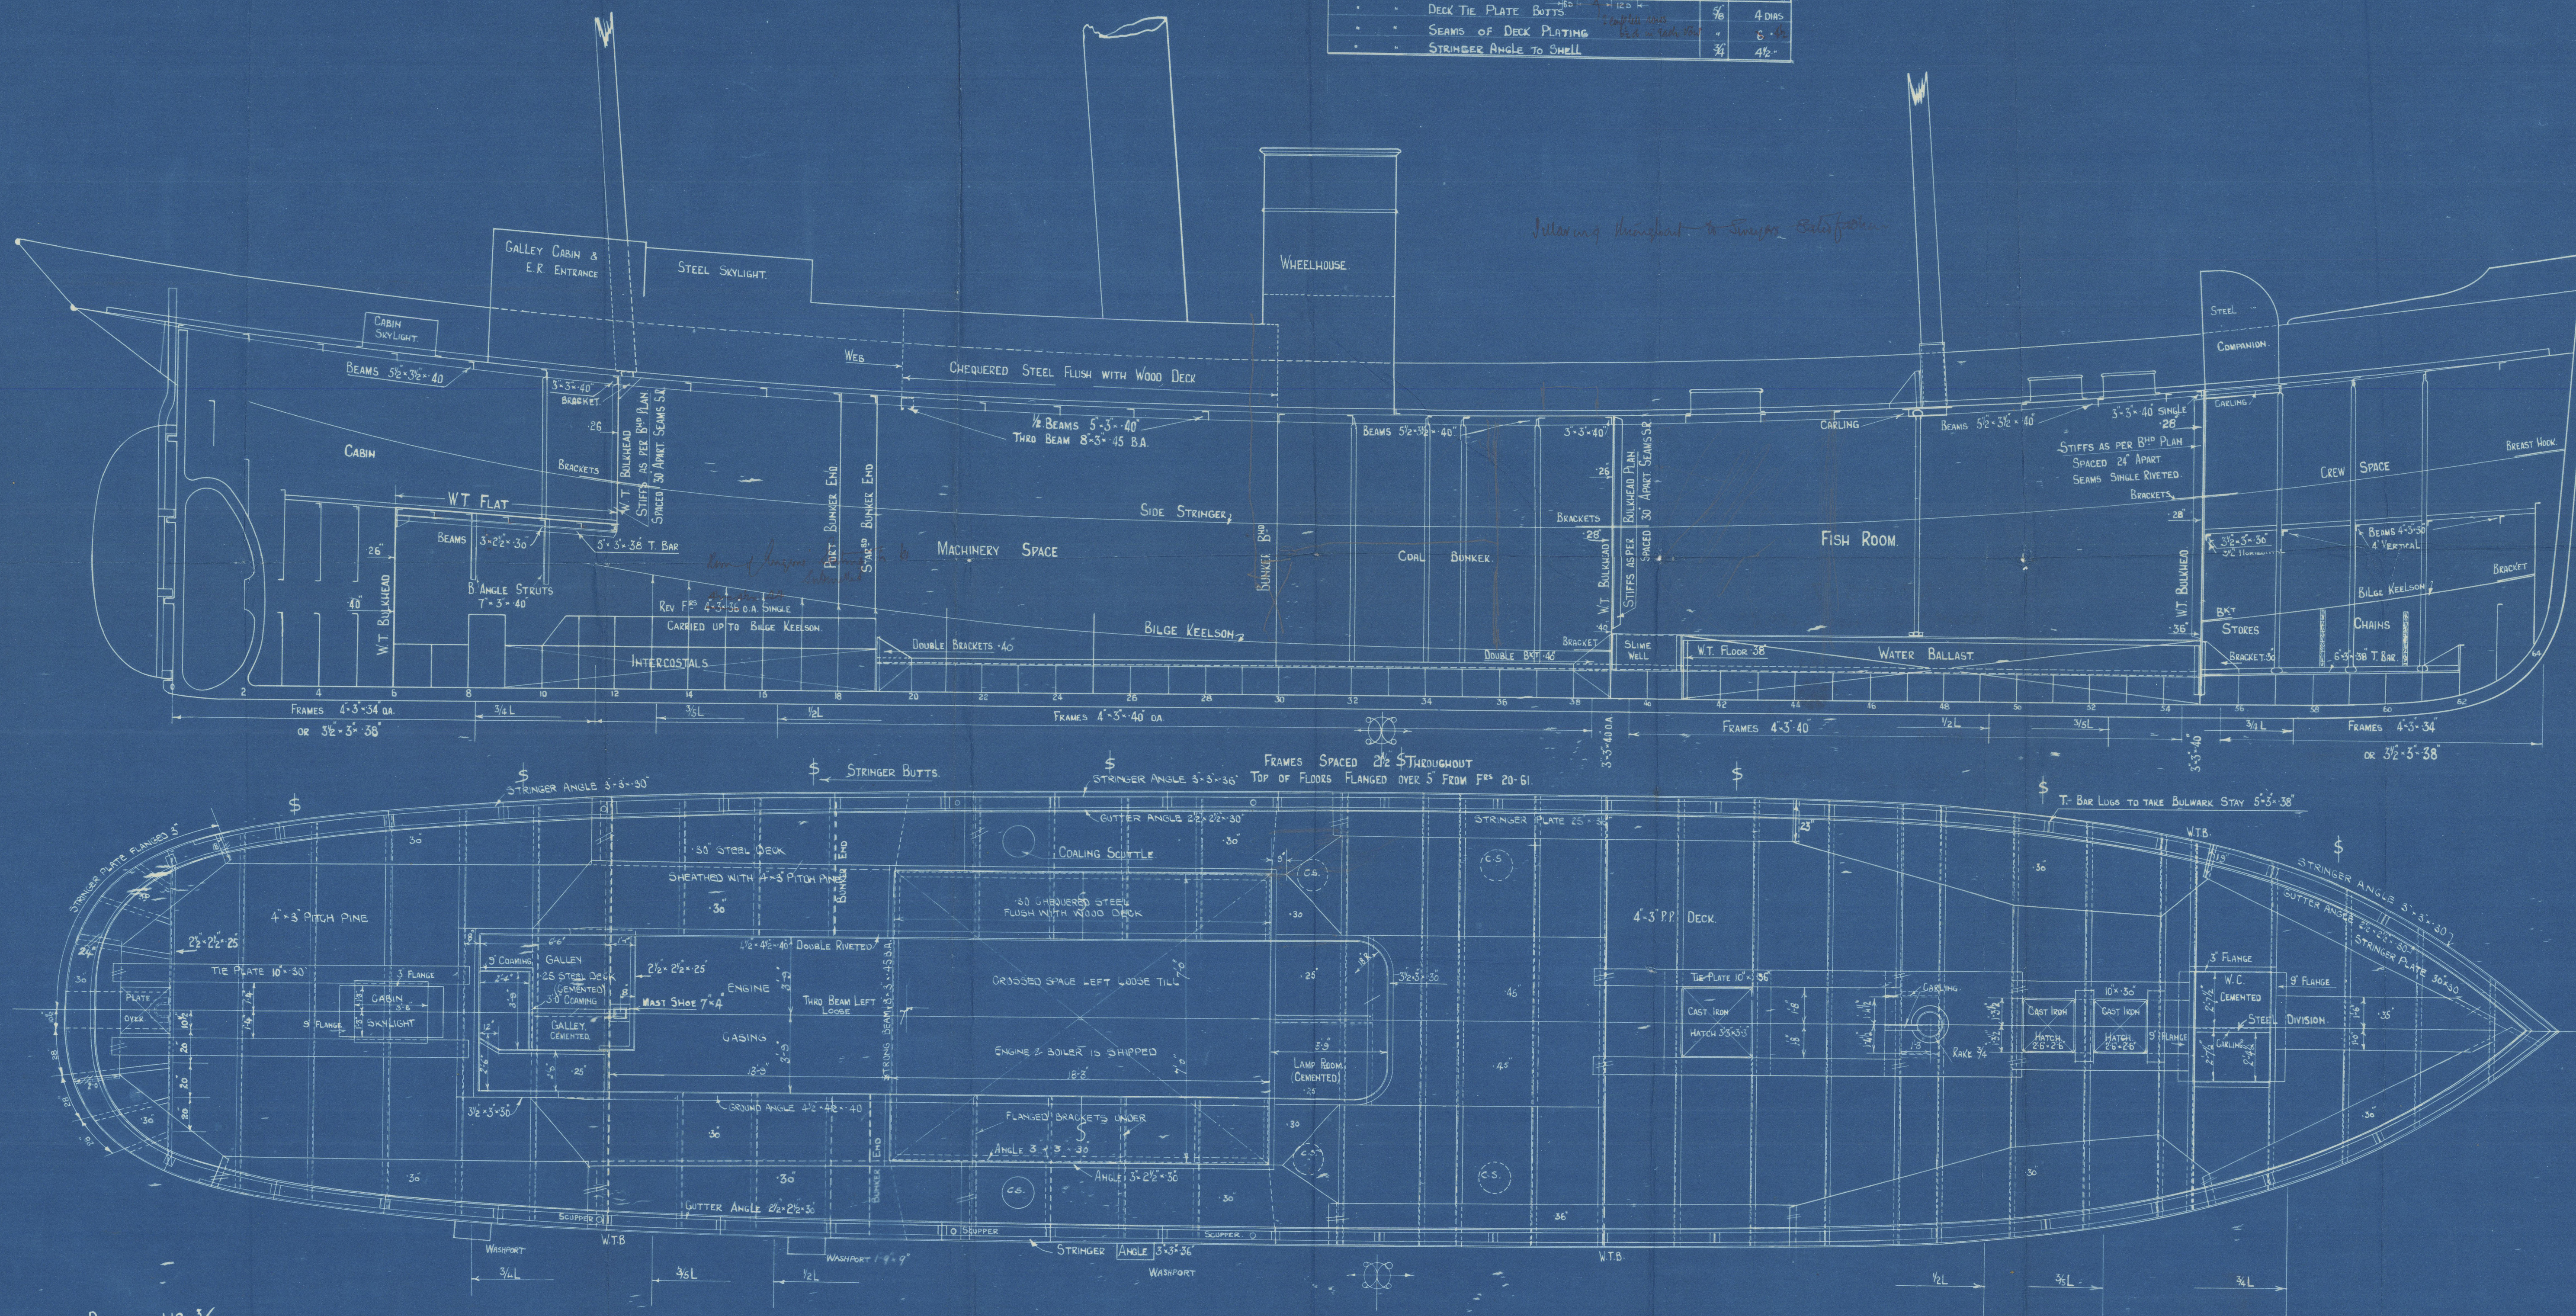

DRAWING Nº 3/696




Lloyd's Register Foundation

N^{os} 696.-7

Messrs. Hall Russell & Co. L^d.

Profile & Decks.

S.S. Strathlyon.  No. 696

abu. Report. 15341

S.S. Strathgyle. No. 697.

abu. Report. 15342



© 2020

Lloyd's Register
Foundation

W1183-0050