


Approved  
18/12/41







W1185-0071

SHIP NOS 387 & 388  
PROPELLER SHAFT & STERN TUBE.  
SCALE: 3" = 1 FOOT

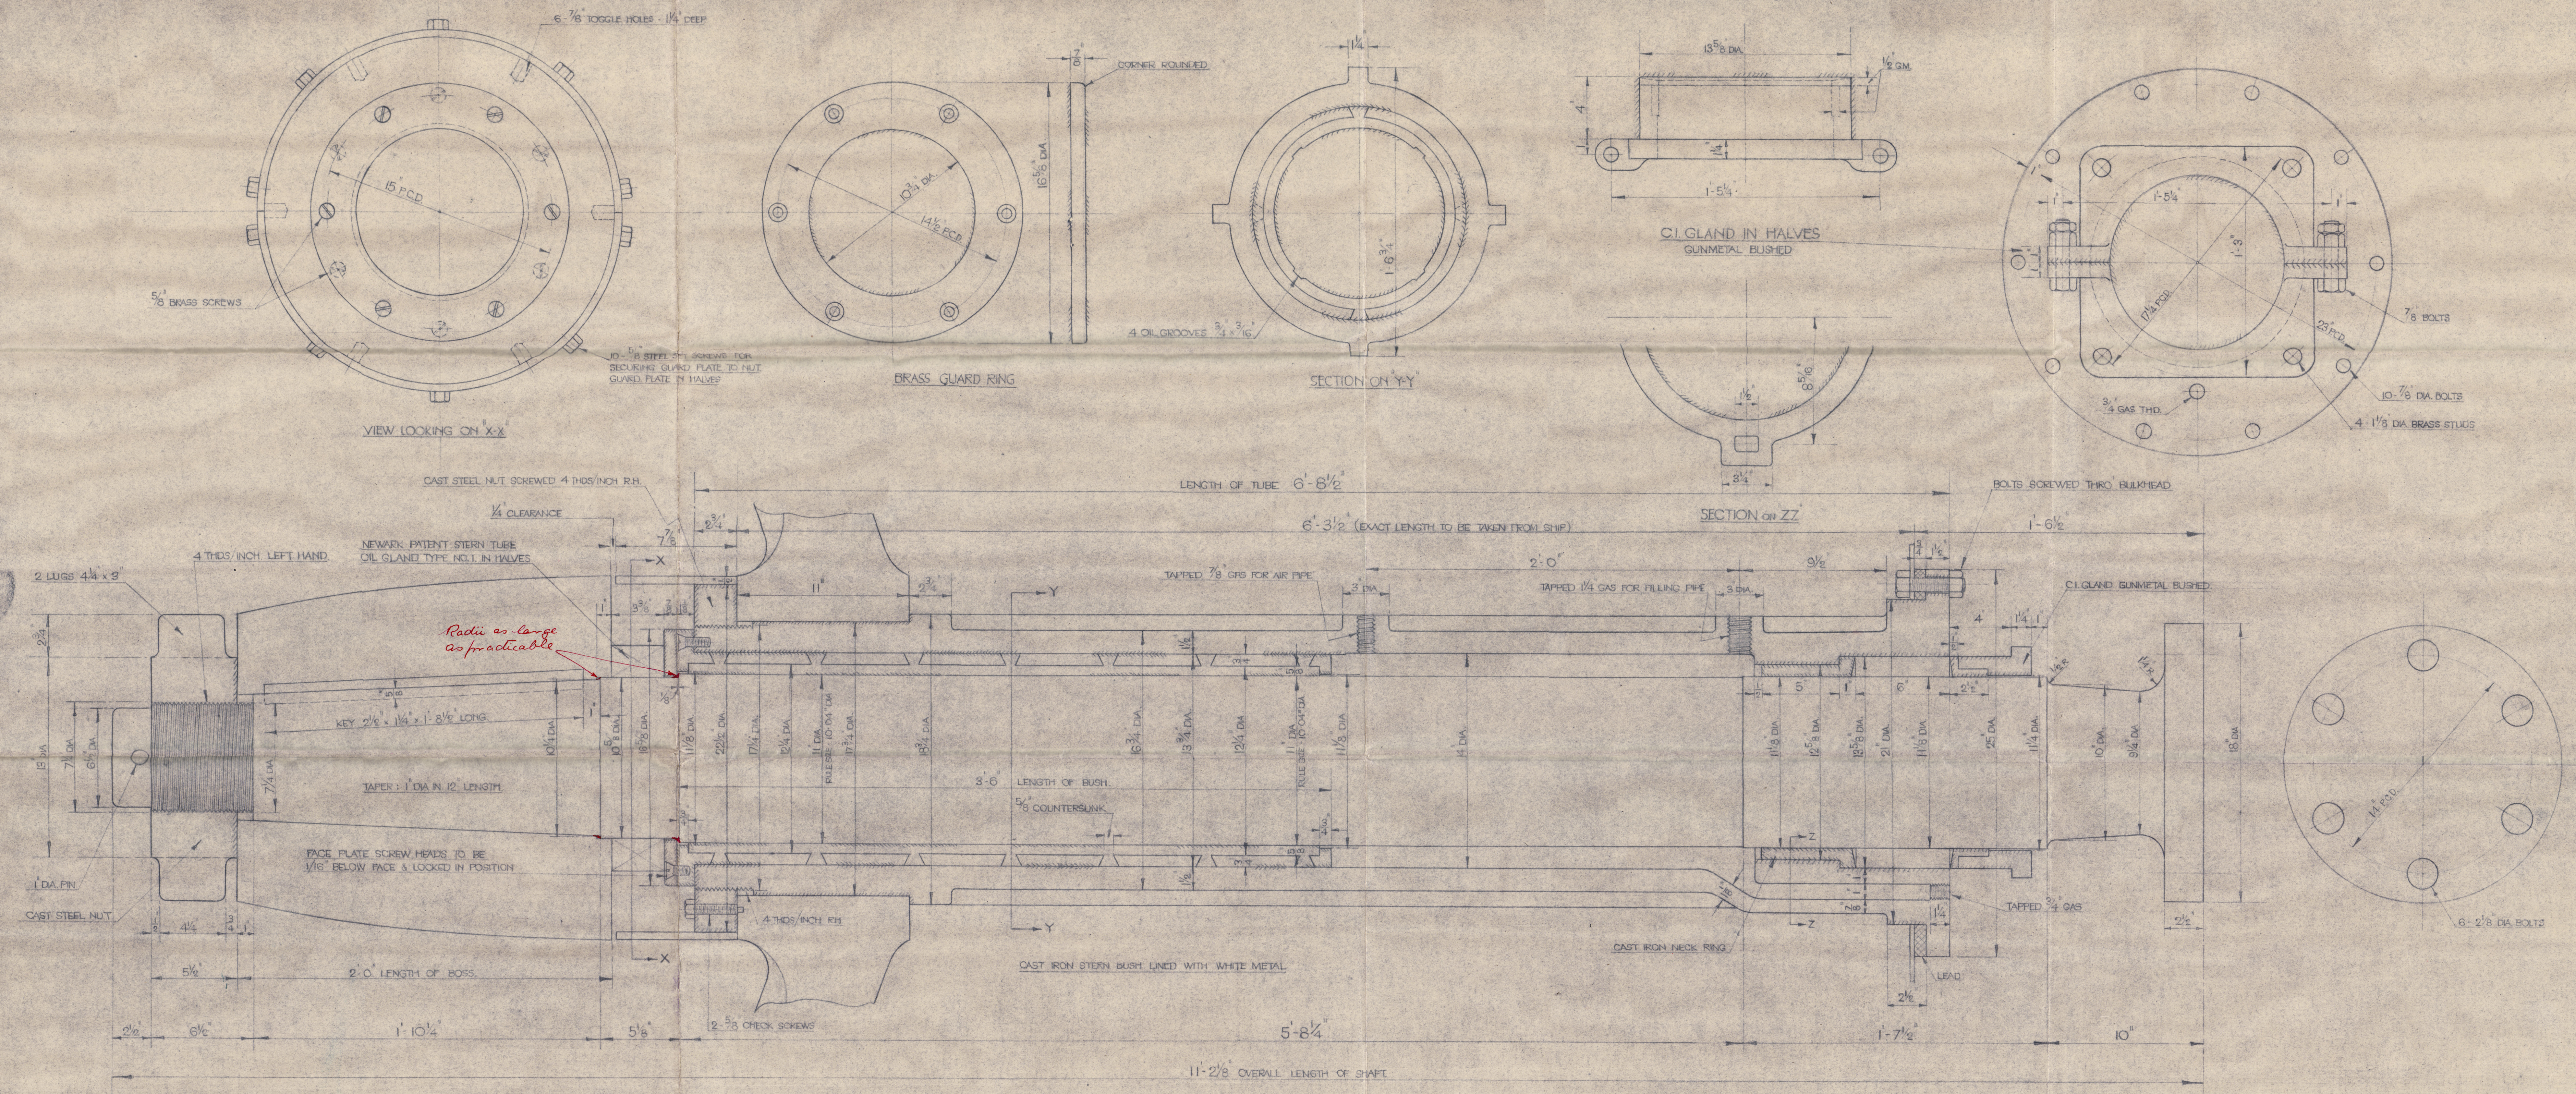

GEM BOX NO. 324  
"EMPIRE HARRY"

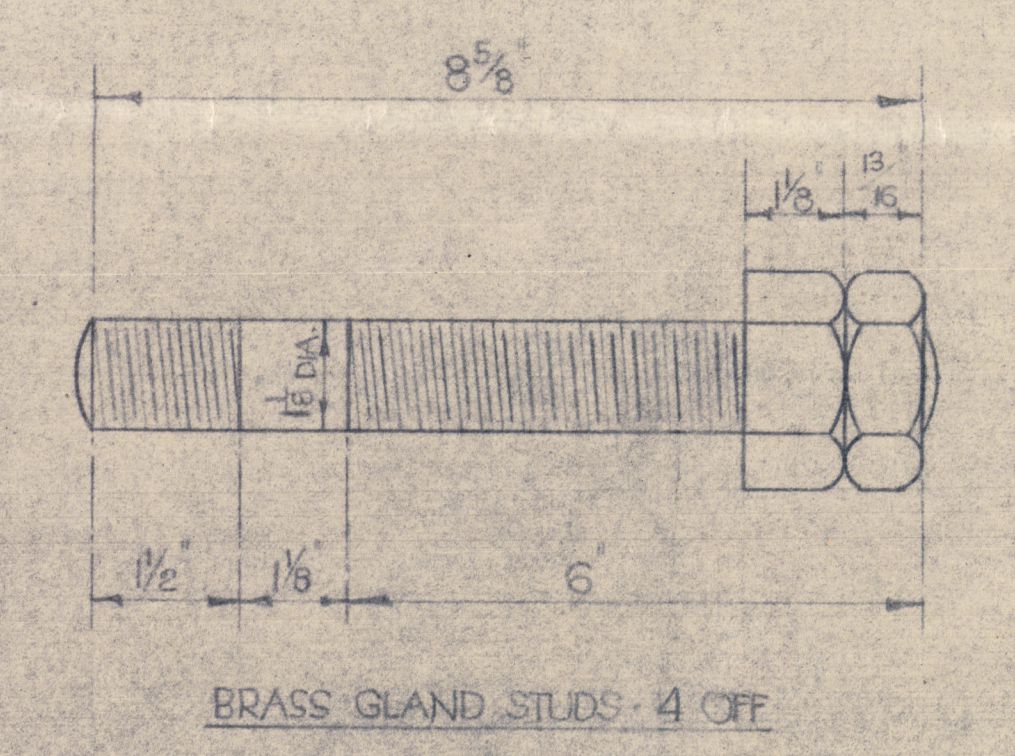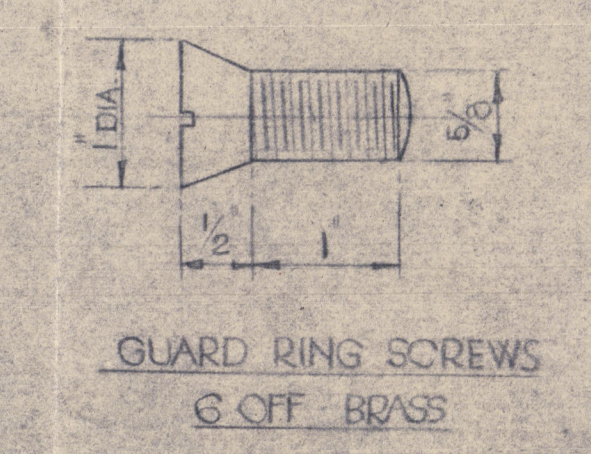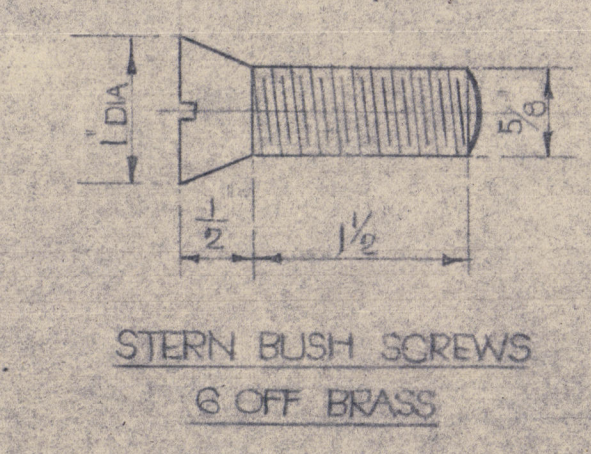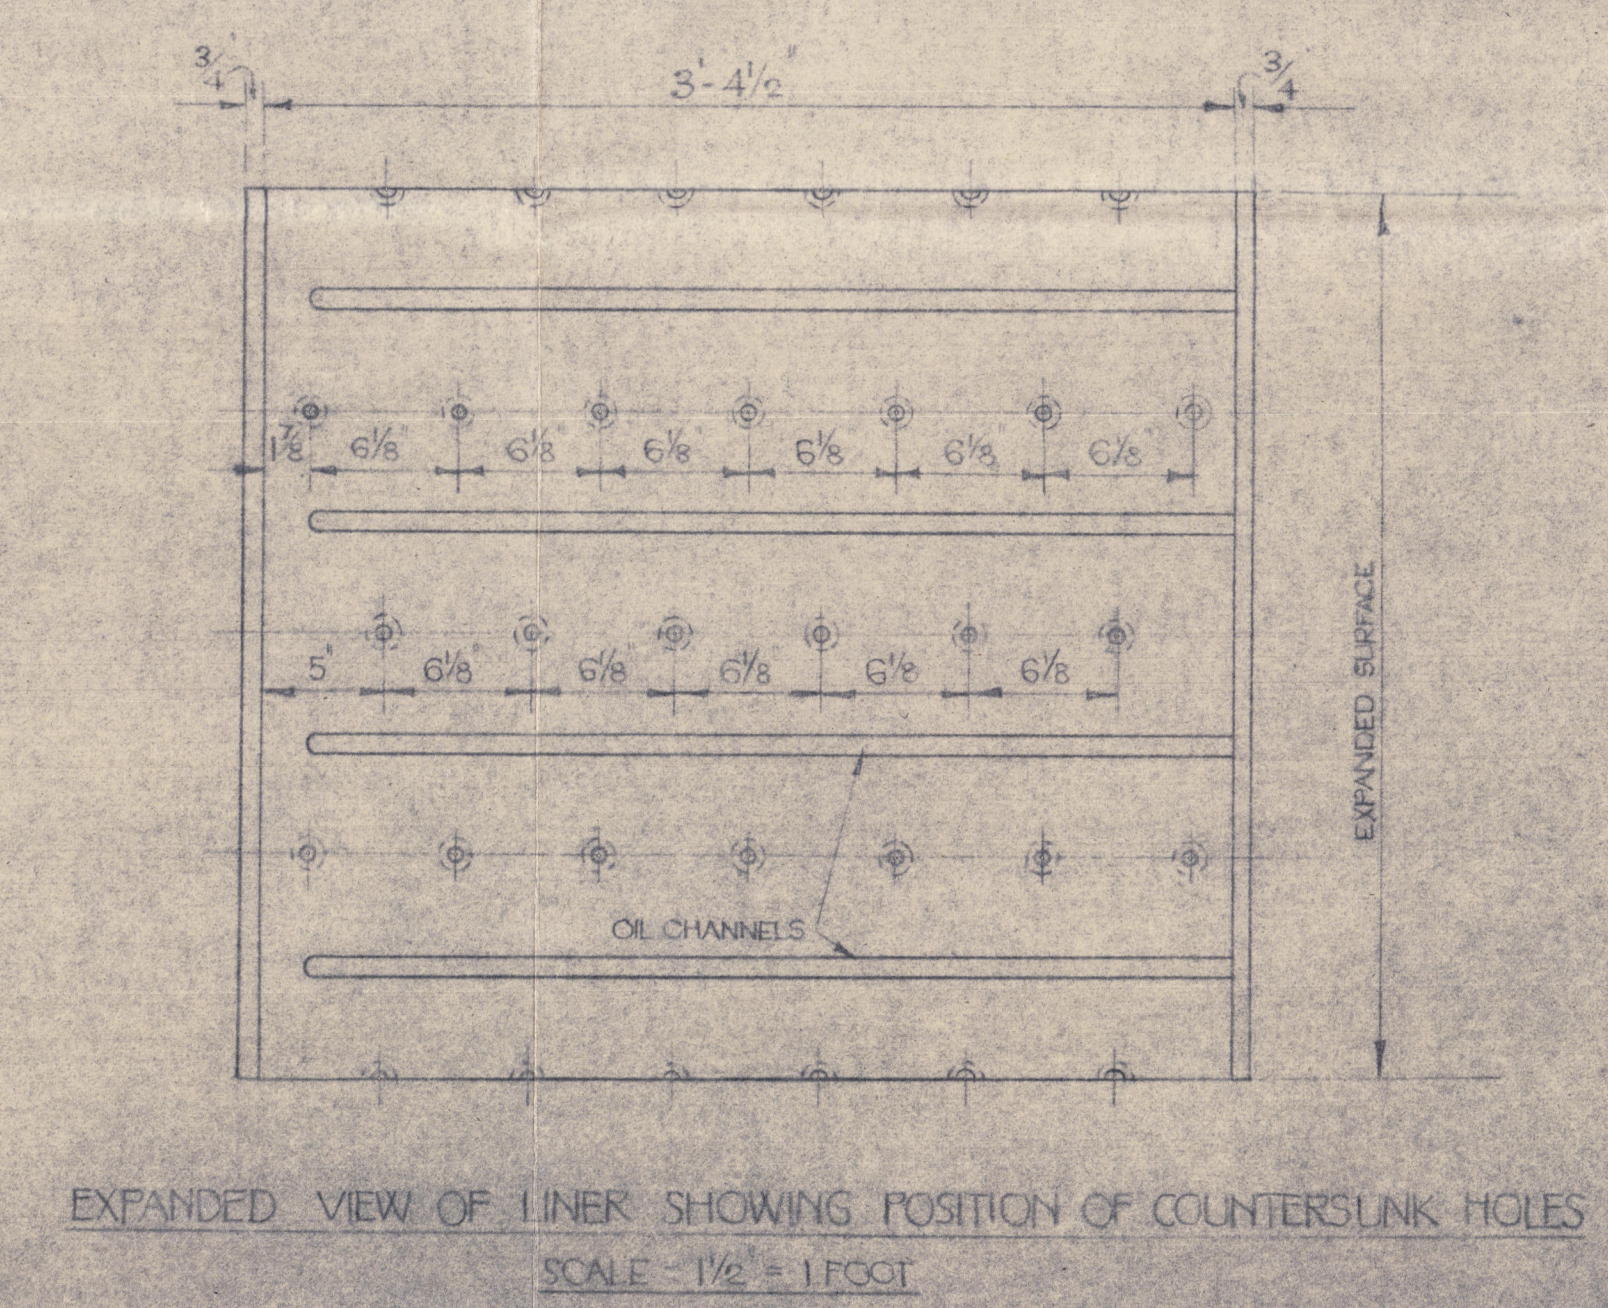

18/12/41  
J.B.H.  
14-1-42